



27 JUN 1981

03 DM03 - 3003
- 265 RL SUMP

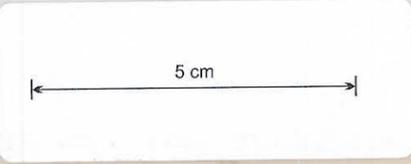

0374_2499

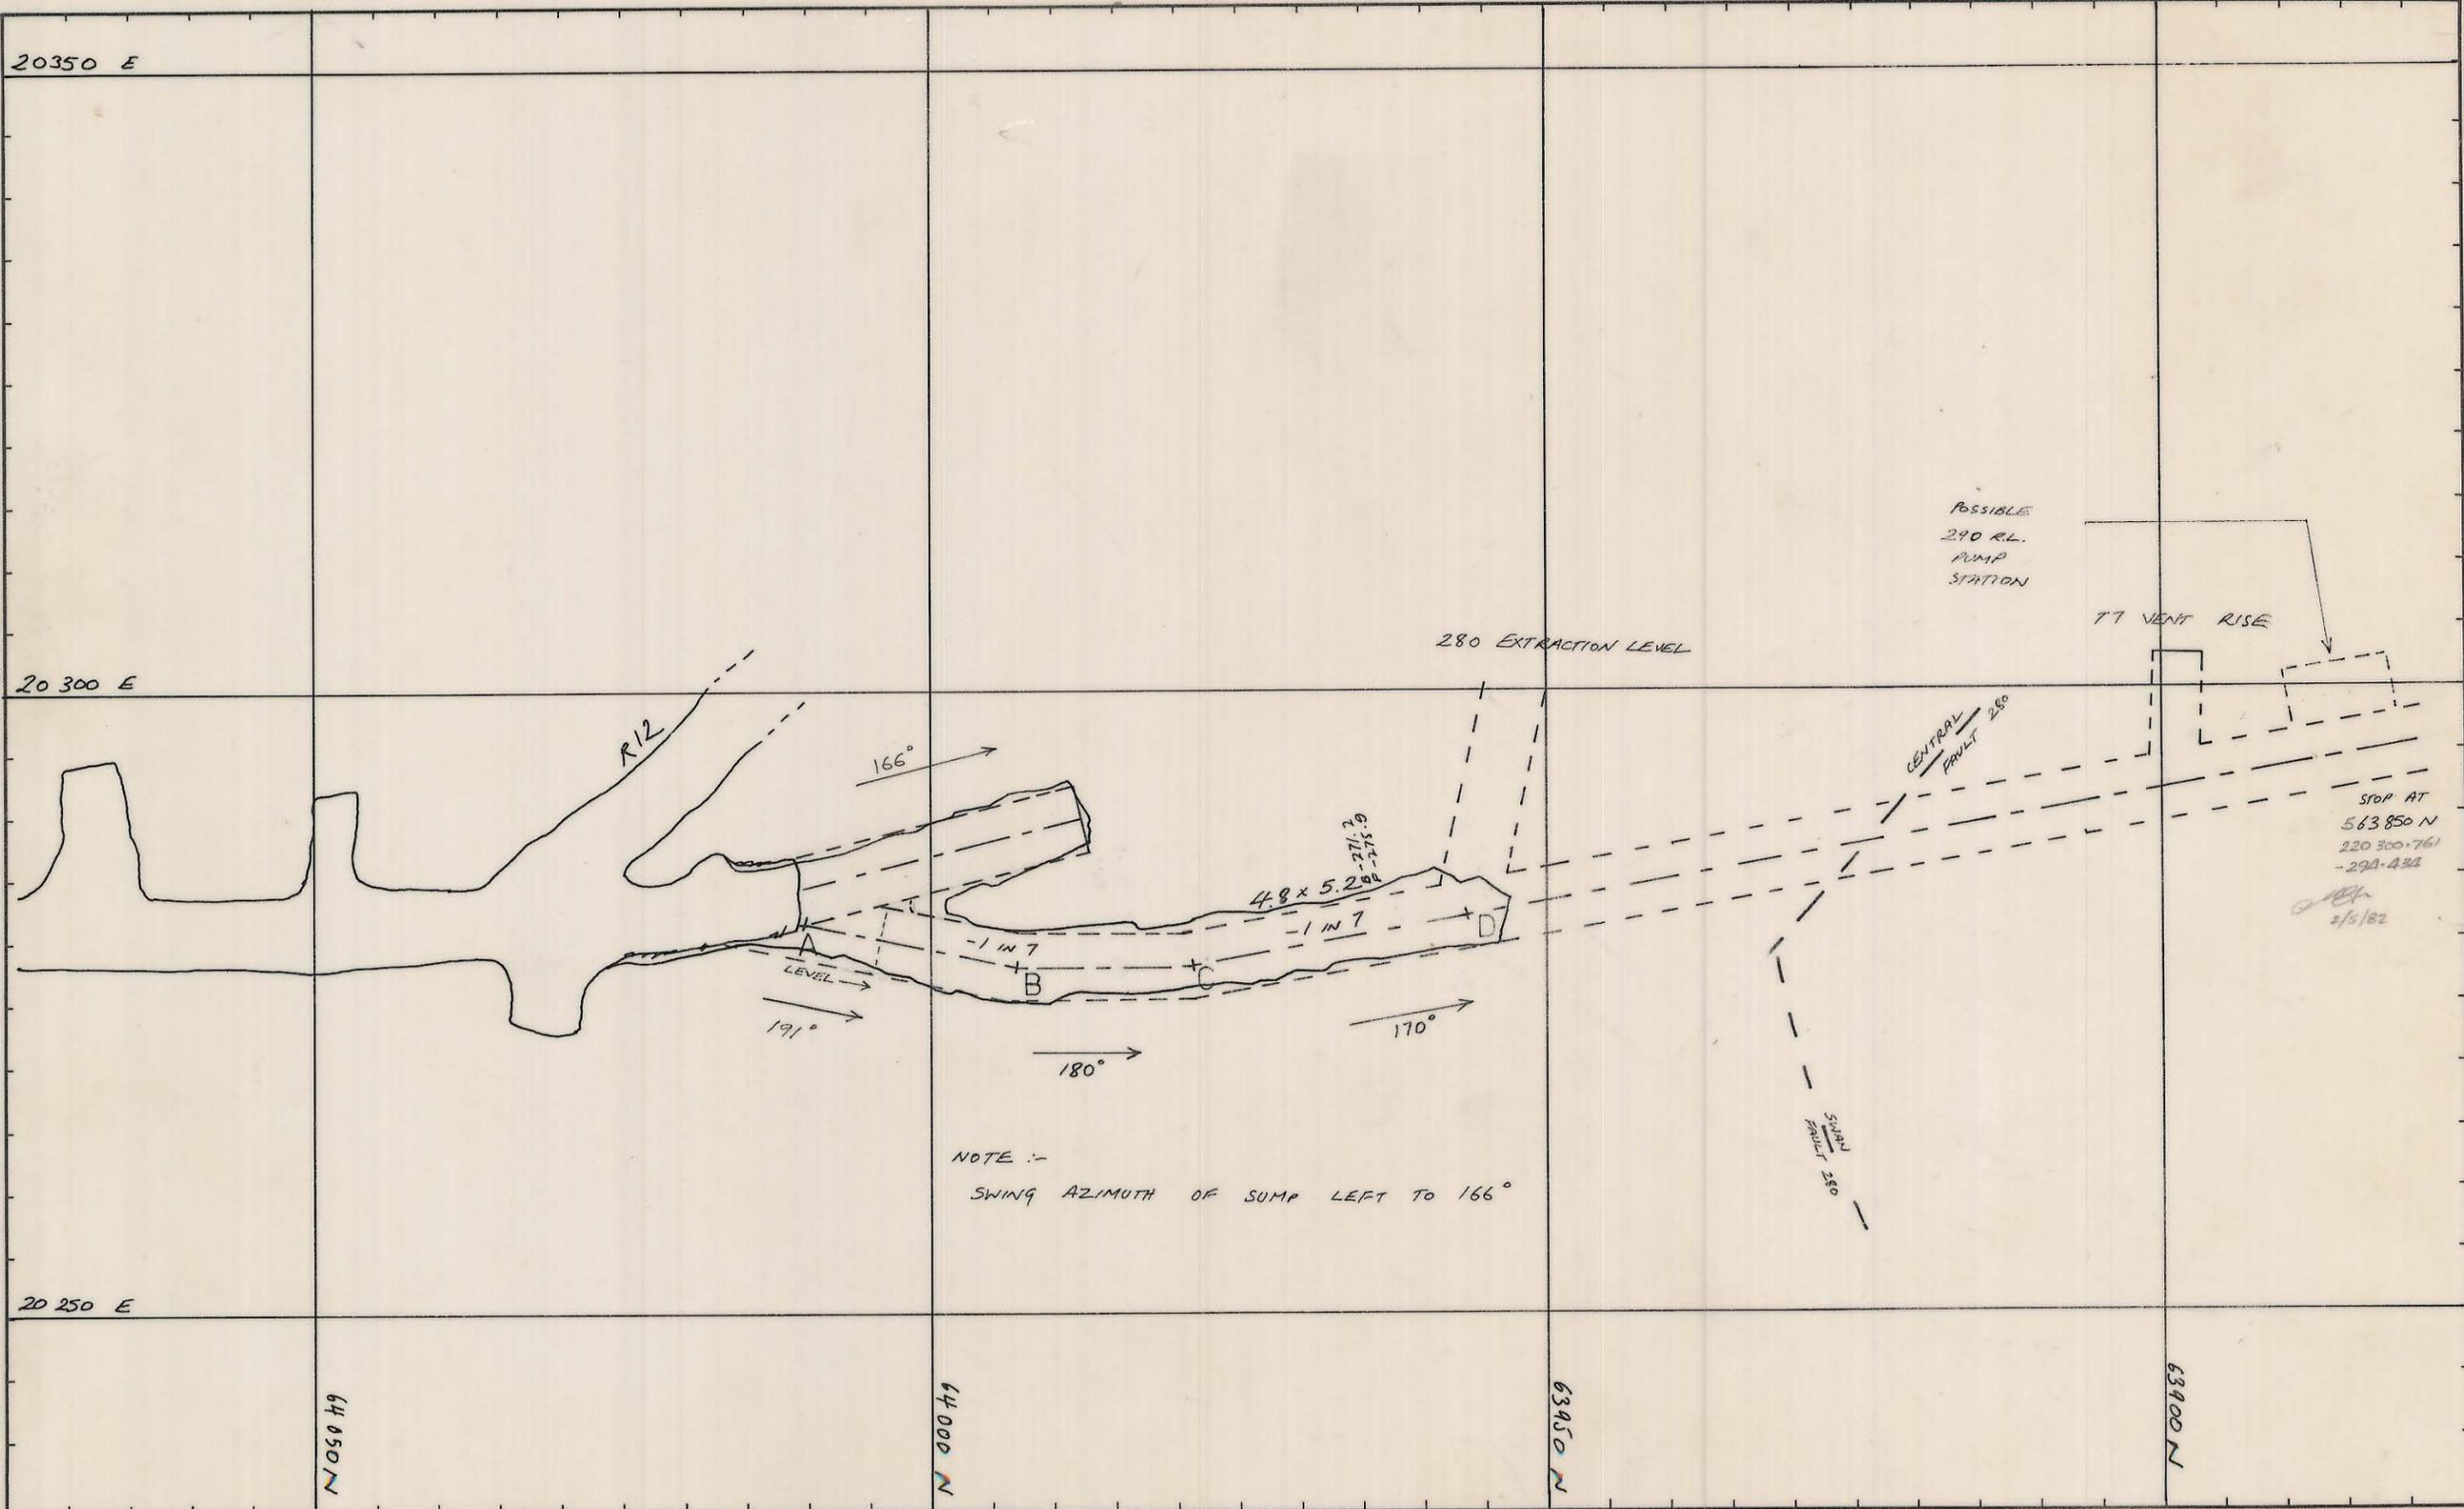

POINT	E	N	R.L.
A	20 281.25	64 010.50	-272 m
B	20 277.75	63 993.20	-273.6
C	20 277.75	63 978.75	-275.6
D	20 282.00	63 956.40	-279.0

REF PLAN	146	GEOLOGY	RES.D.	21-11-80	SCALE 1: 500	<p>DOLPHIN MAIN DECLINE SUMP - 270 R.L.</p>
04 DM 14 1011		SURVEY				
		PLANNING	MR	14 NOV 80		
		ROCK MEC.				
		GRAD CON.		DOL SUMP.		
		DRAFTING				DRAWING NUMBER
		T.S.S.	AGE	21/11/80		03 DM03 - 3003