
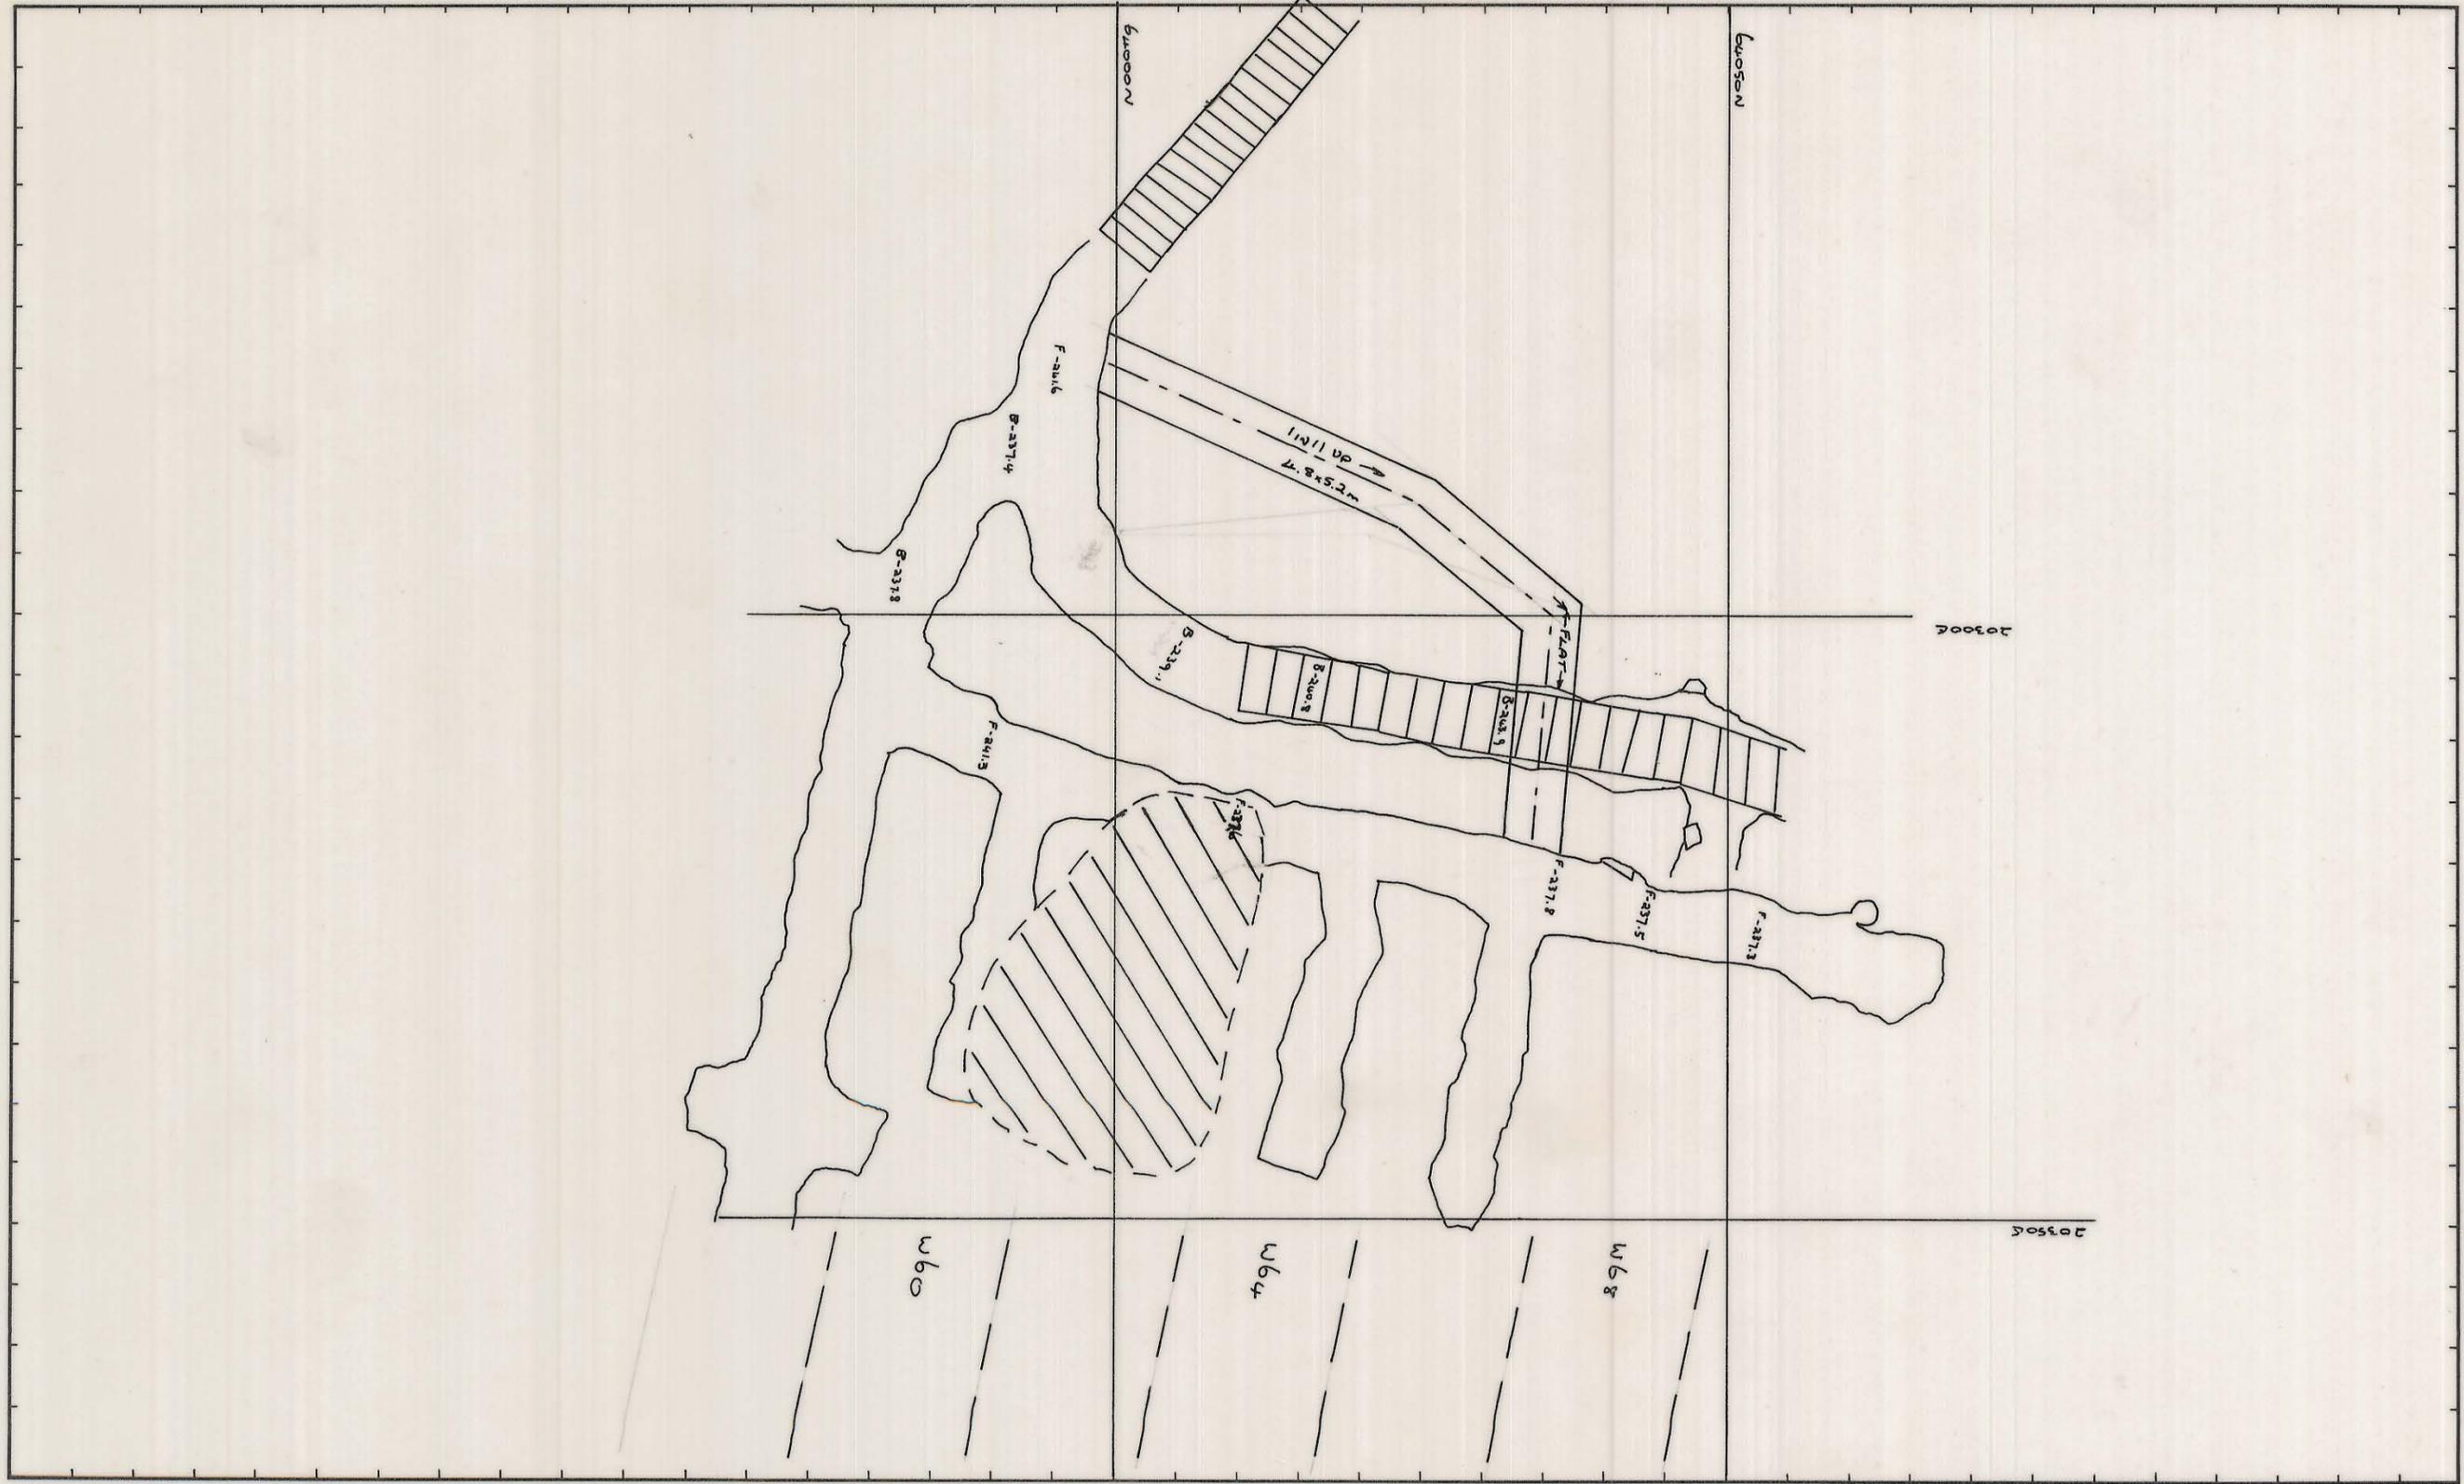


030m03-3006

0374_2502

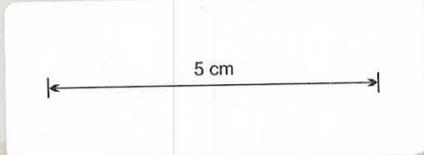

REF PLAN	GEOLOGY		SCALE 1: 500	 KING ISLAND SCHEELITE <small>GRASSY KING ISLAND</small>
	SURVEY		DOLPHIN MINE LOWER WEDGE -240m LEVEL STRIKE DRIVE NEW ACCESS	
PLANNING		DRAWING NUMBER		
ROCK MEC.		030m03-3006		
GRADE CON.				
DRAFTING				
T.S.S.	ag	11/3/03		