
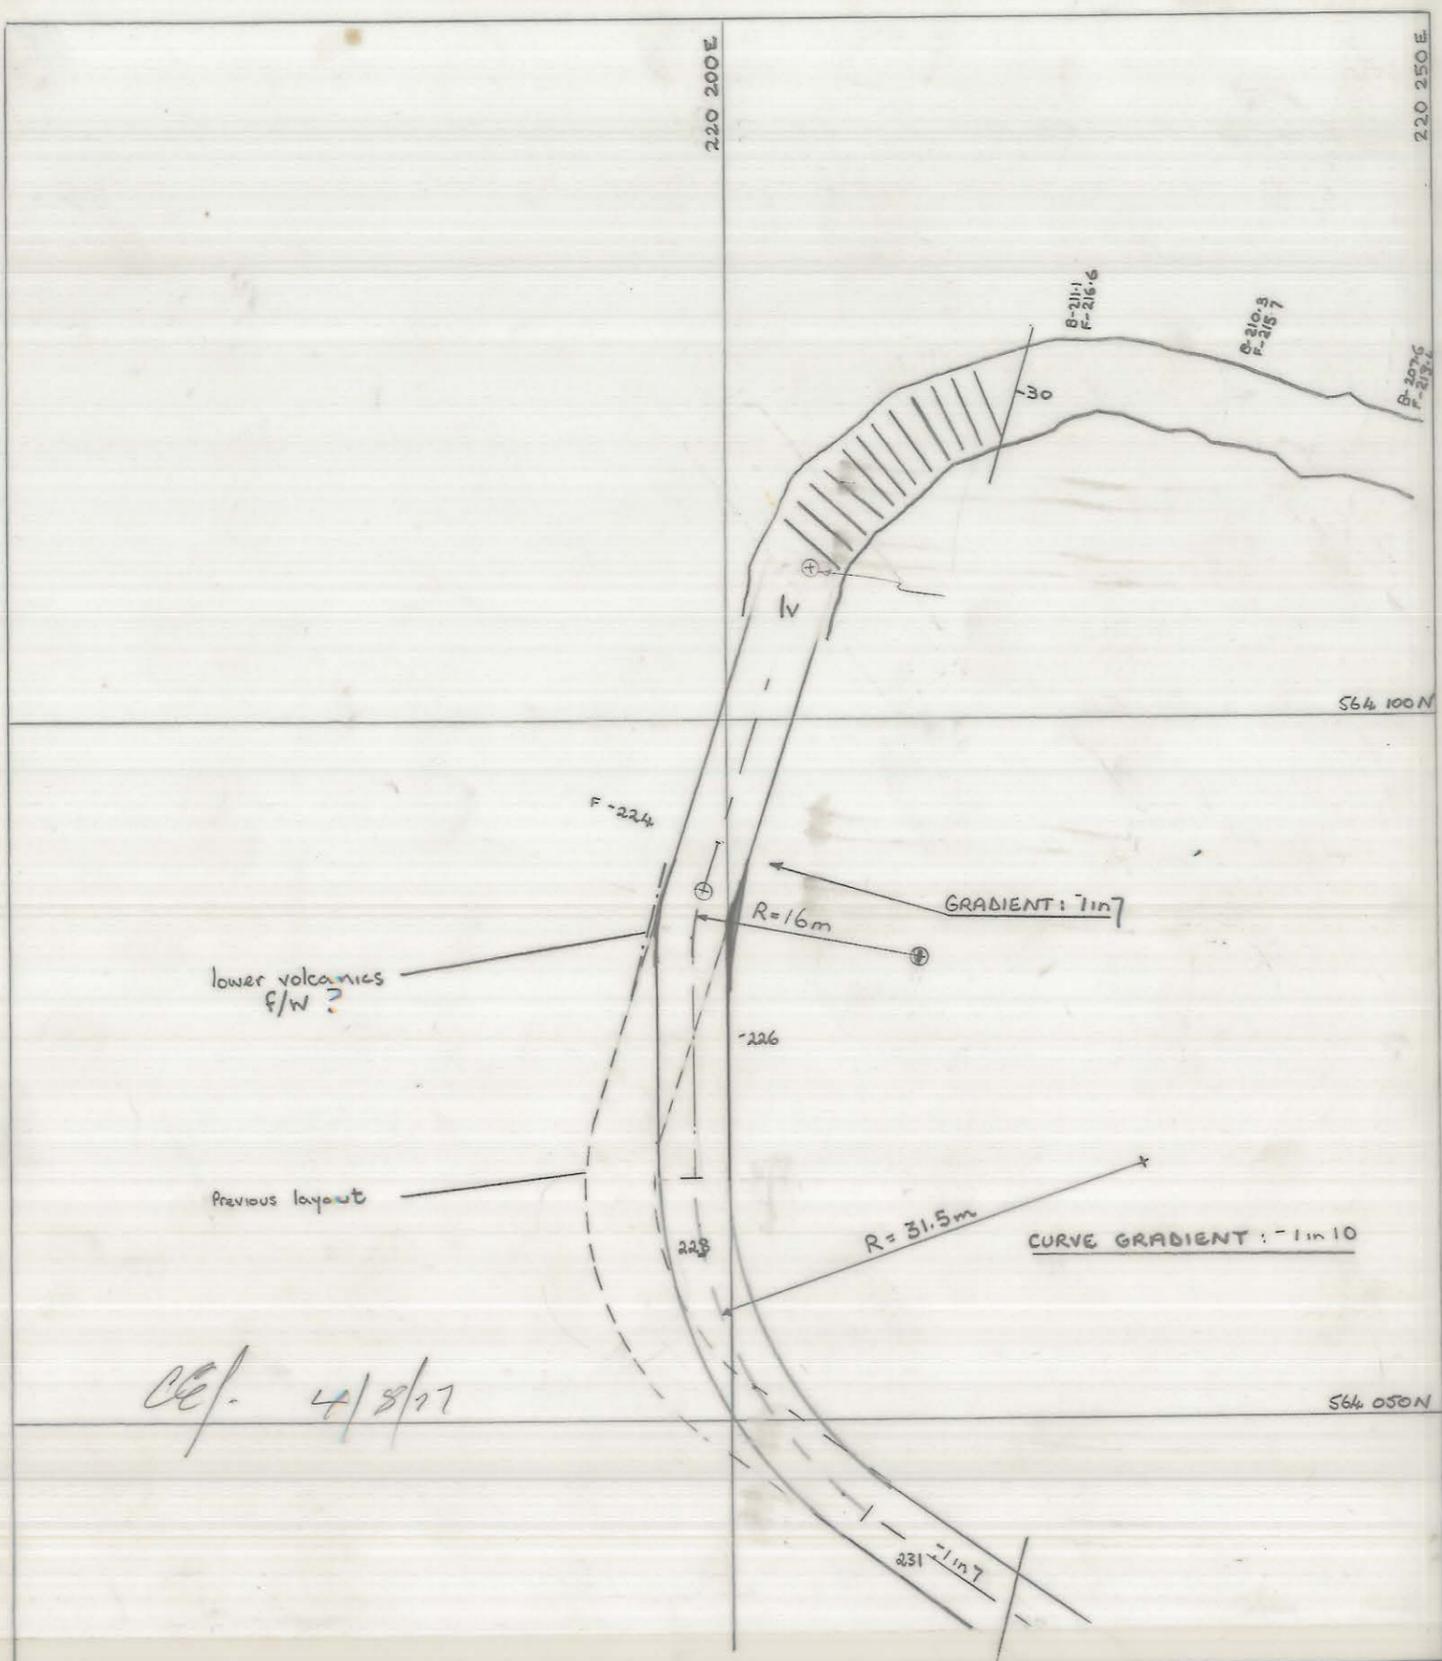


27 JUN 1981

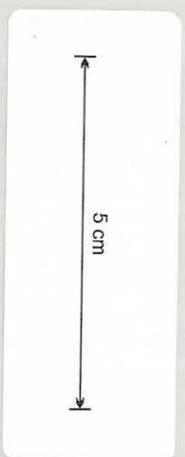

KING ISLAND SCHEELITE		APPROVAL	COPY
DATE: 4 AUGUST 1977 SCALE: 1:500		PLANNING ENG.: <i>[Signature]</i>	
MINE: DOLPHIN MINE DWG/NO.: 03 DM 03-4002		SENIOR PLAN. ENG.:	
PROPOSED LAYOUT FOR:  <u>ALTERATION TO DECLINE</u> TO AVOID VOLCANIC F/W CONTACT		MINE SUPT.:	
		G. MINING SUPT.:	
		SENIOR SURV'R.:	
		SENIOR GEOLOGIST:	
		SURVEYOR:	
PRELIMINARY	FINAL		

03 DM 03 - 4002

0374\_2504