


27 JUN 1981

5 cm

0374_2505

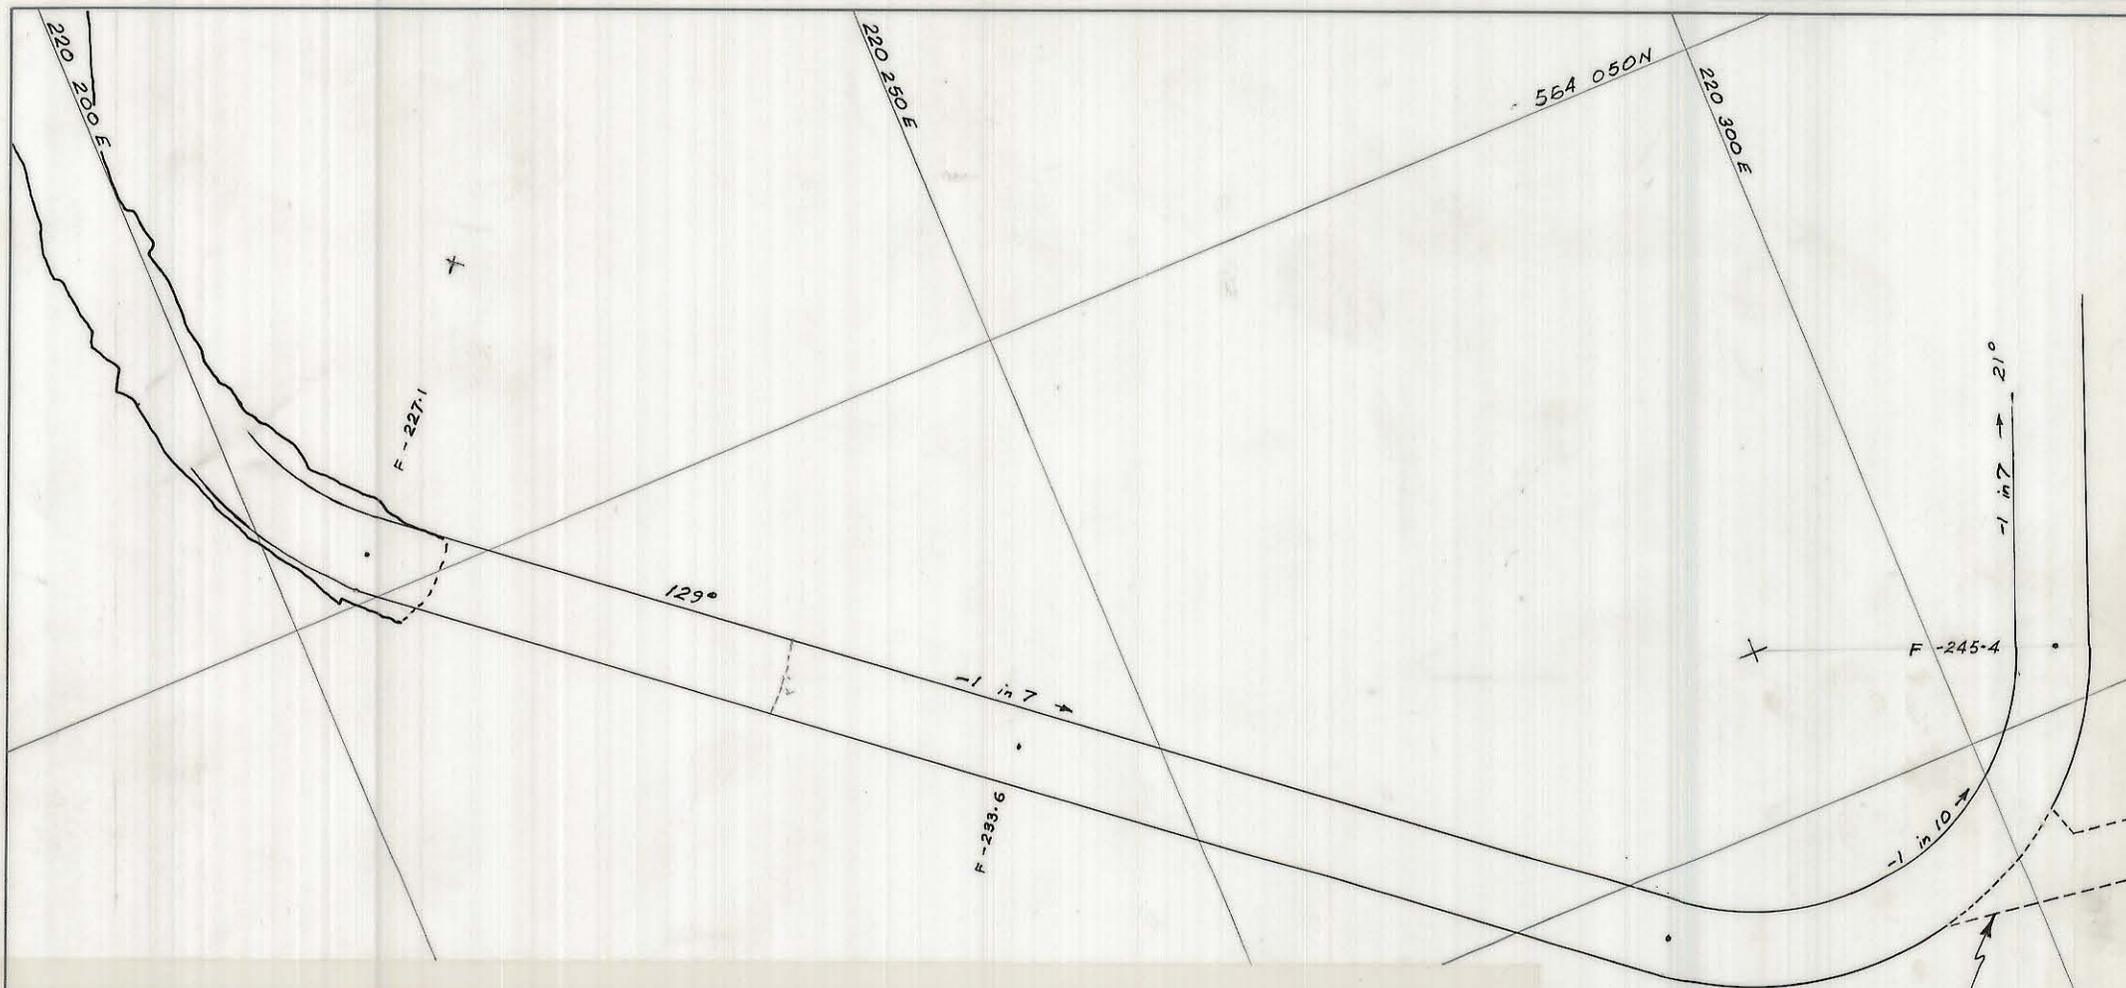

Probable position of XC to
-250 Lev. diamond drill drive.