


5 cm

0374\_2508

03DM03-3005

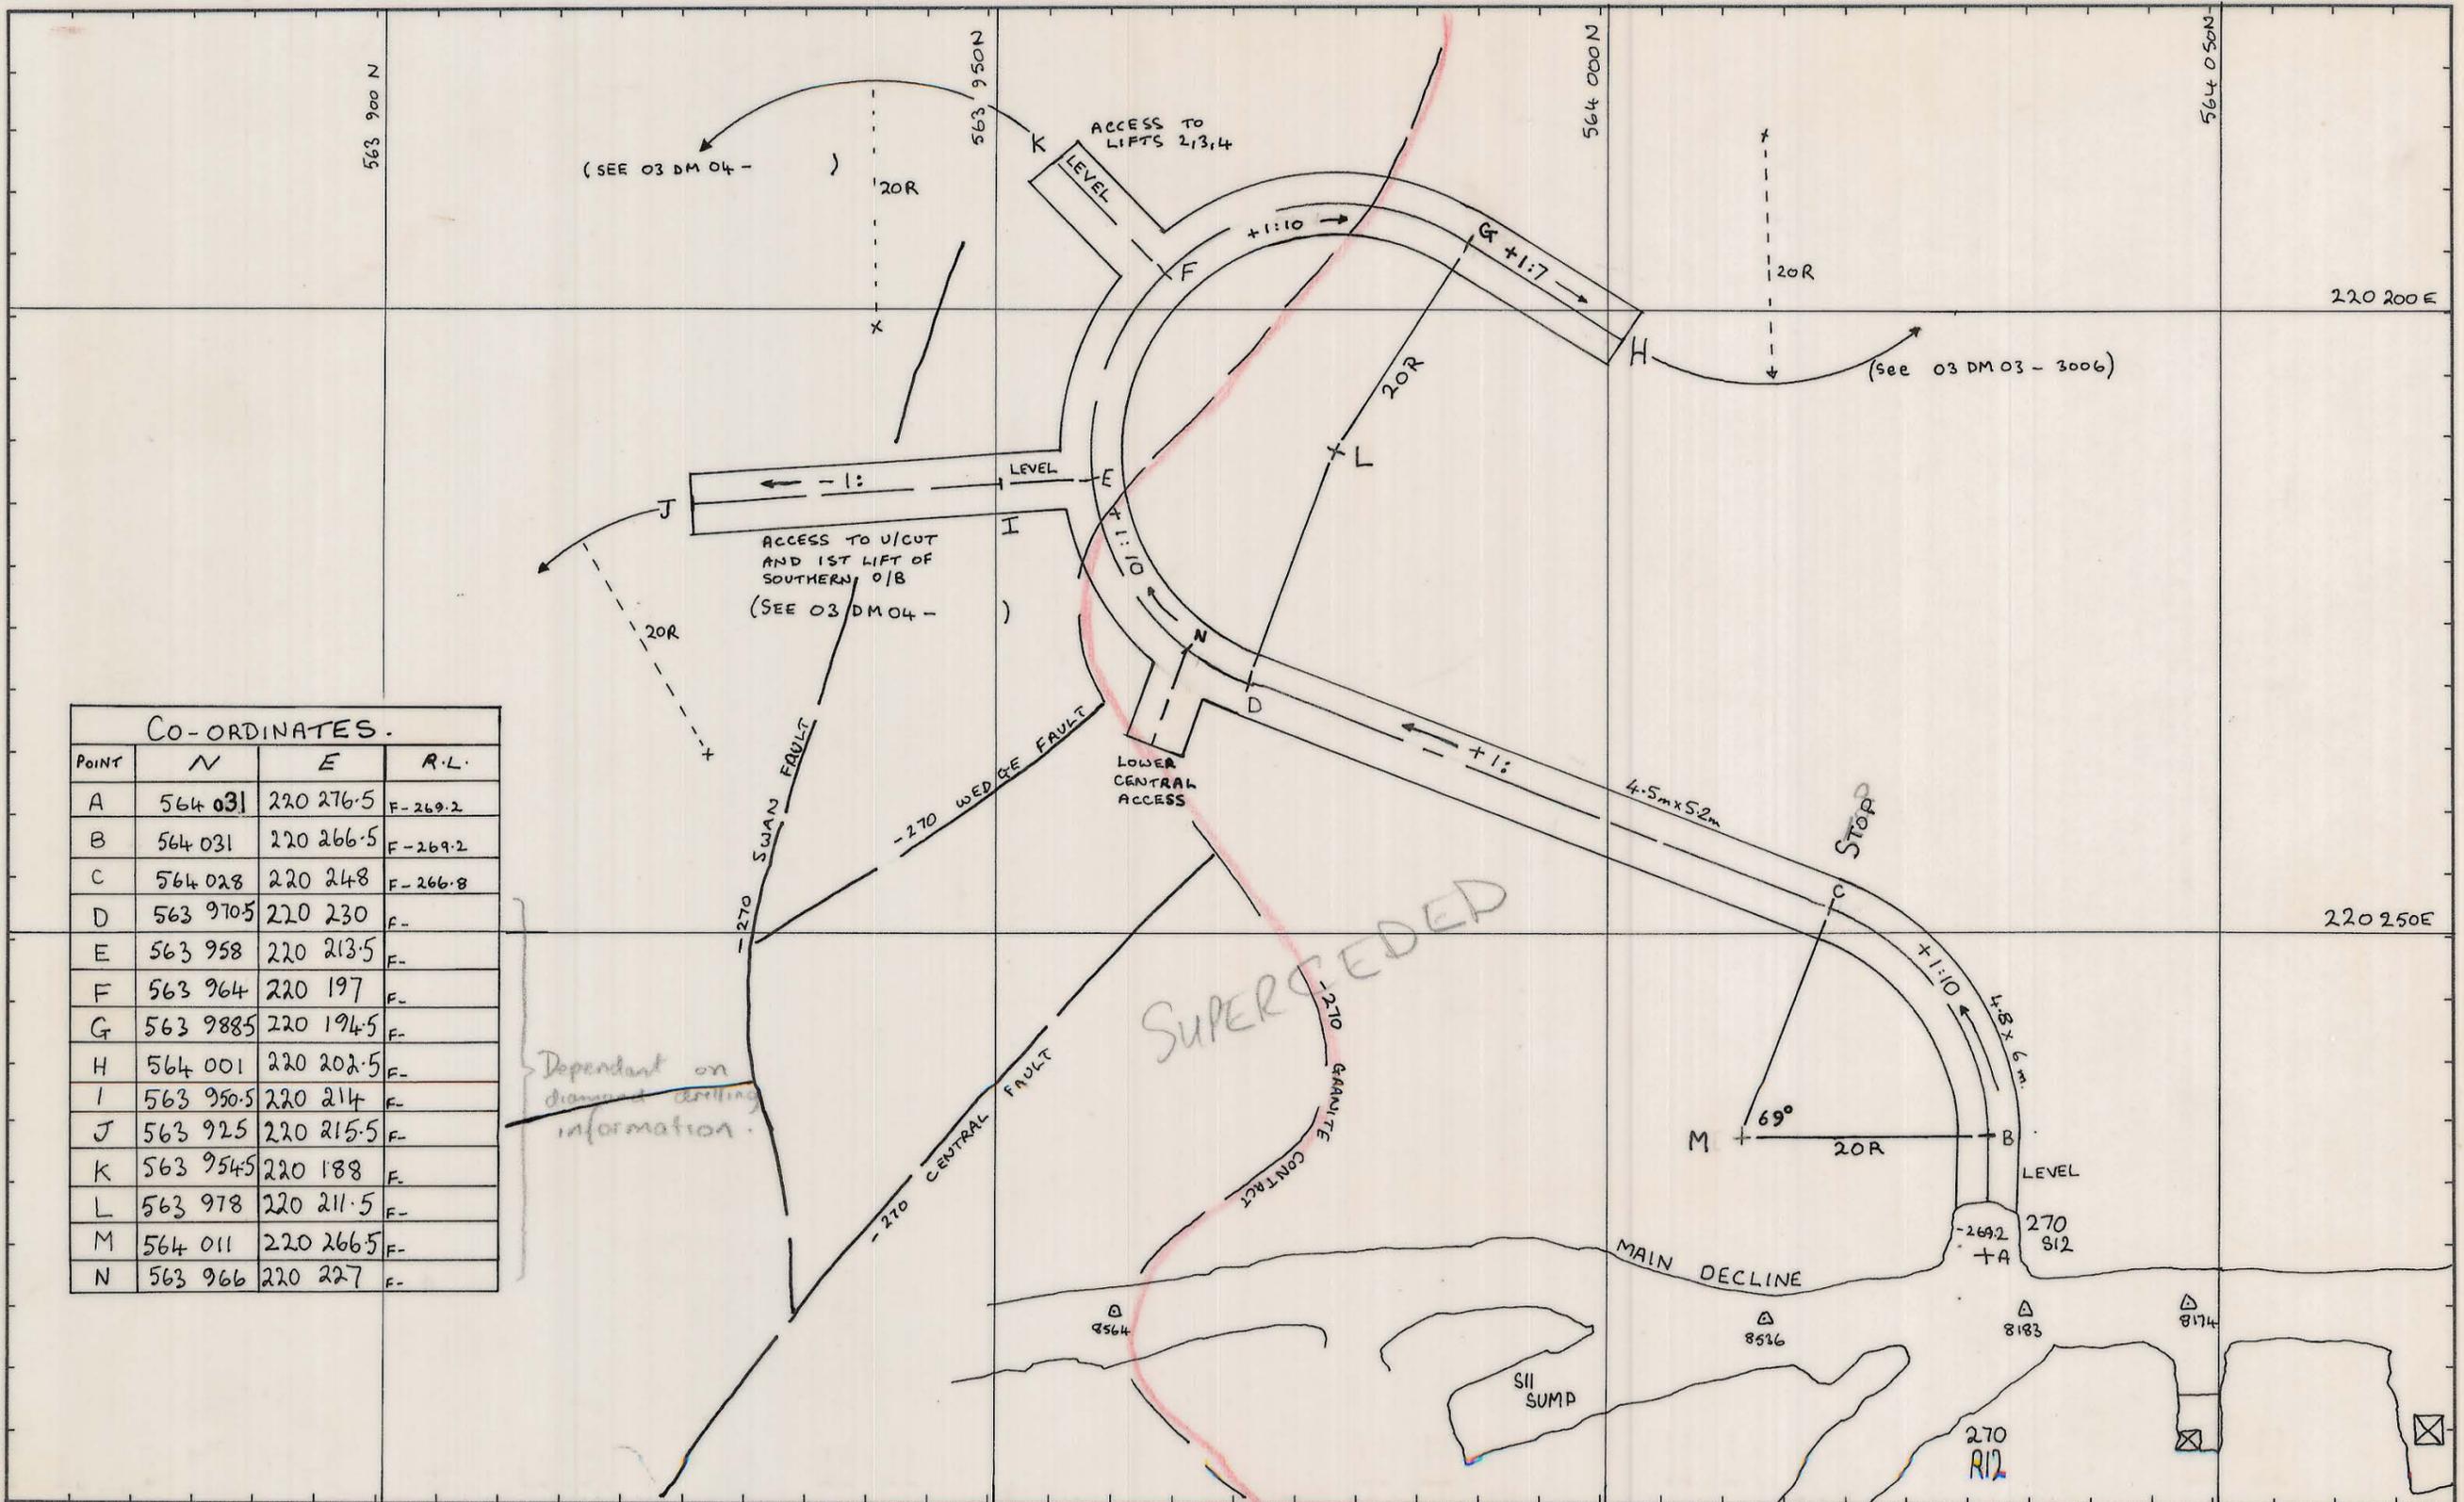

CO-ORDINATES.

POINT	N	E	R.L.
A	564 031	220 276.5	F-269.2
B	564 031	220 266.5	F-269.2
C	564 028	220 248	F-266.8
D	563 970.5	220 230	F-
E	563 958	220 213.5	F-
F	563 964	220 197	F-
G	563 988.5	220 194.5	F-
H	564 001	220 202.5	F-
I	563 950.5	220 214	F-
J	563 925	220 215.5	F-
K	563 954.5	220 188	F-
L	563 978	220 211.5	F-
M	564 011	220 266.5	F-
N	563 966	220 227	F-

SUPERSEDED

REF PLAN 04 DM 14 - 1130

GEOLOGY	L.S.B.	16-10-81
SURVEY		
PLANNING	A.D.F.	15-10-81
ROCK MEC.		20-10-81
MINE SUPT.		
G.M.S.		9/12/87
T.S.S.		22/10/81
MINE SUPT.		

SCALE 1:500	KIS KING ISLAND SCHEELITE GRASSY KING ISLAND
SOUTHERN DECLINE PRELIMINARY DEVELOPEMENT FROM 270 S12.	
DRAWING NUMBER	03 DM 03 - 3005