


0274-2S2

04BH15-102-99

5 cm

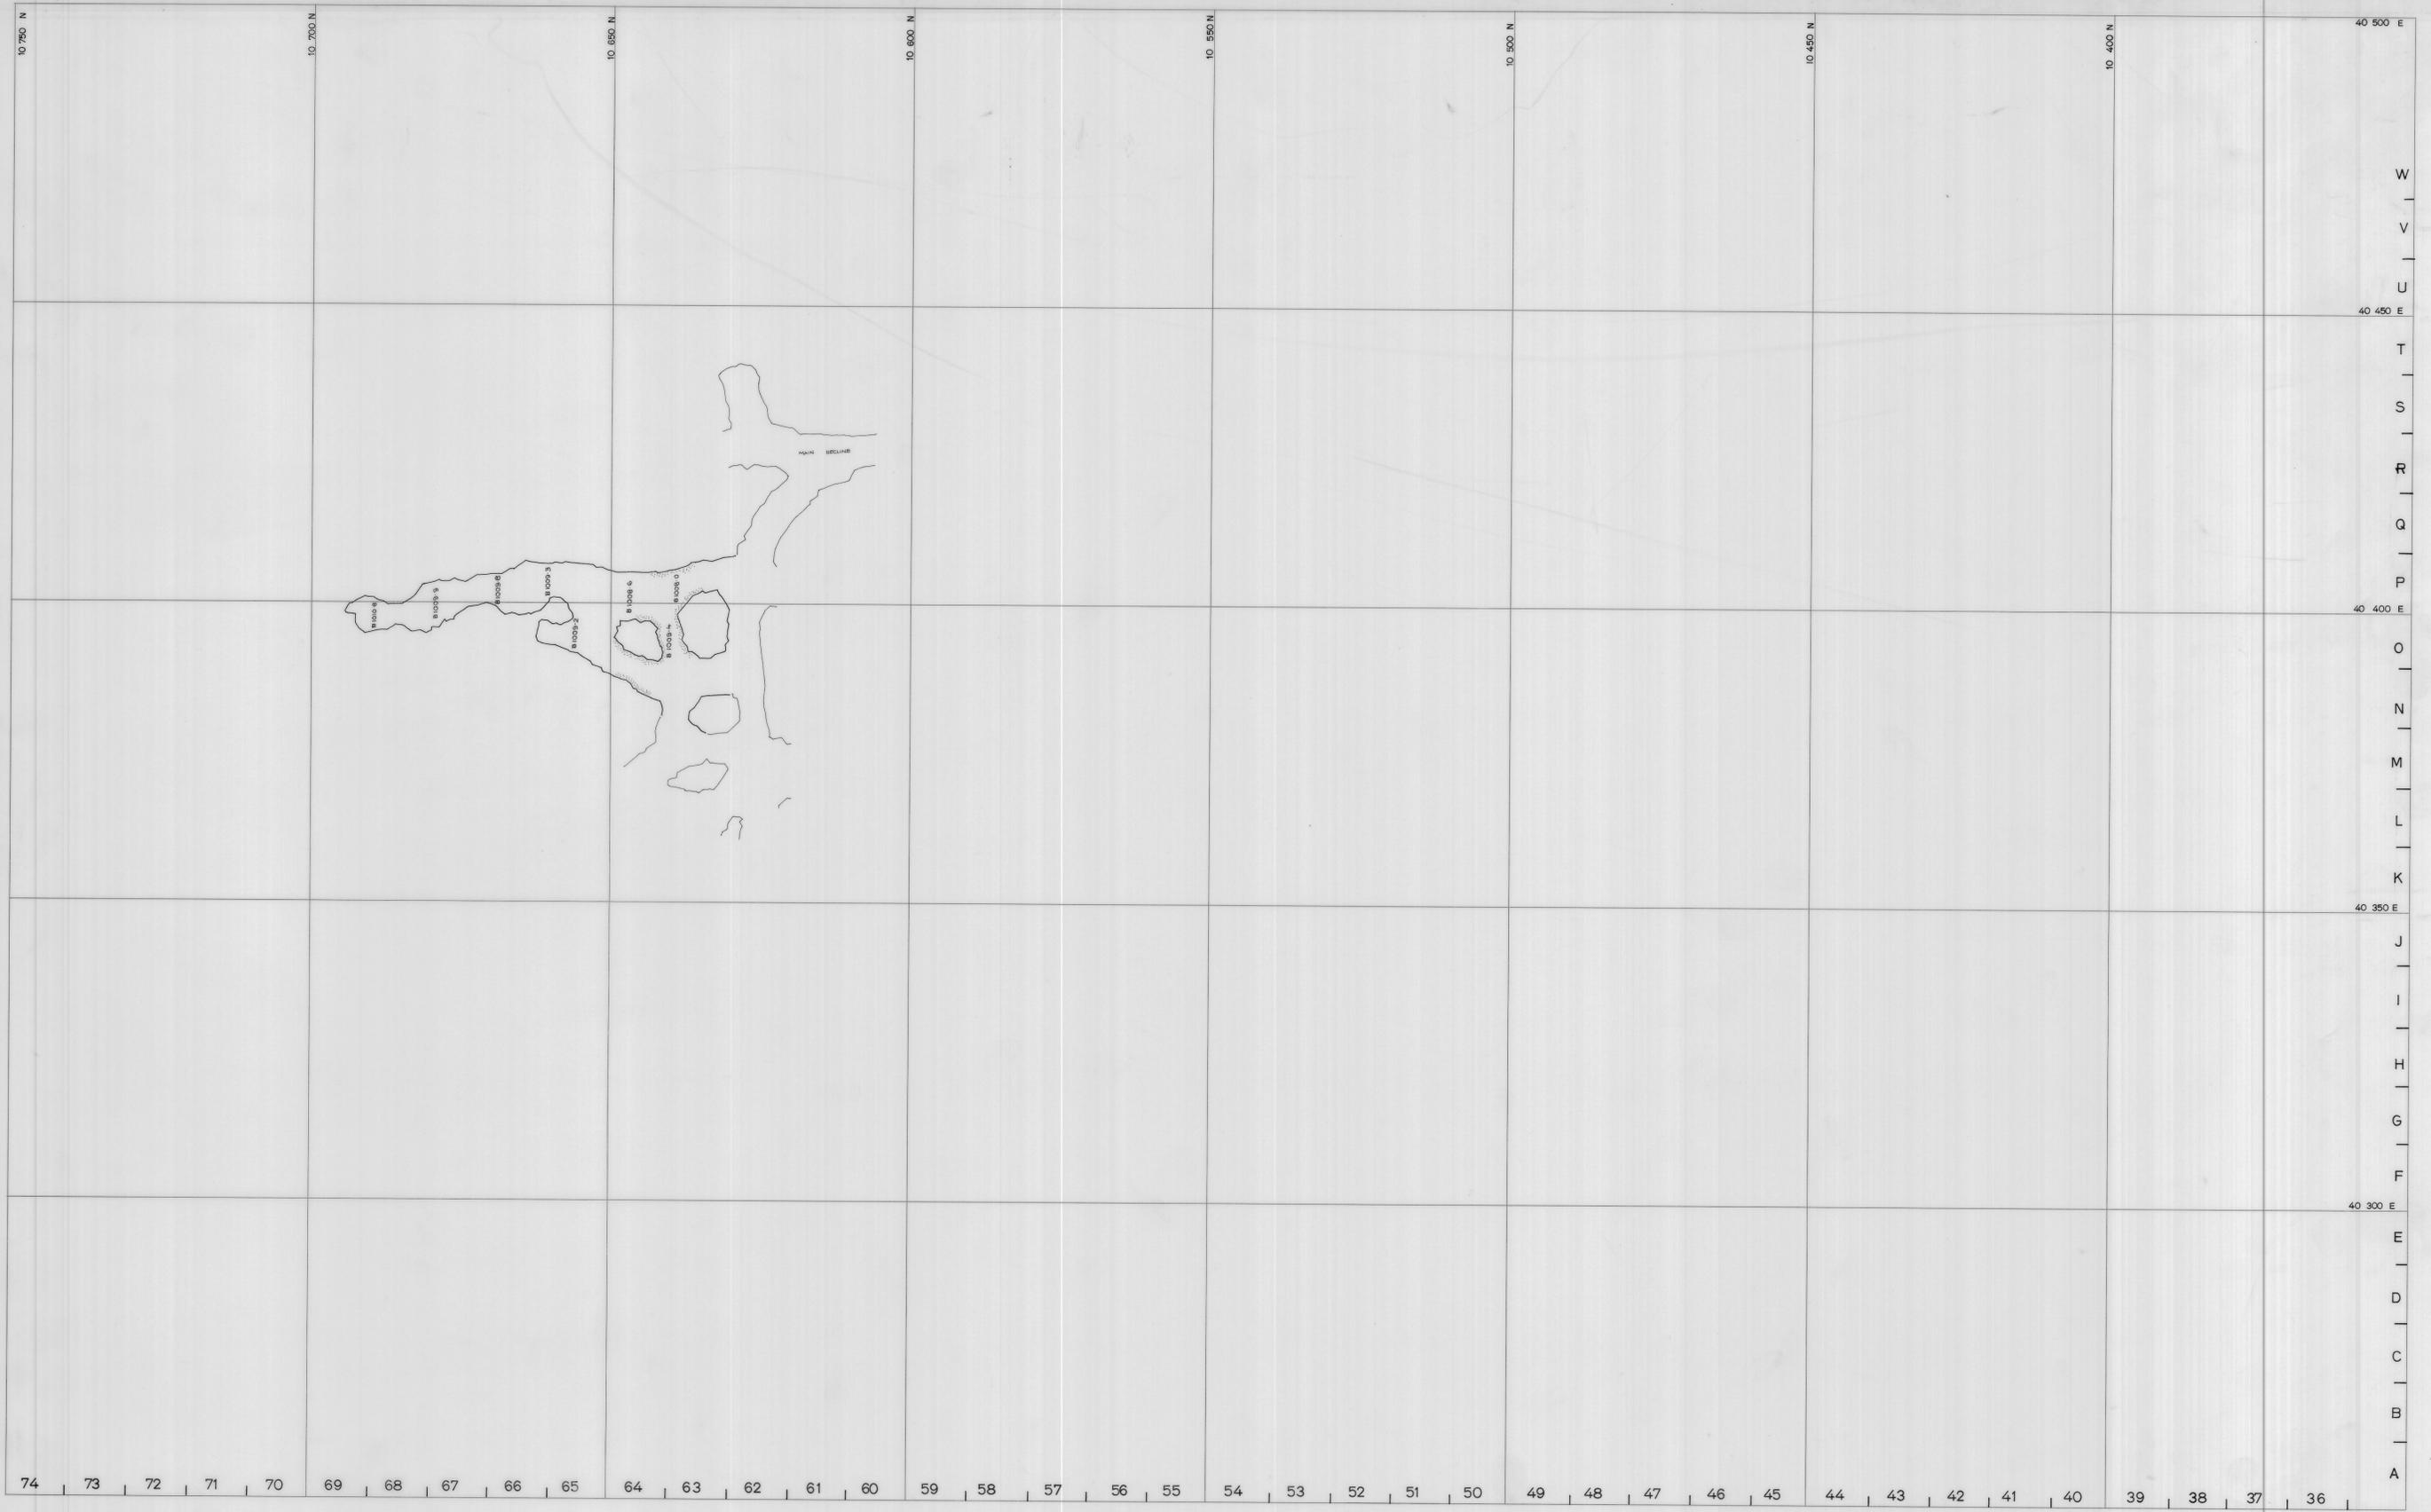

SCALE 1 500	LOCATION BOLD HEAD MINE	
	SUBJECT P62 STOPE ([1st Lift])	
SEE PLAN FOR UNDERCUT	north	