


Layout Only

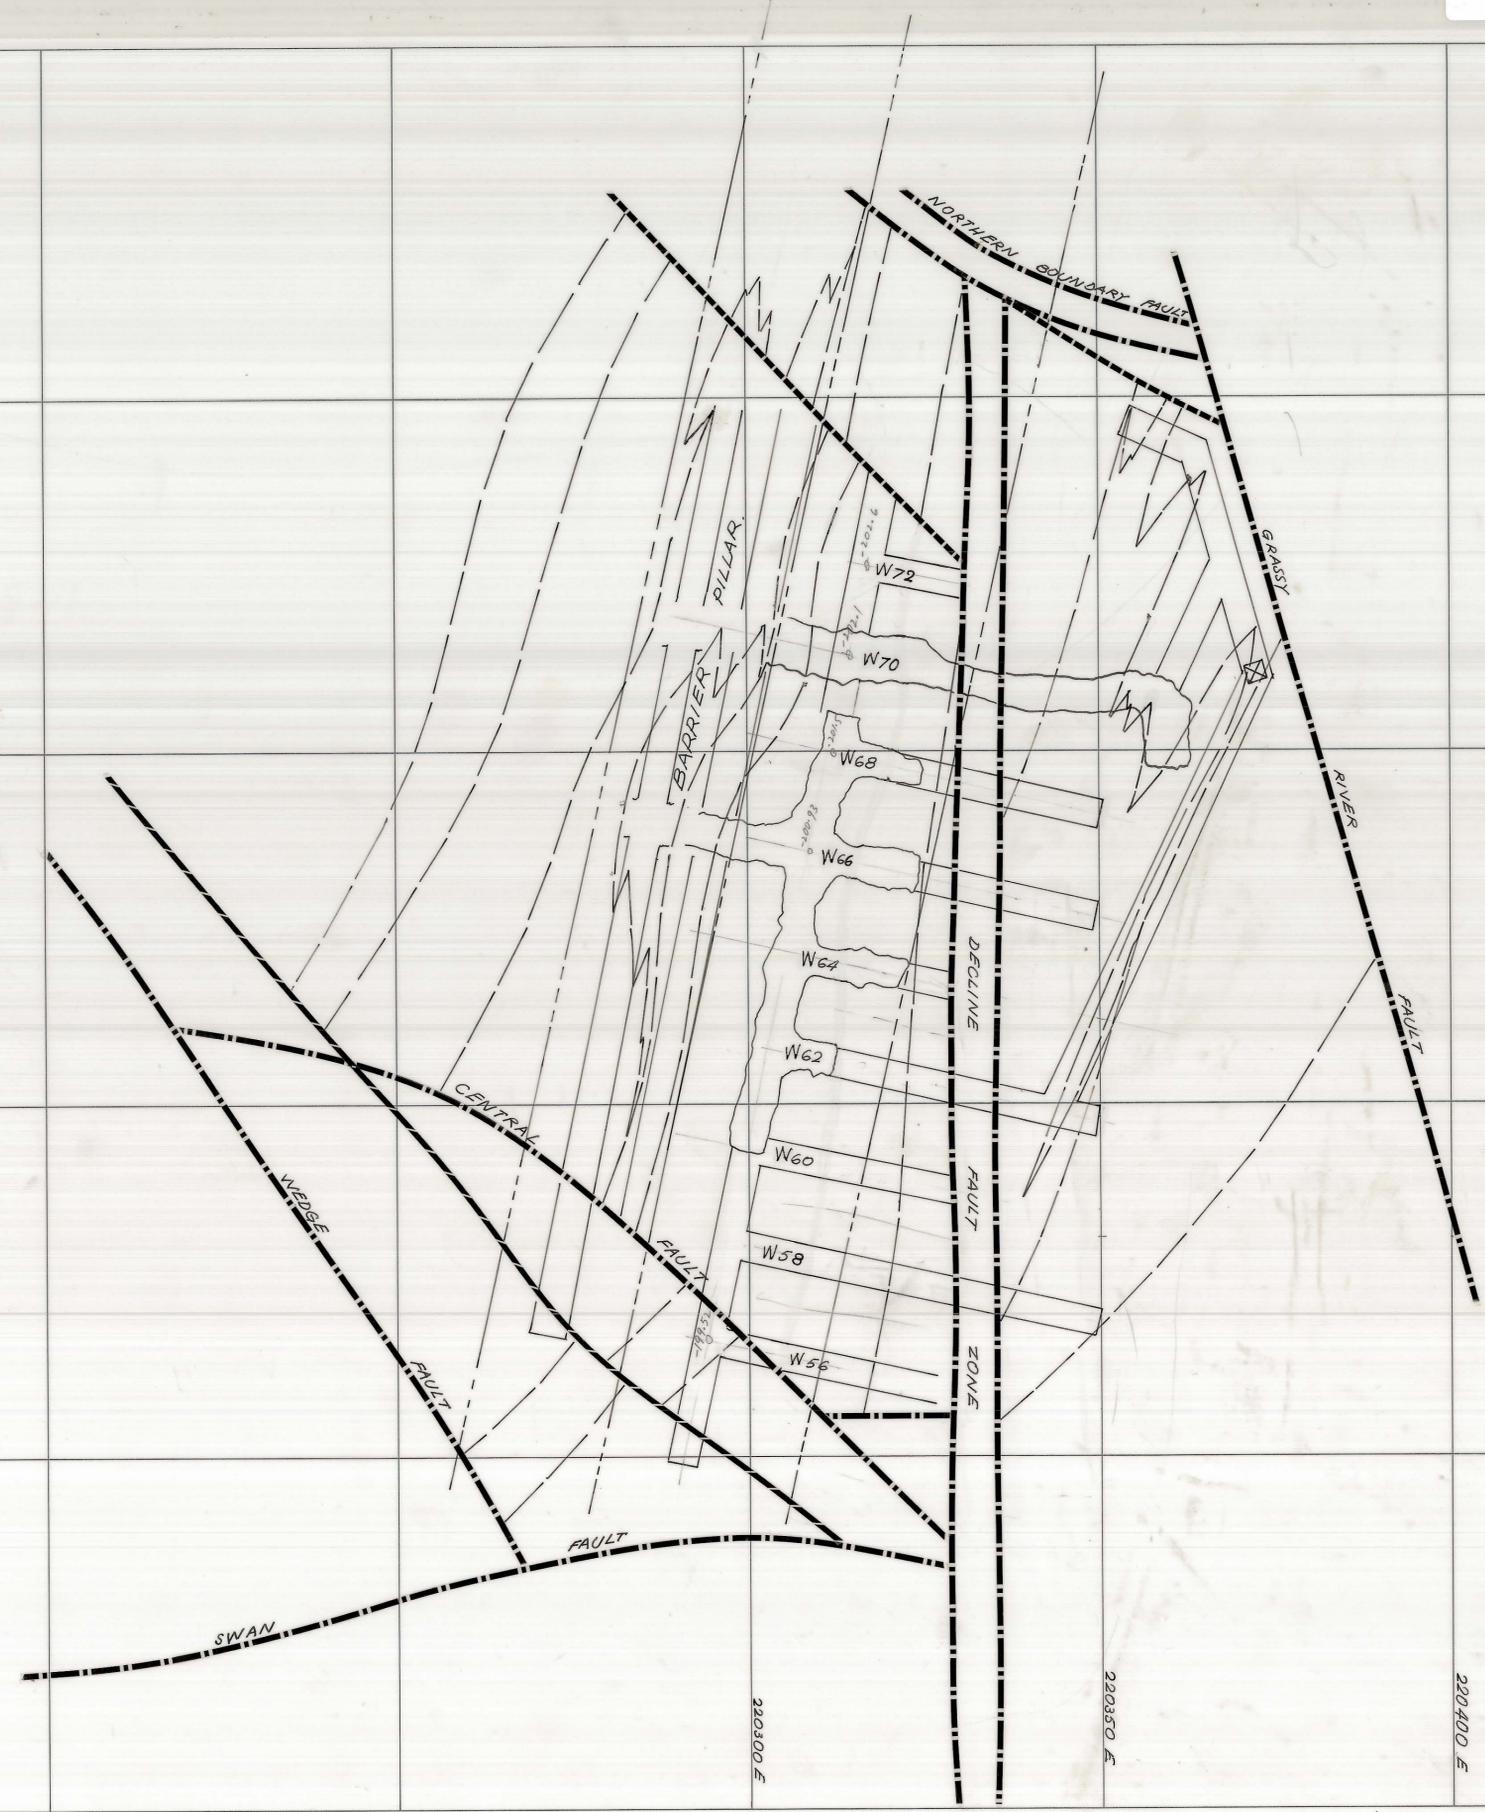

SCALE 1: 500

LOCATION DOLPHIN MINE

SUBJECT WEDGE & B LENS
-200 m R.L.
26 FEB. 1980



GRASSY KING ISLAND
PLAN NUMBER

north