


0374-253

04BH15 - 103 - 85


5 cm

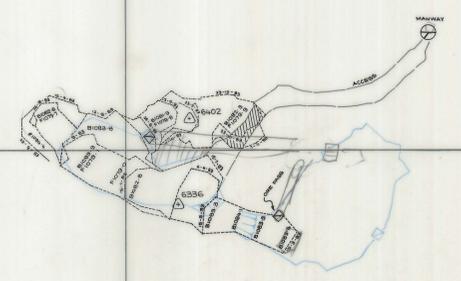

10 4500 N
10 4000 N
10 3500 N
10 3000 N
10 2500 N
10 2000 N
10 1500 N
10 1000 N
10 500 N

40 400 E
40 350 E
40 300 E
40 250 E
40 200 E
40 150 E
40 100 E
40 50 E

SCALE 1: 500

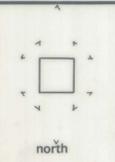

LOCATION

BOLD HEAD MINE

SUBJECT

H 50 STOPE
15 th lift

KIS KING ISLAND SCHEELITE
A DIVISION OF WARMAN INTERNATIONAL

GRASSY KING ISLAND

PLAN NUMBER

04BH15 - 103 - 85