


5 cm

Layout only

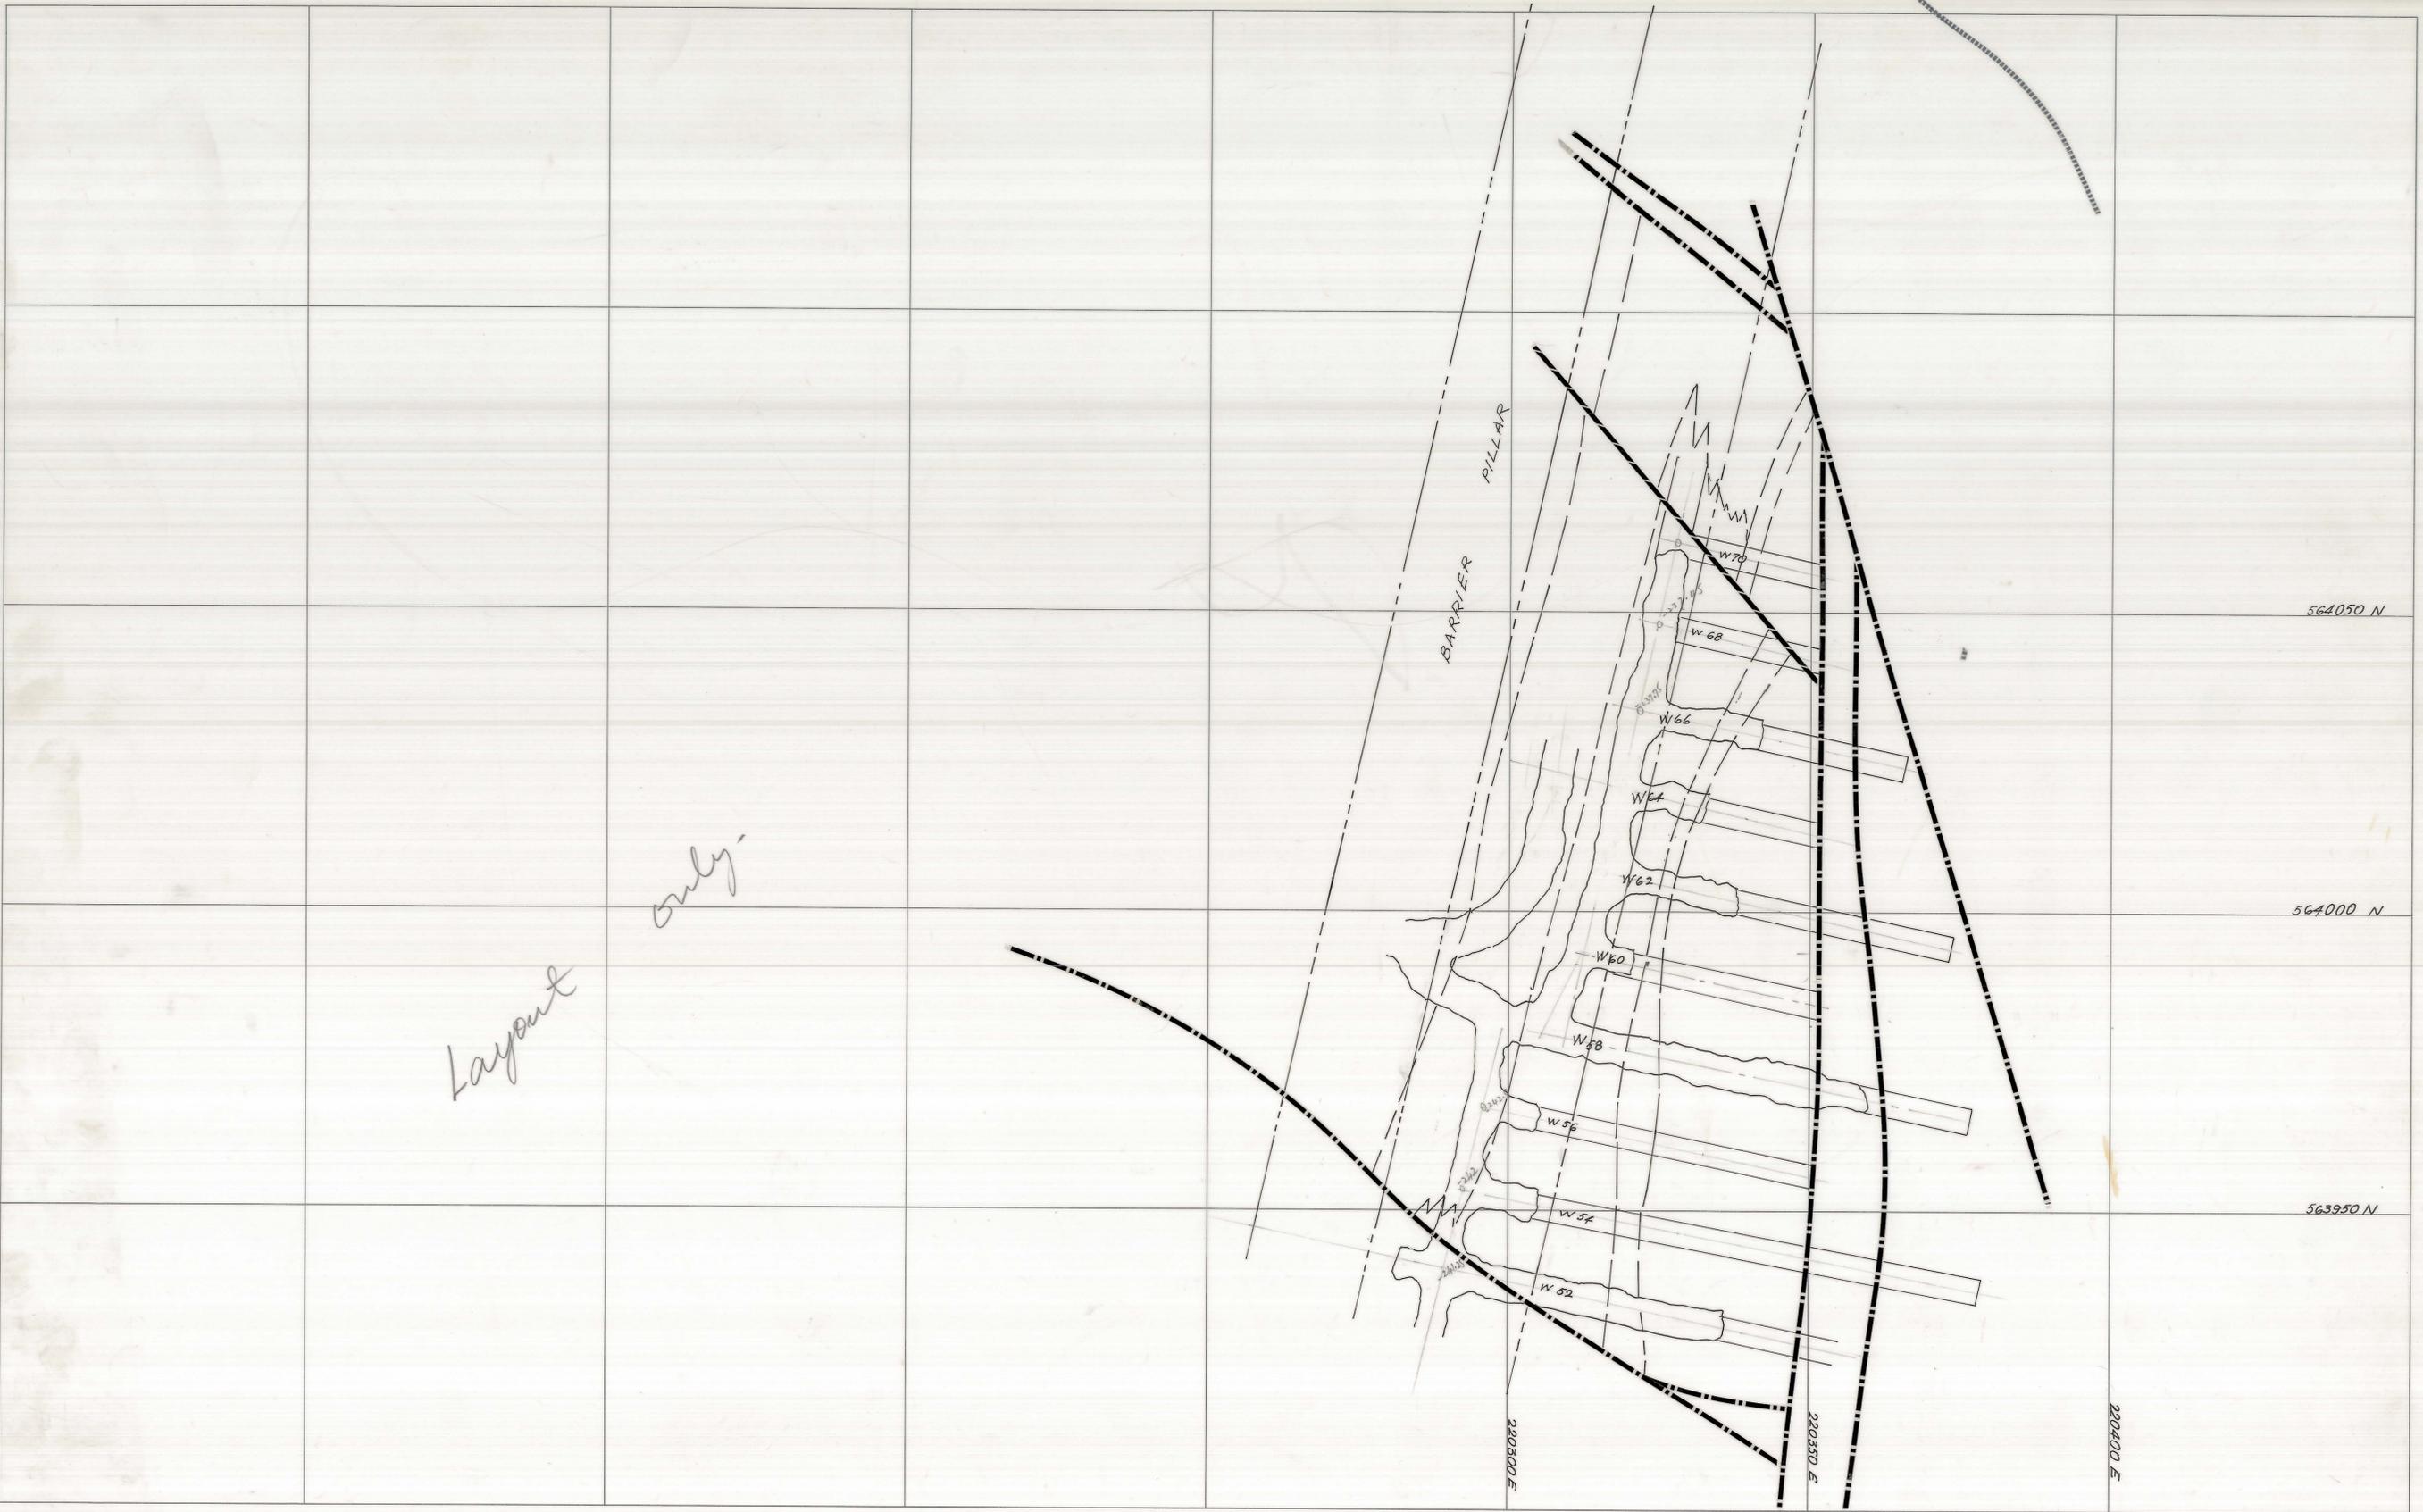

SCALE 1: 500

LOCATION
DOLPHIN MINE

SUBJECT
WEDGE & B LENS
-240 m R.L.
26 FEB. 1980.

KE KING ISLAND SCHEELITE
A DIVISION OF WARMAN INTERNATIONAL

GRASSY KING ISLAND

PLAN NUMBER

north