


27 JUN 1981


0374-255

04BH15-103-87

5 cm

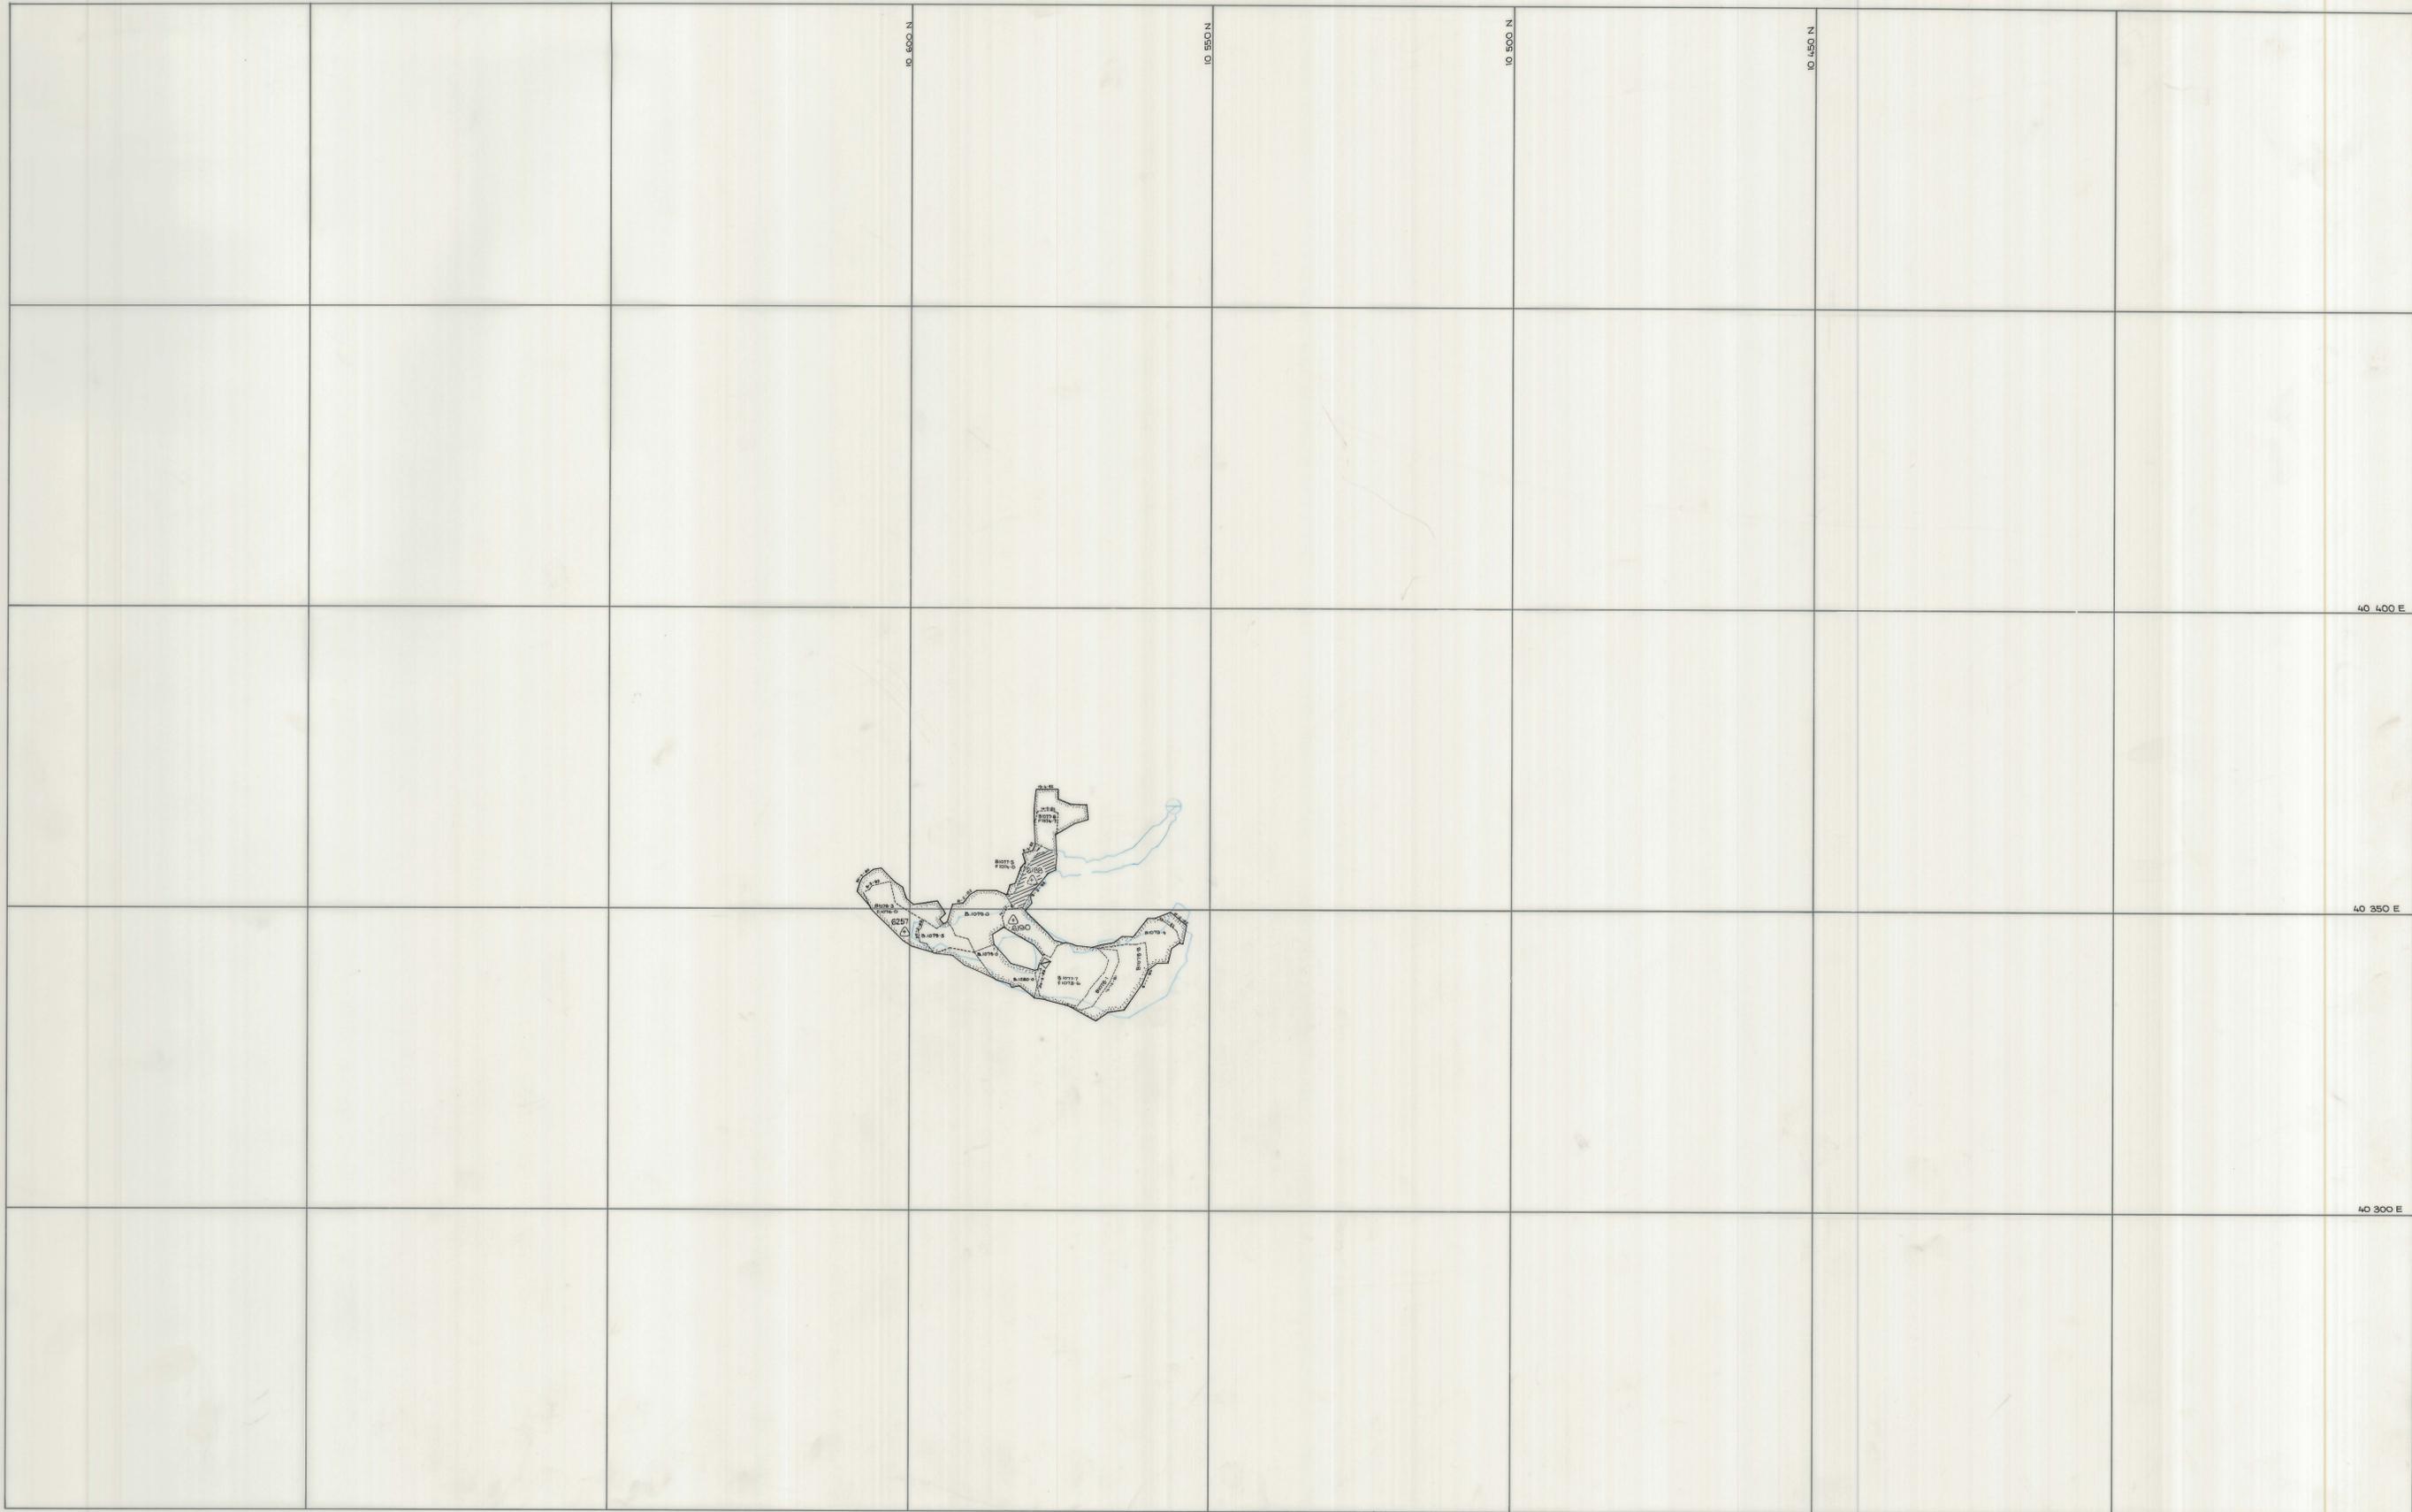

SCALE 1:500

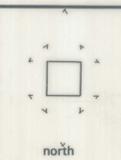

LOCATION
BOLD HEAD MINE

SUBJECT
H50 STOPE
13th lift

KIS KING ISLAND SCHEELITE
A DIVISION OF WARMAN INTERNATIONAL

GRASSY KING ISLAND
PLAN NUMBER 03-87

04BH15 - 103 - 87