


5 cm

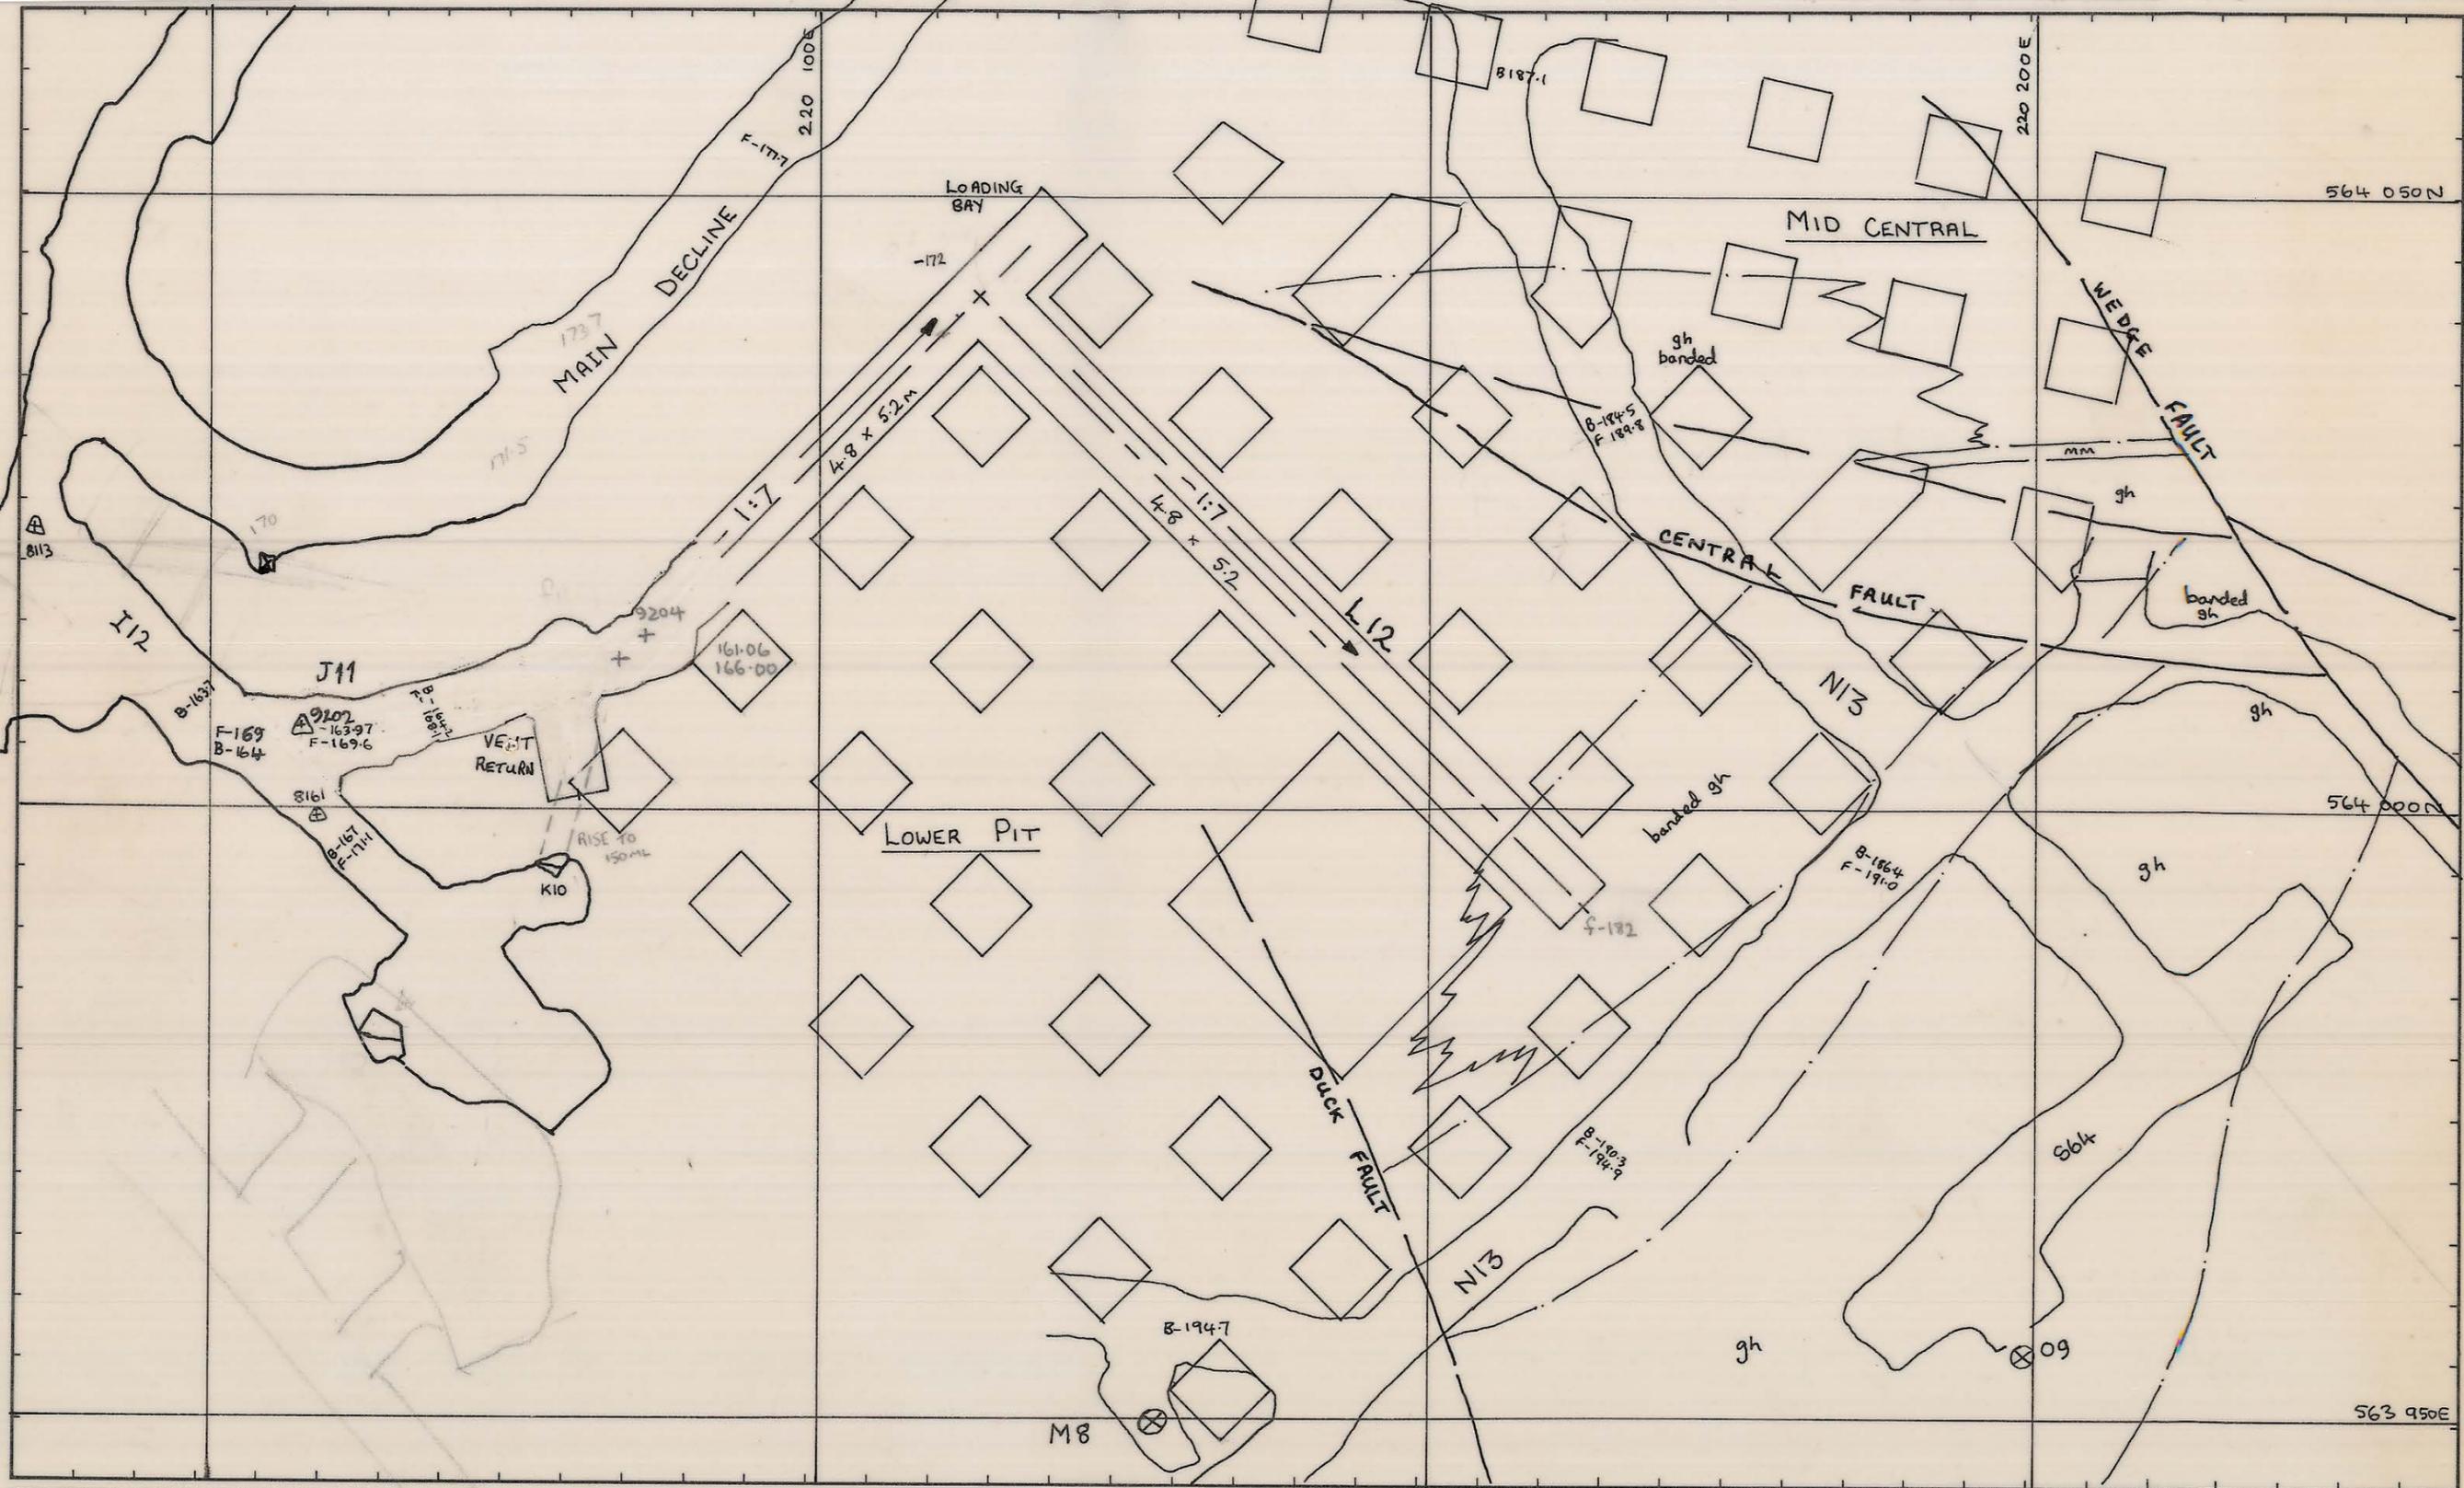

Setup at 164.5
3.44 m below peg.

162
166
16

8° 21' 57"

8° 22'

6.8

1

1/68 - 1600

REF PLAN	MADA 20/10/84.	GEOLOGY at 180m	AD7	11-9-84	SCALE 1:500	
		SURVEY				
		PLANNING	AD7	6-9-84	LOWER PIT + MID-CENTRAL	
		ROCK MEC.	2/8	12-9-84	J11 ACCESS 160-180m LEVELS.	
		GRADE CON.			DRAWING NUMBER	
		DRAFTING			03 DM 04 - 3025	
		T.S.S.				