


5 cm

03 DM 04 - 3029

0374_2553

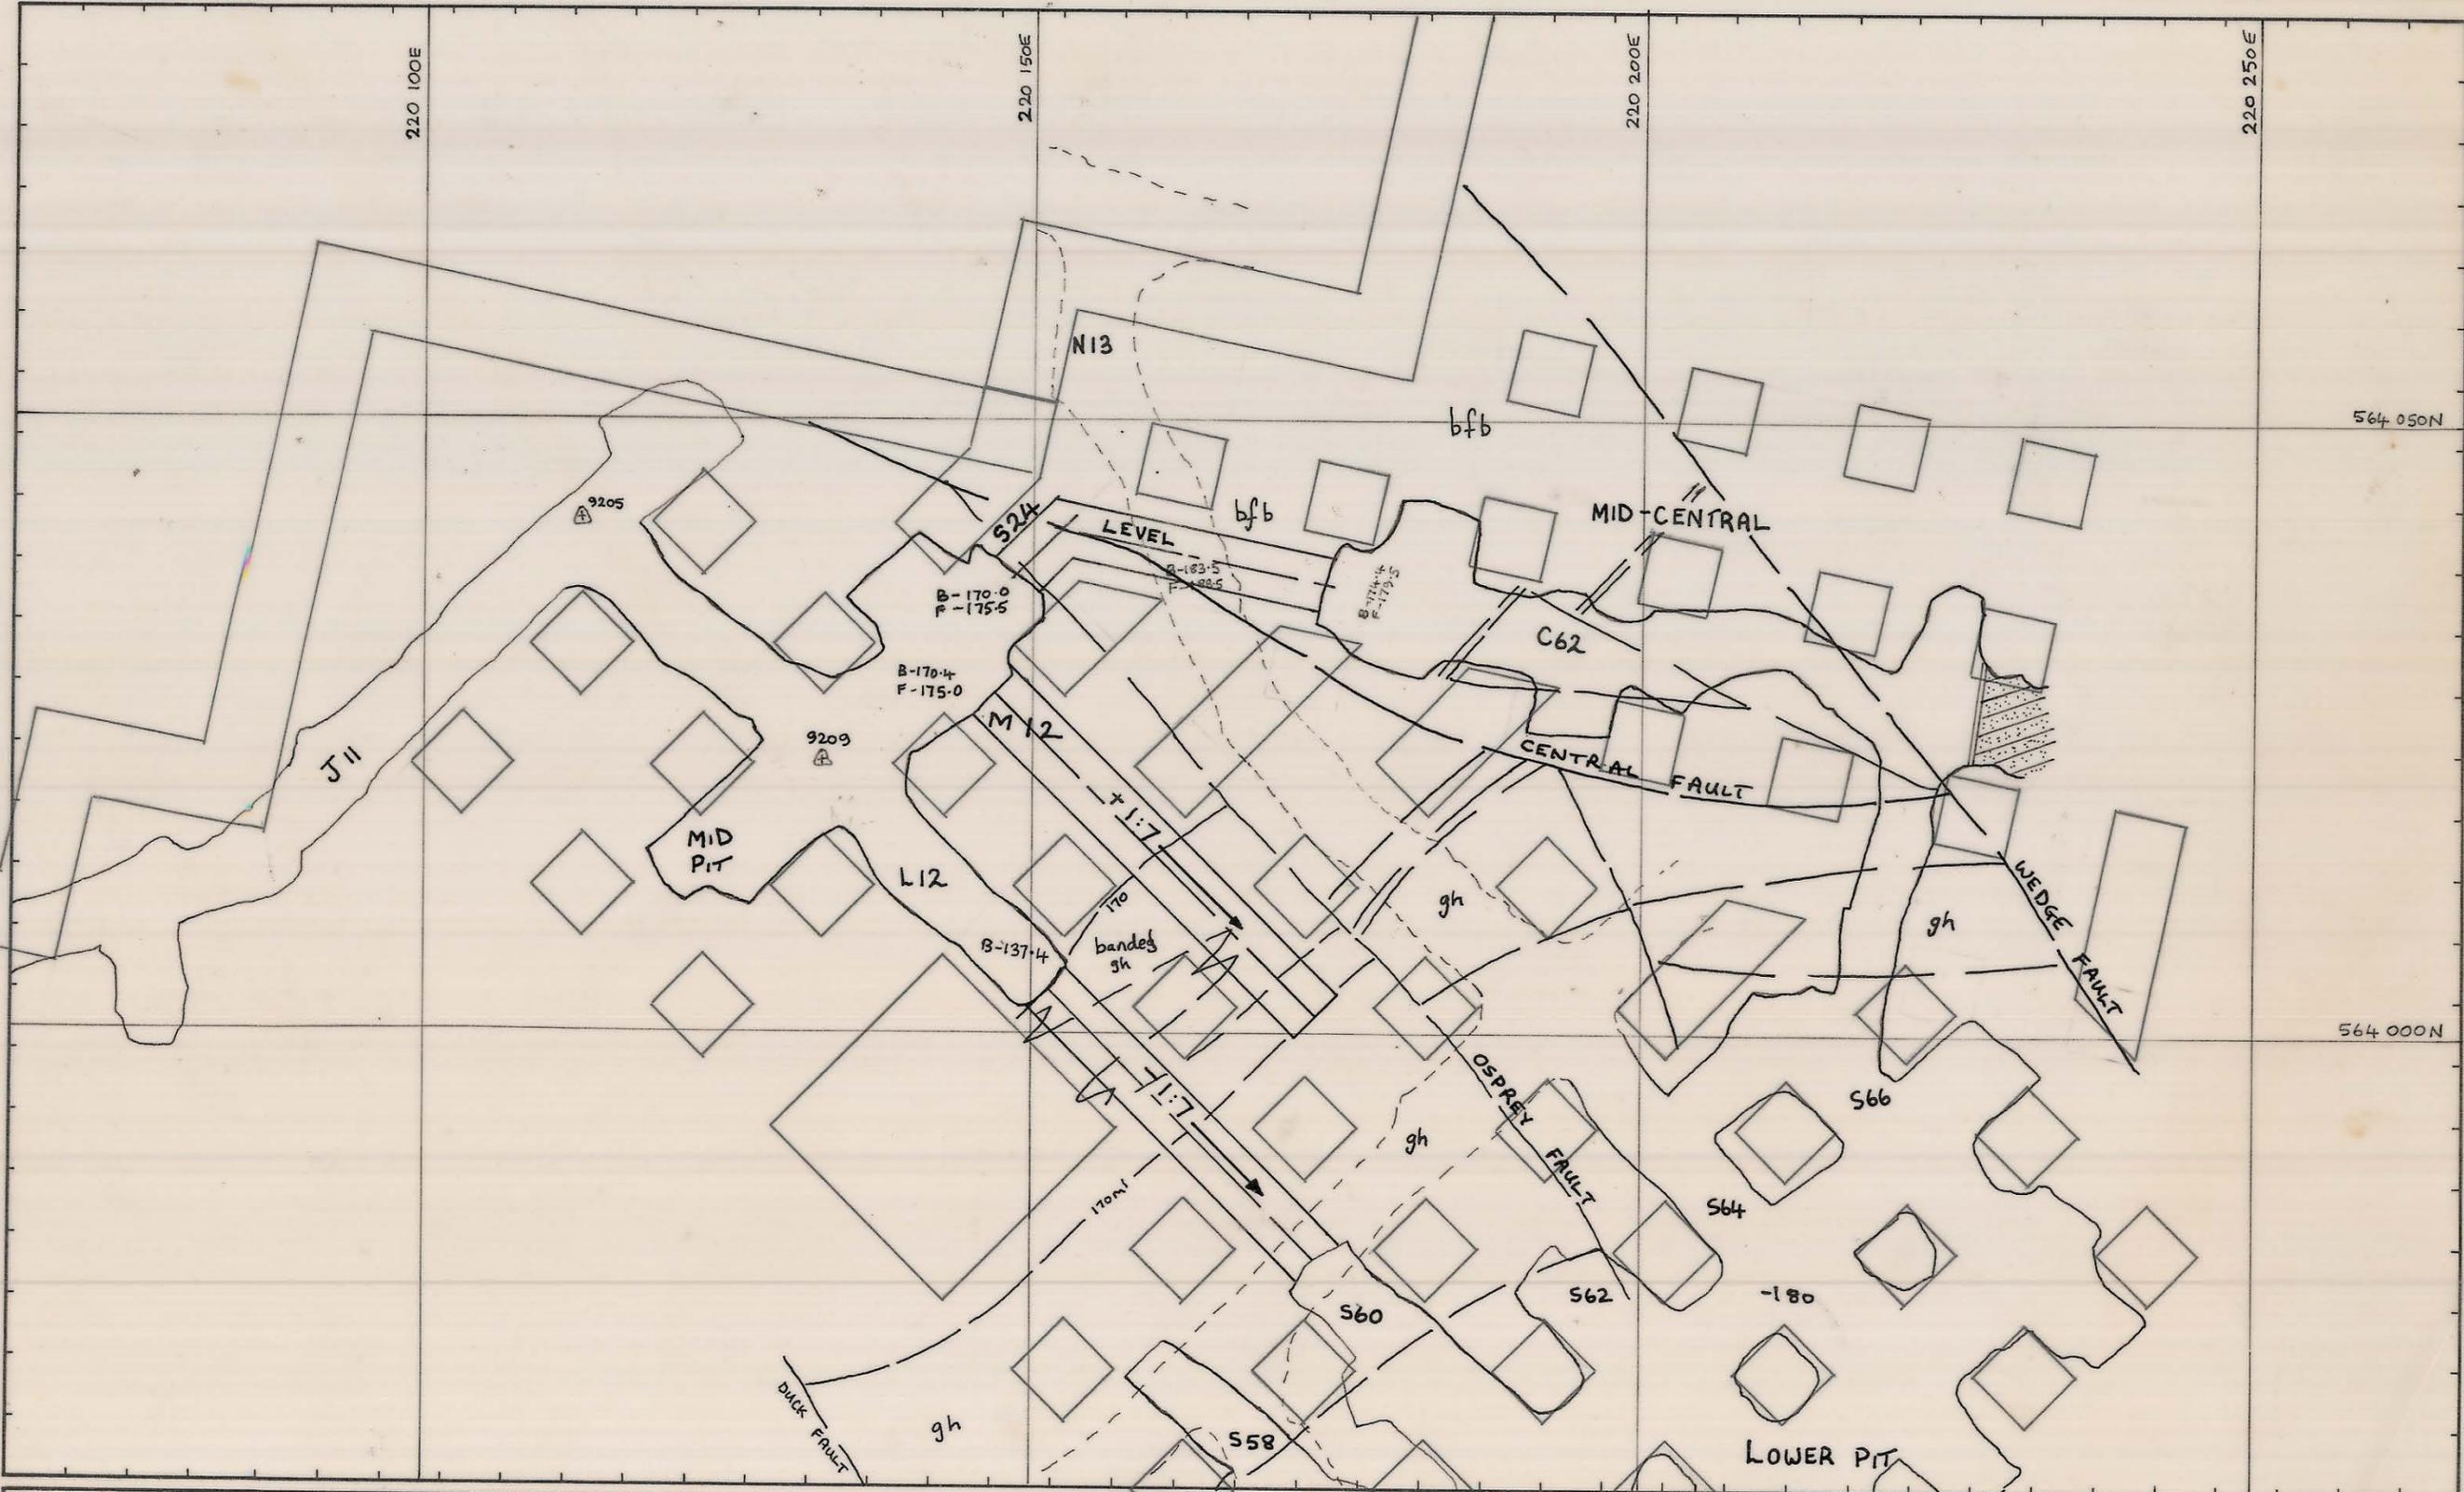

REE PLAN <i>MARCO or/lokes</i>	GEOLOGY	2 170mL.	SCALE 1:500	
	SURVEY			
	PLANNING	ADZ 4-9-85	1ST LIFT ACCESS TO MID-CENTRAL (S24)	
	ROCK MEC.		13TH LIFT ACCESS TO LOWER PIT. (M12)	
	GRADE CON.		DRAWING NUMBER	
	DRAFTING		03 DM 04 - 3029	
	T.S.S.			