


Section AA'
Scale 1:100

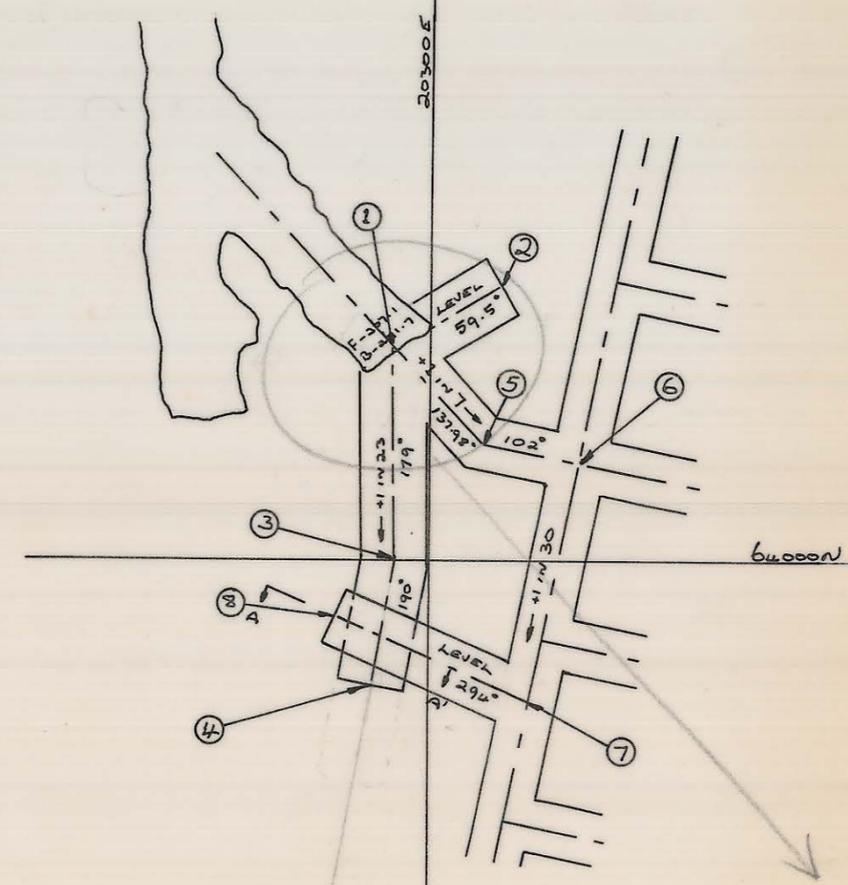

NOTES:

- 1) X CUT 78 TO BE DRIVEN AND SUPPORTED BEFORE X CUT 134.
- 2) STOPS MUST BE PROVIDED IN THE LOADER DRIVE AS PER SECTION AA'.

CANCELLED DUE
TO BAD GROUND
& SETS. TRUCKS
TO BE LOADED
AT Pt. 6

POINT	E	N	RL
1	20297.03	64016.55	-267.10
2	20305.25	64021.37	-267.10
3	20297.34	64000.55	-266.68
4	20295.66	63991.00	-265.98
5	20303.76	64009.12	-265.67
6	20310.99	64007.58	-264.61
7	20307.15	63989.49	-263.99
8	20292.53	63995.99	-263.99

LEGEND: <input type="checkbox"/> <input type="checkbox"/> <input type="checkbox"/> <input type="checkbox"/>	PLANNING MINE SUPT. GEN. MINING SUPT SURVEYOR GEOLOGIST	A.J.C. 	PLAN NUMBER 03 DM 04 - 3009	DATE: 6/6/80 GEOL: DWN: RJC CHKD:	GEOPEKO LIMITED KING ISLAND Scale: _____ No K DOLPHIN MINE -260m RL TRUCK LOADING STATION
	(Empty space for additional notes or signatures)				