


0374_2564

03DM04 - 3019/1

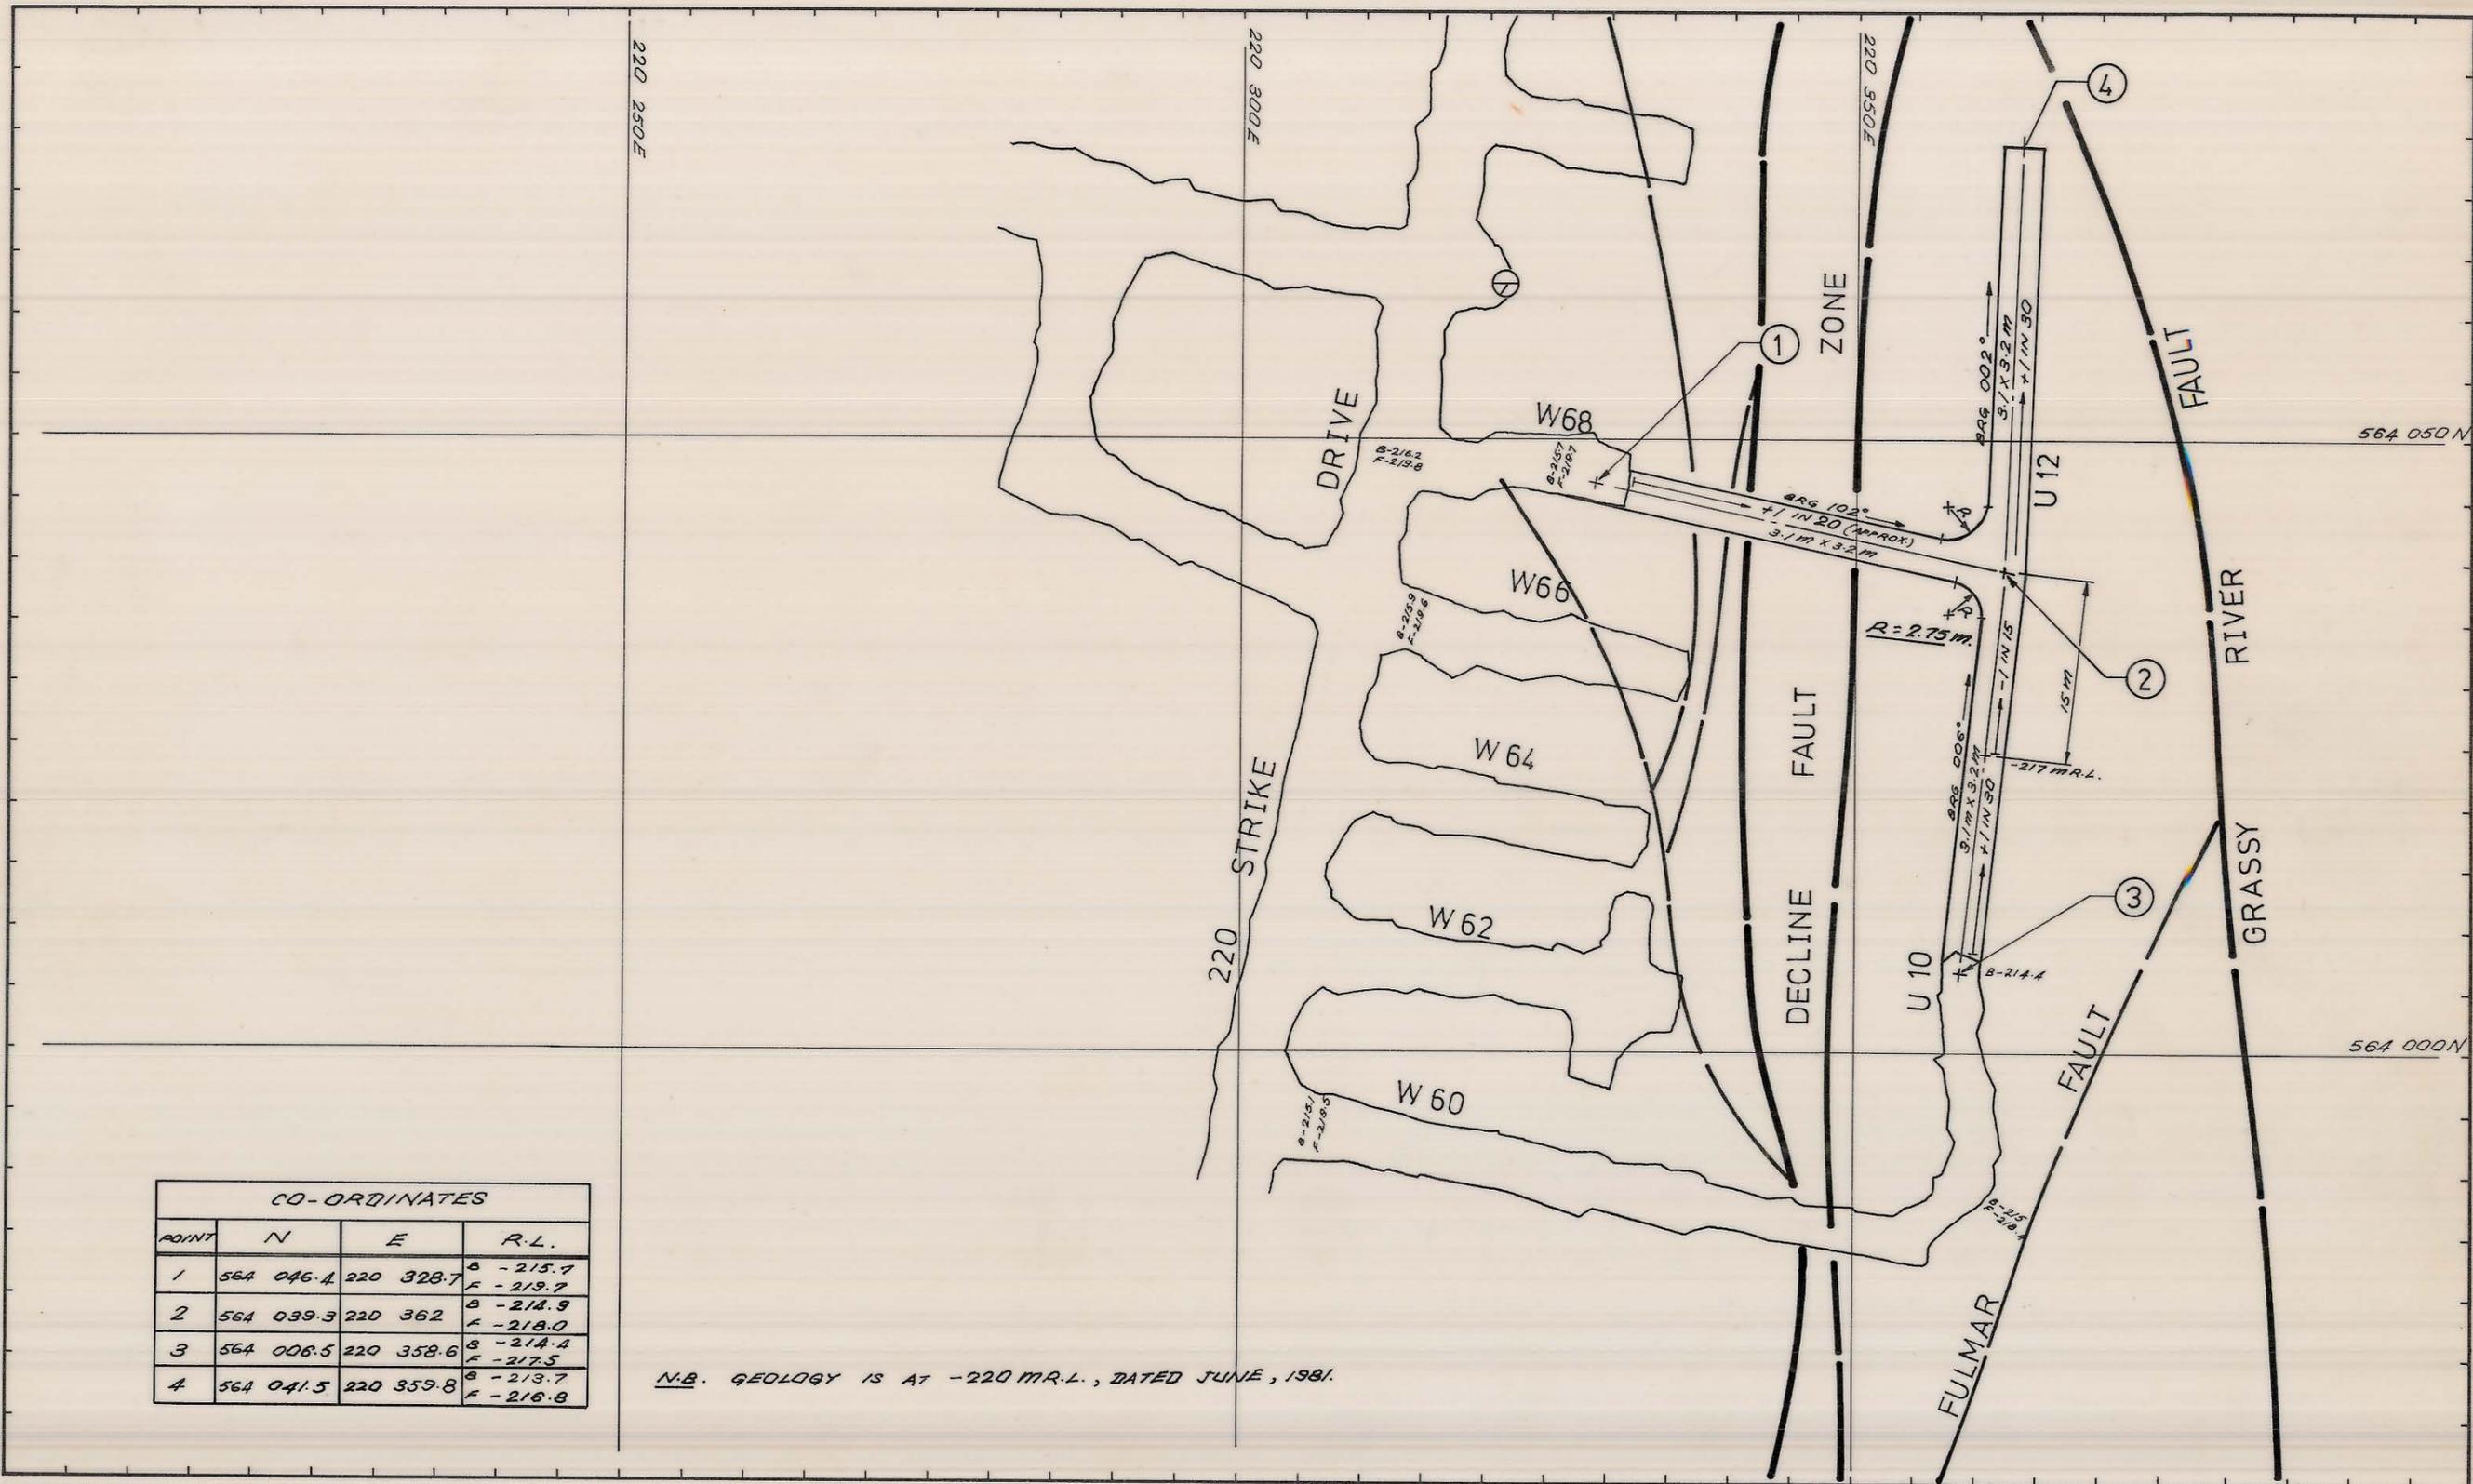

CO-ORDINATES			
POINT	N	E	R.L.
1	564 046.4	220 328.7	B - 215.7 F - 219.7
2	564 039.3	220 362	B - 214.9 F - 218.0
3	564 008.5	220 358.6	B - 214.4 F - 217.5
4	564 041.5	220 359.8	B - 213.7 F - 216.8

N.B. GEOLOGY IS AT -220 M.R.L., DATED JUNE, 1981.

REF PLAN	04DM14 - 1108	11/81	GEOLOGY	R.G.S.D.	25-6-81	SCALE	1: 500	
SURVEY								
PLANNING						DOLPHIN MINE LOWER WEDGE HANGING WALL SUPPORT DRIVES AT -220m LEVEL.		
ROCK MEC.								
MINE SUPT.						DRAWING NUMBER	03DM04 - 3019/1	
T.S.S.								
G.M.S.								

REVISION NO 1: U12 HAS BEEN MOVED FURTHER EAST TOWARD GRASSY RIVER FAULT. P.B. 31-8-81.