


03DM04-4012

0374_2571

5 cm

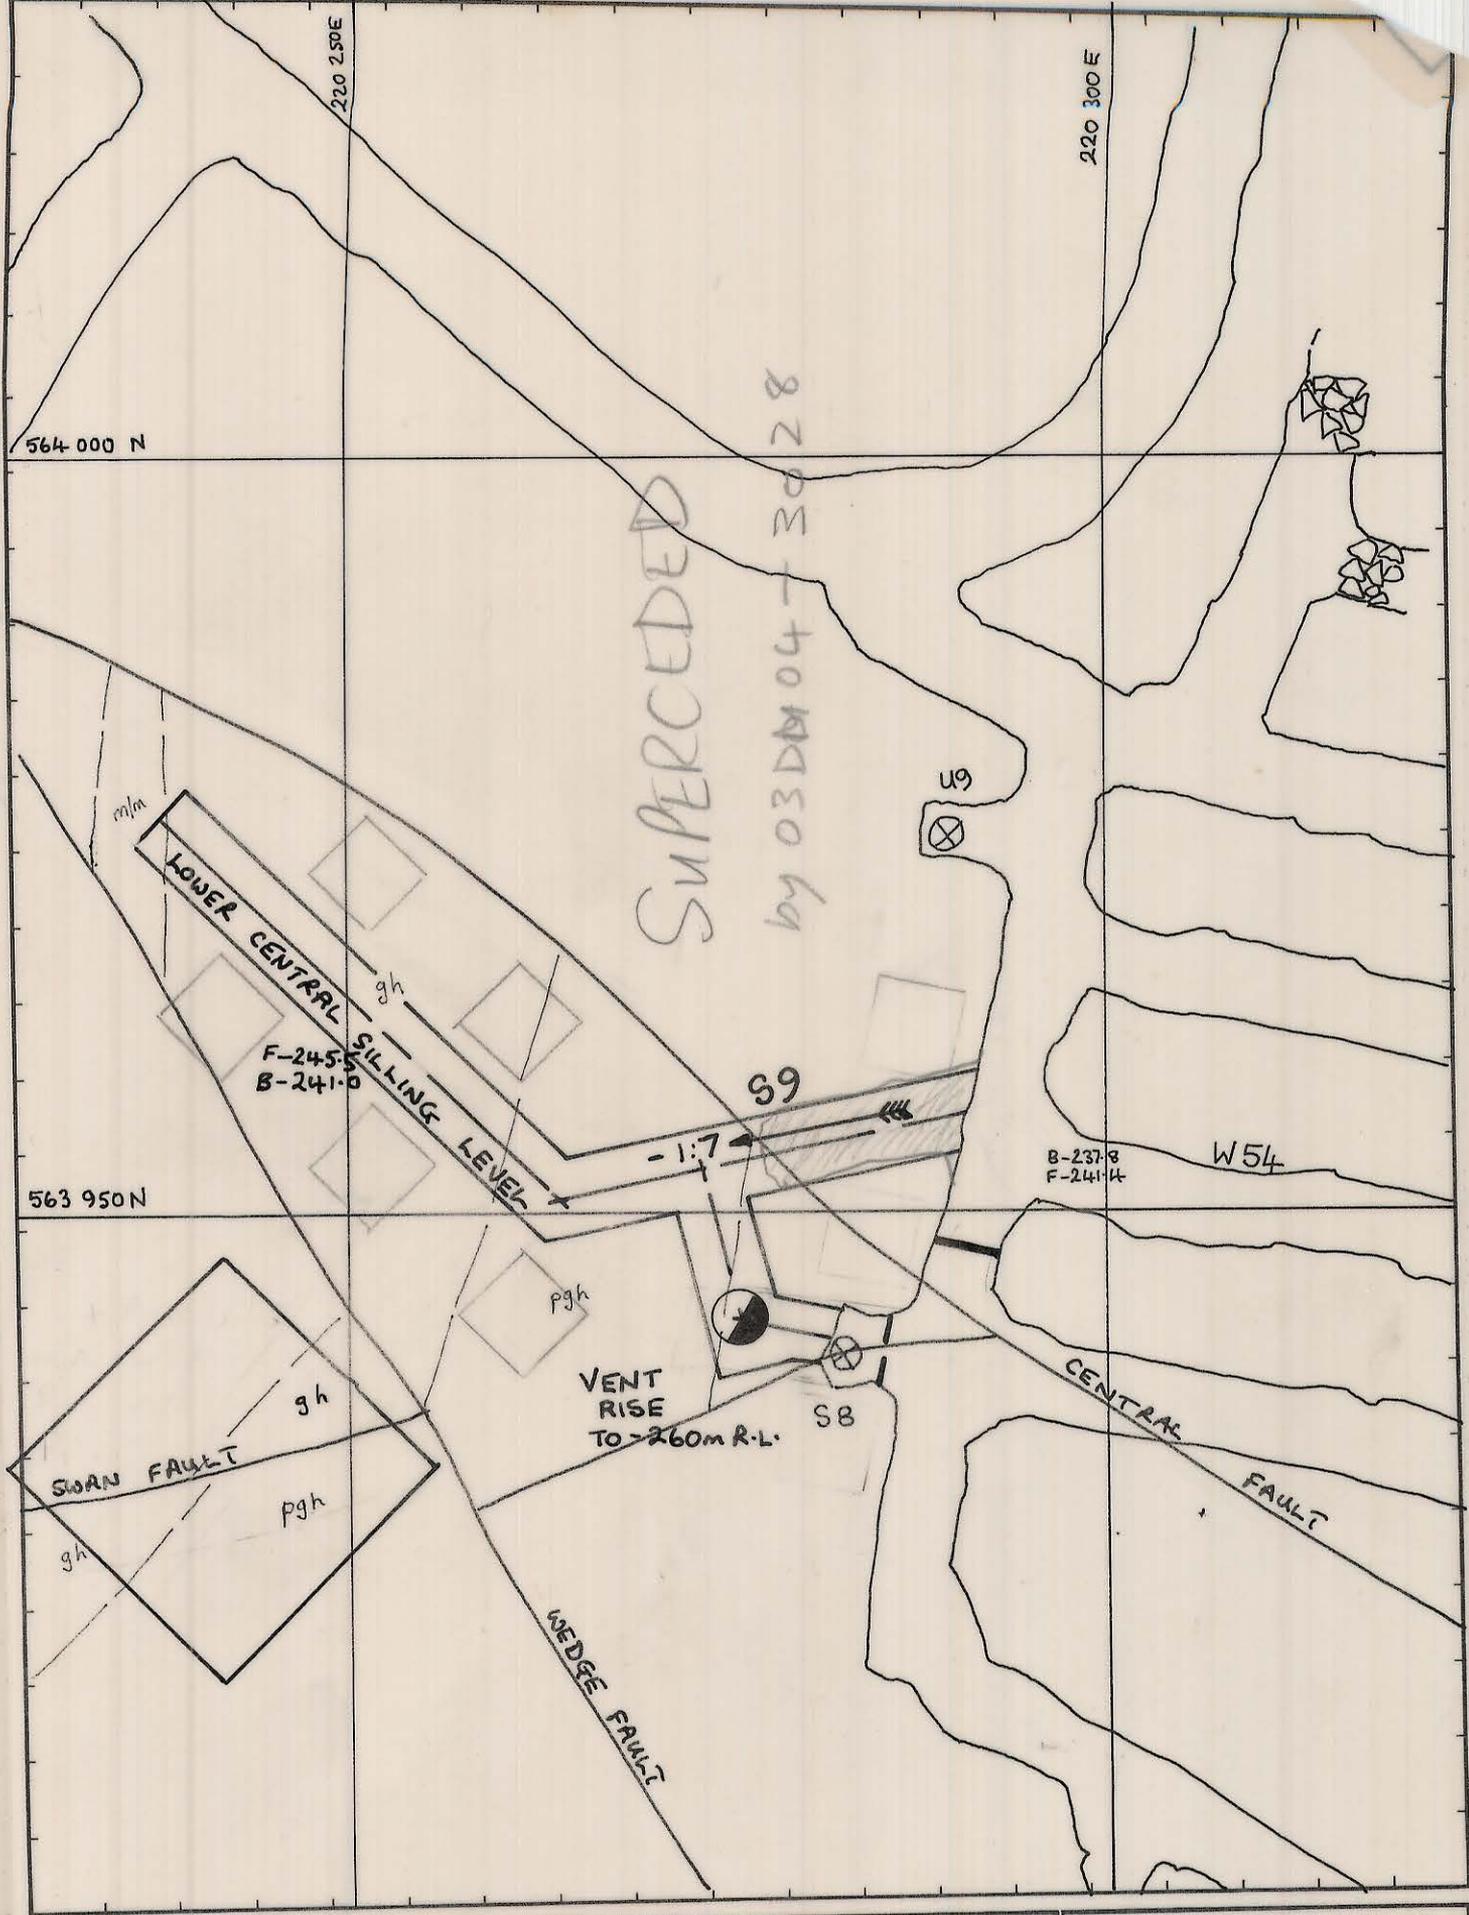

REF PLAN	<i>Matt 18/03/88</i>		GEOLOGY		1:500 SCALE	
			SURVEY			
			PLANNING	<i>ADJ</i>	<i>30-11-84</i>	LOWER CENTRAL MID-ACCESS AND VENT RETURN SYSTEM
			ROCK.MEC.	<i>9/11/84</i>	<i>3-12-84</i>	
			GRADE CON.			
		DRAFTING			DRAWING NUMBER	
		T.S.S.			03 DM 04 - 4012	