
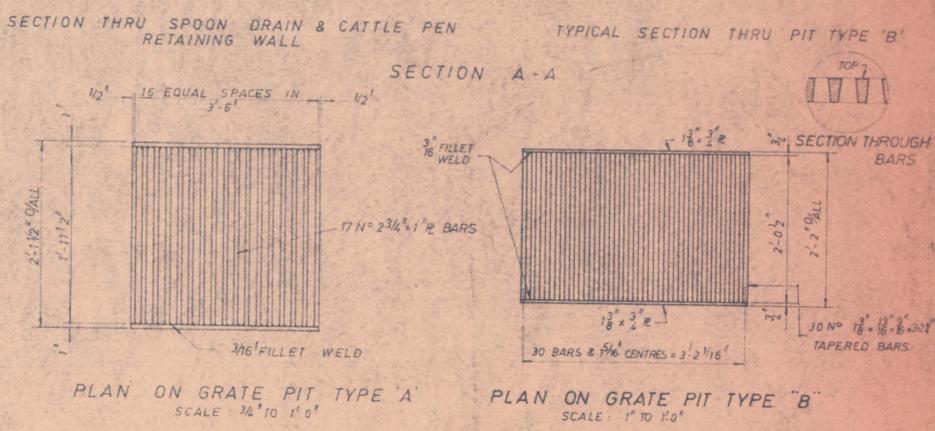
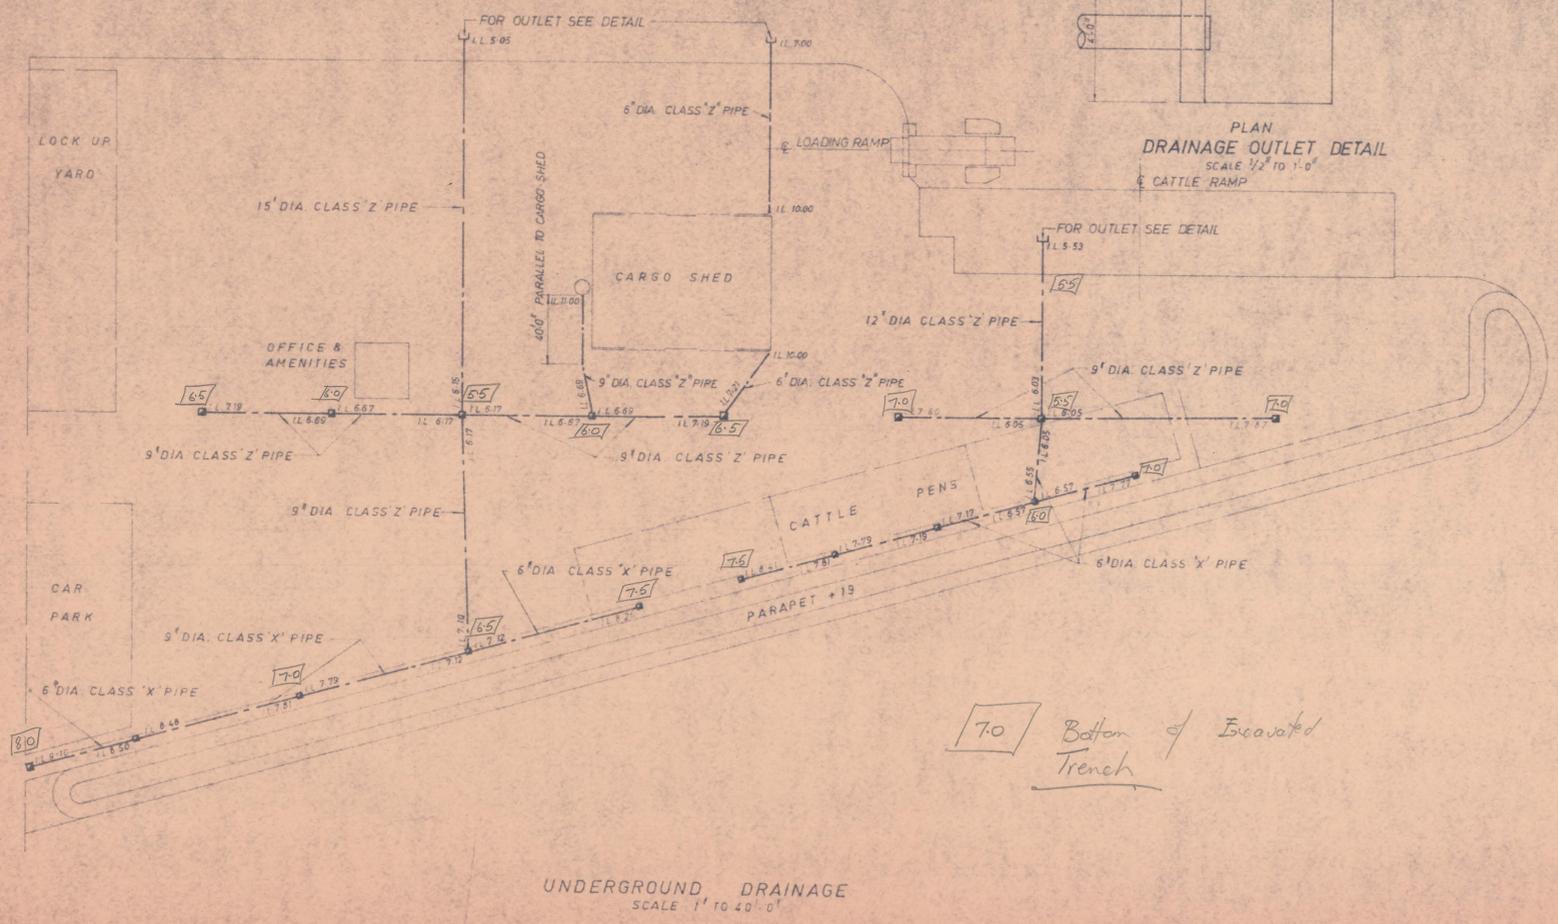
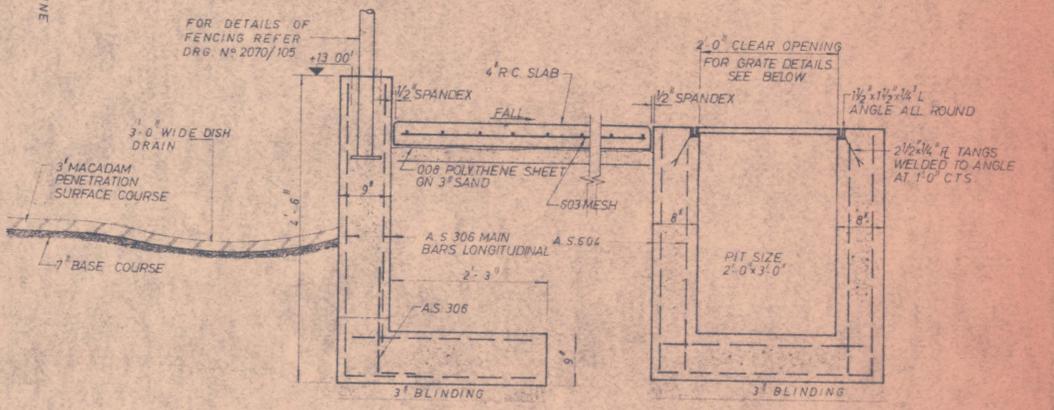
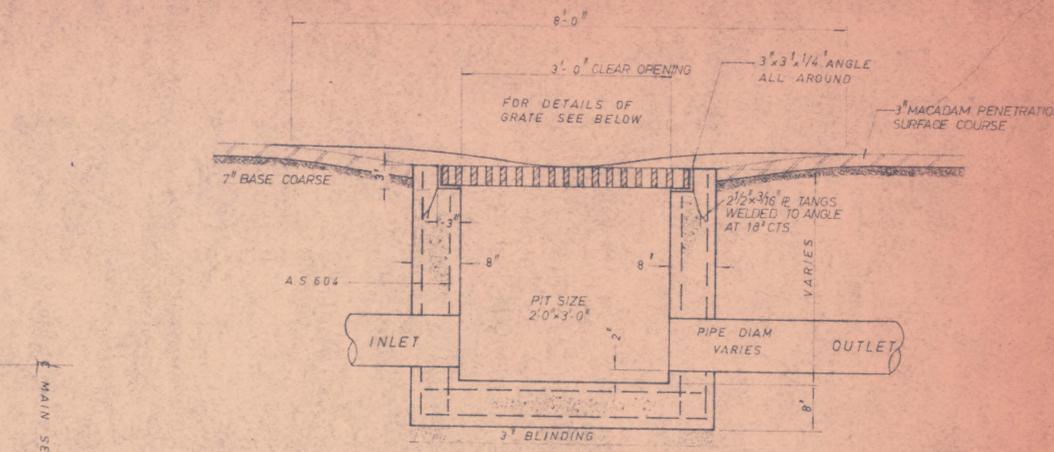


OS 74-2572

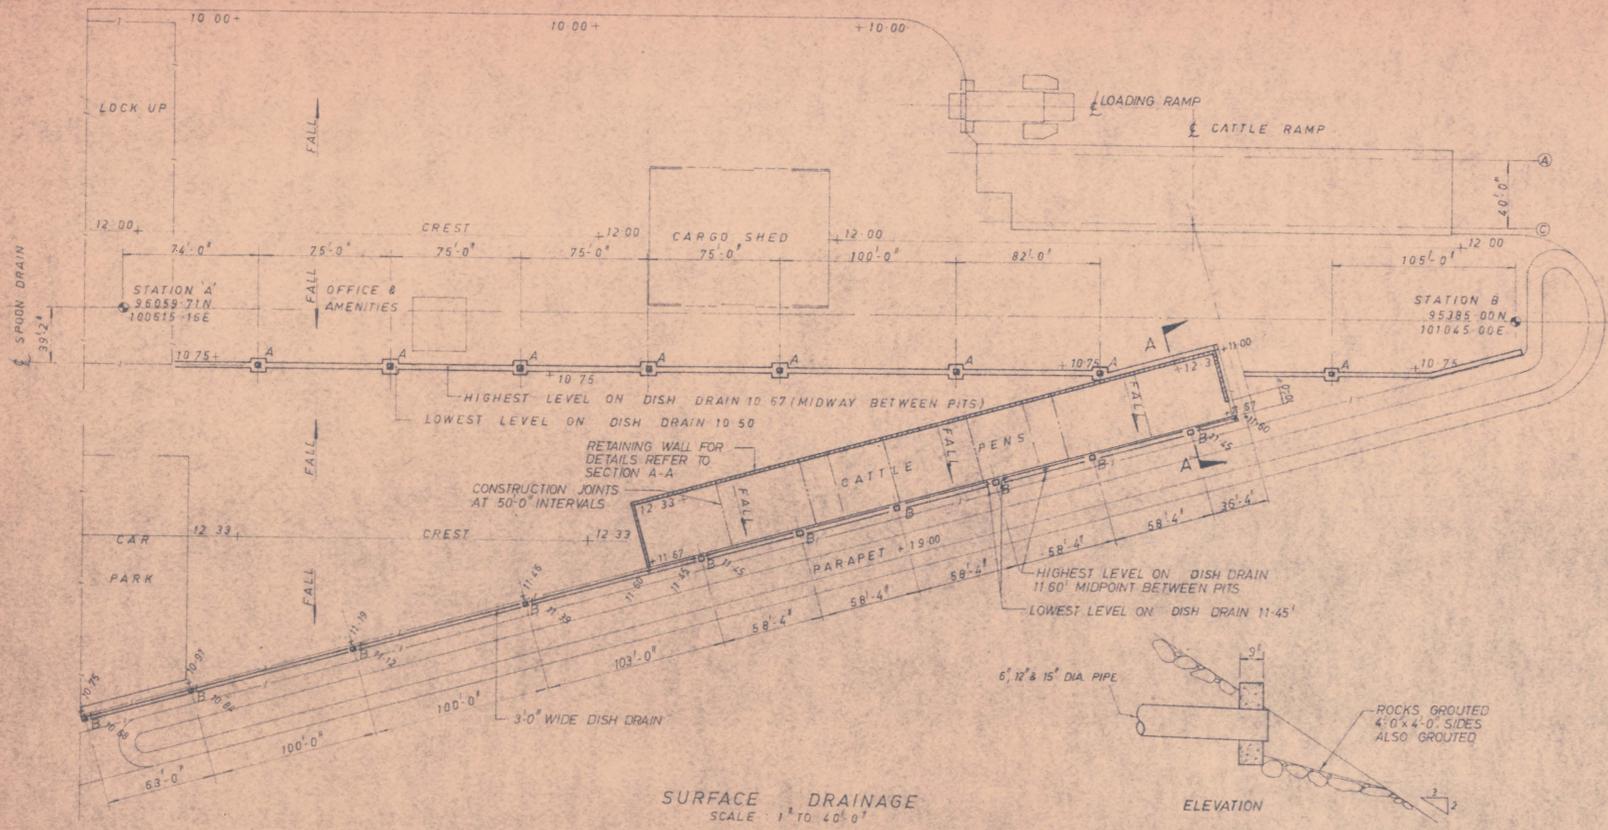

70 Bottom of Excavated Trench

GENERAL NOTES:
CONCRETE CLASS GENERAL 3K
BLINDING 2K

REV.	DATE	DESCRIPTION
B	5/7/71	WORKING DRAWING
A	5-5-71	UNDERGROUND DRAINAGE ILS ALTERED SECTION A-A ARROWS REVERSED, PIT TYPE 'B' REV
<p>KING ISLAND SCHEELITE LTD. PORT AT LITTLE GRASSY BAY</p> <p>DRAINAGE & GRATING DETAILS</p> <p>MAUNSELL & PARTNERS CONSULTING ENGINEERS SYDNEY CANBERRA MELBOURNE ADELAIDE PERTH</p> <p>SCALE AS SHOWN DATE JANUARY 71 DATE OF ISSUE A.J.C. N.M. K.A.S. 6 JUL 1971</p> <p>DRG. No. 2070/104 B</p> <p>WORKING DRAWING</p>		

1 + 11 - B (w)