


03DM05-1006 D.

0374_2576

5 cm

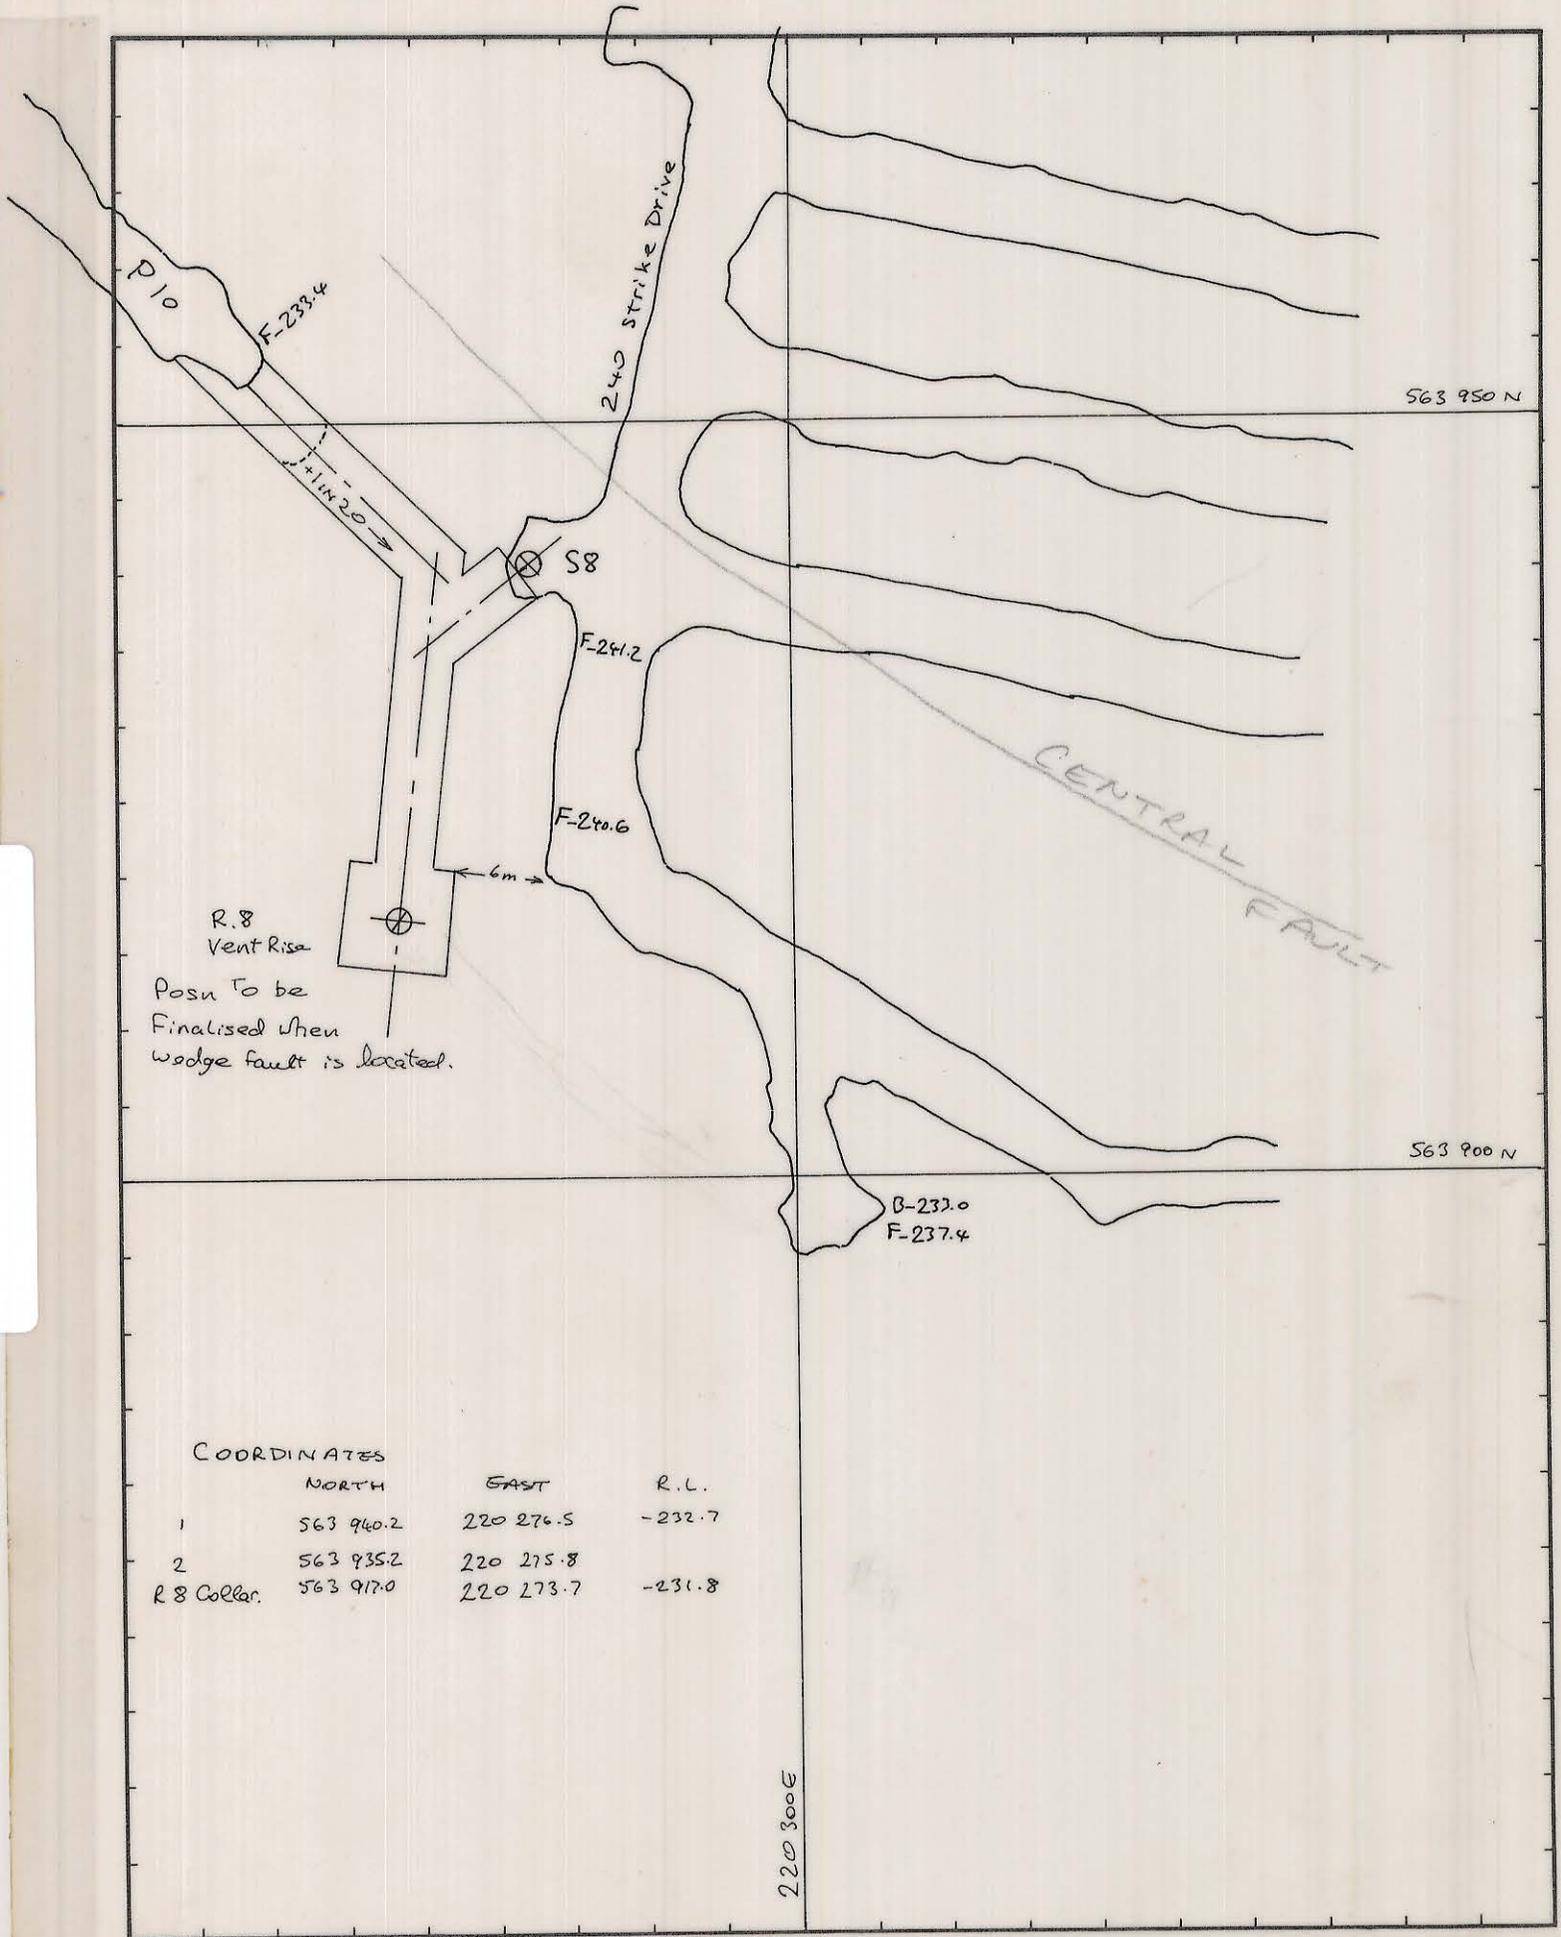

COORDINATES			
	NORTH	EAST	R.L.
1	563 940.2	220 276.5	-232.7
2	563 935.2	220 275.8	
R8 Collar.	563 917.0	220 273.7	-231.8

REF PLAN	GEOLOGY	RESID	25/9/81	1:500 SCALE	KING ISLAND SCHEELITE GRASSY KING ISLAND
GEOLOGY NOTE: WEDGE FAULT IS PROBABLY IN VICINITY OF R8 RISE.	SURVEY	W. J. M.	2/10/81	240 metre Level R8 Vent Rise and Vent Return to S8 Vent Rise.	
	PLANNING	W. J. M.	24/9/81		
	ROCK.MEC.	W. J. M.	7/10/81		
	MINE SUPT.				
	G.M.S.				
T.S.S.				DRAWING NUMBER	03 DM05 1006 D