


03 DM 04-3002

0374_2578

5 cm

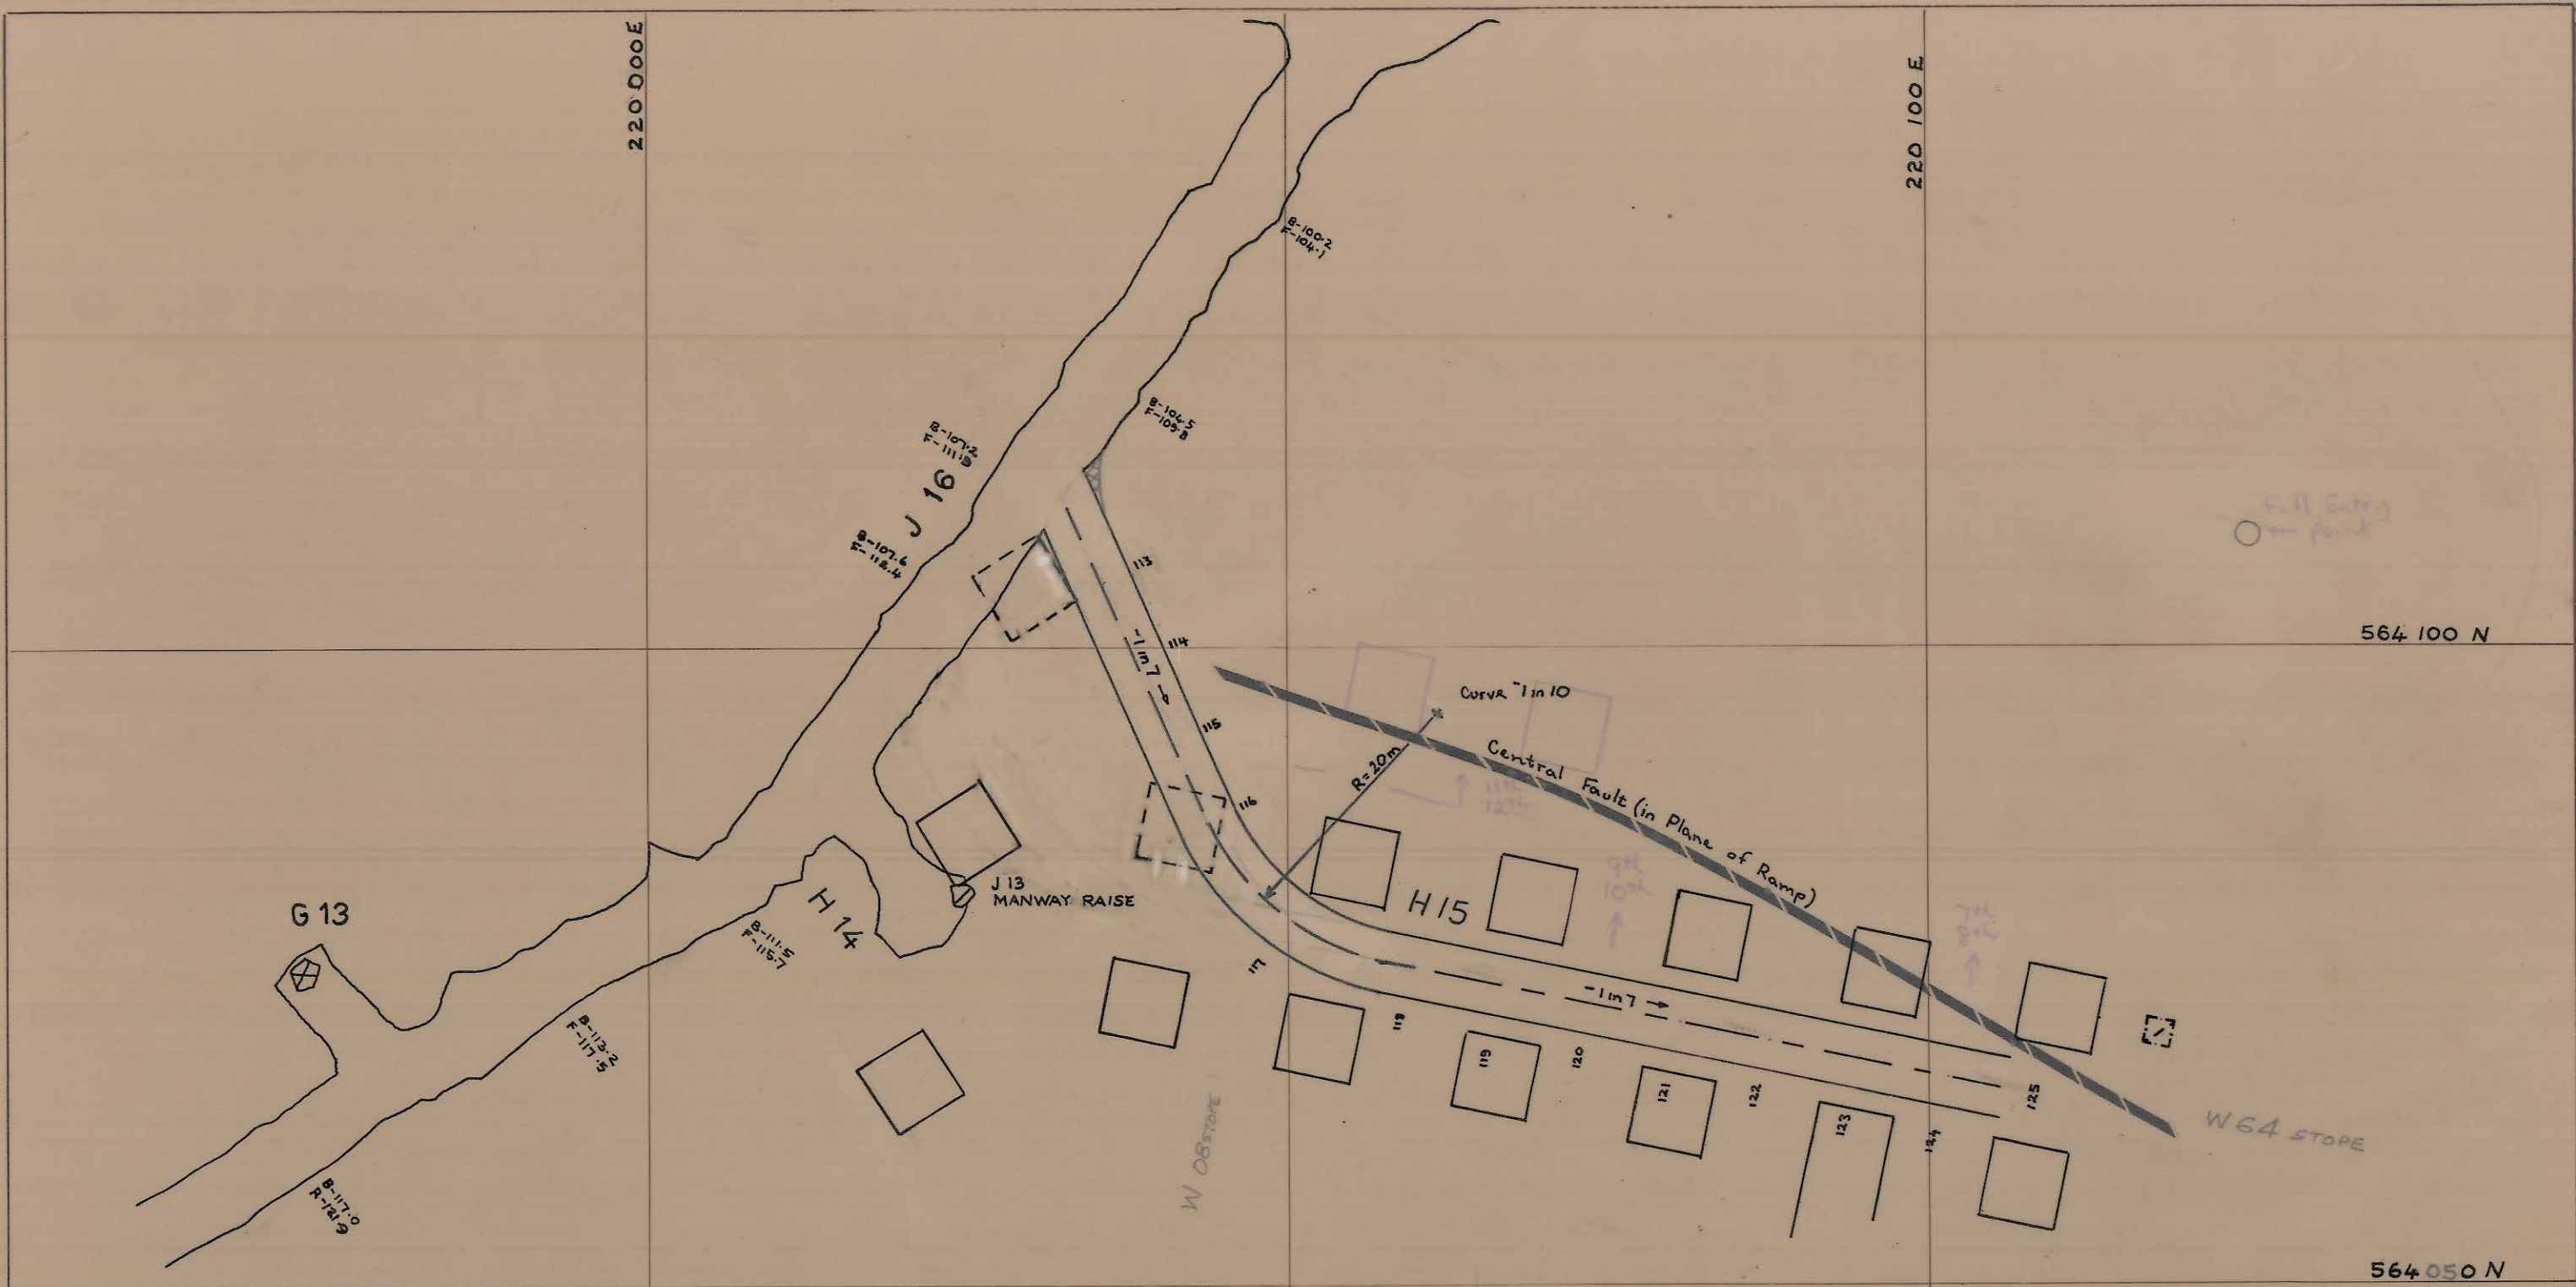

KING ISLAND SCHEELITE		APPROVAL	COPY
DATE: 9 AUGUST 1977	SCALE: 1:500	PLANNING ENG.: <i>du</i>	
MINE: DOLPHIN	DWG/NO.: 03 DM 04-3002	SENIOR PLAN. ENG.: <i>du</i>	
PROPOSED LAYOUT FOR:		MINE SUPT.: <i>du</i>	-3-
<u>H15 RAMP</u>		G. MINING SUPT.: <i>du</i>	1
CENTRAL STOPE ACCESS.		SENIOR SURV'R.: <i>du</i>	
L=100m		SENIOR GEOLOGIST: <i>du</i>	
PRELIMINARY		SURVEYOR:	
FINAL			