


5 cm

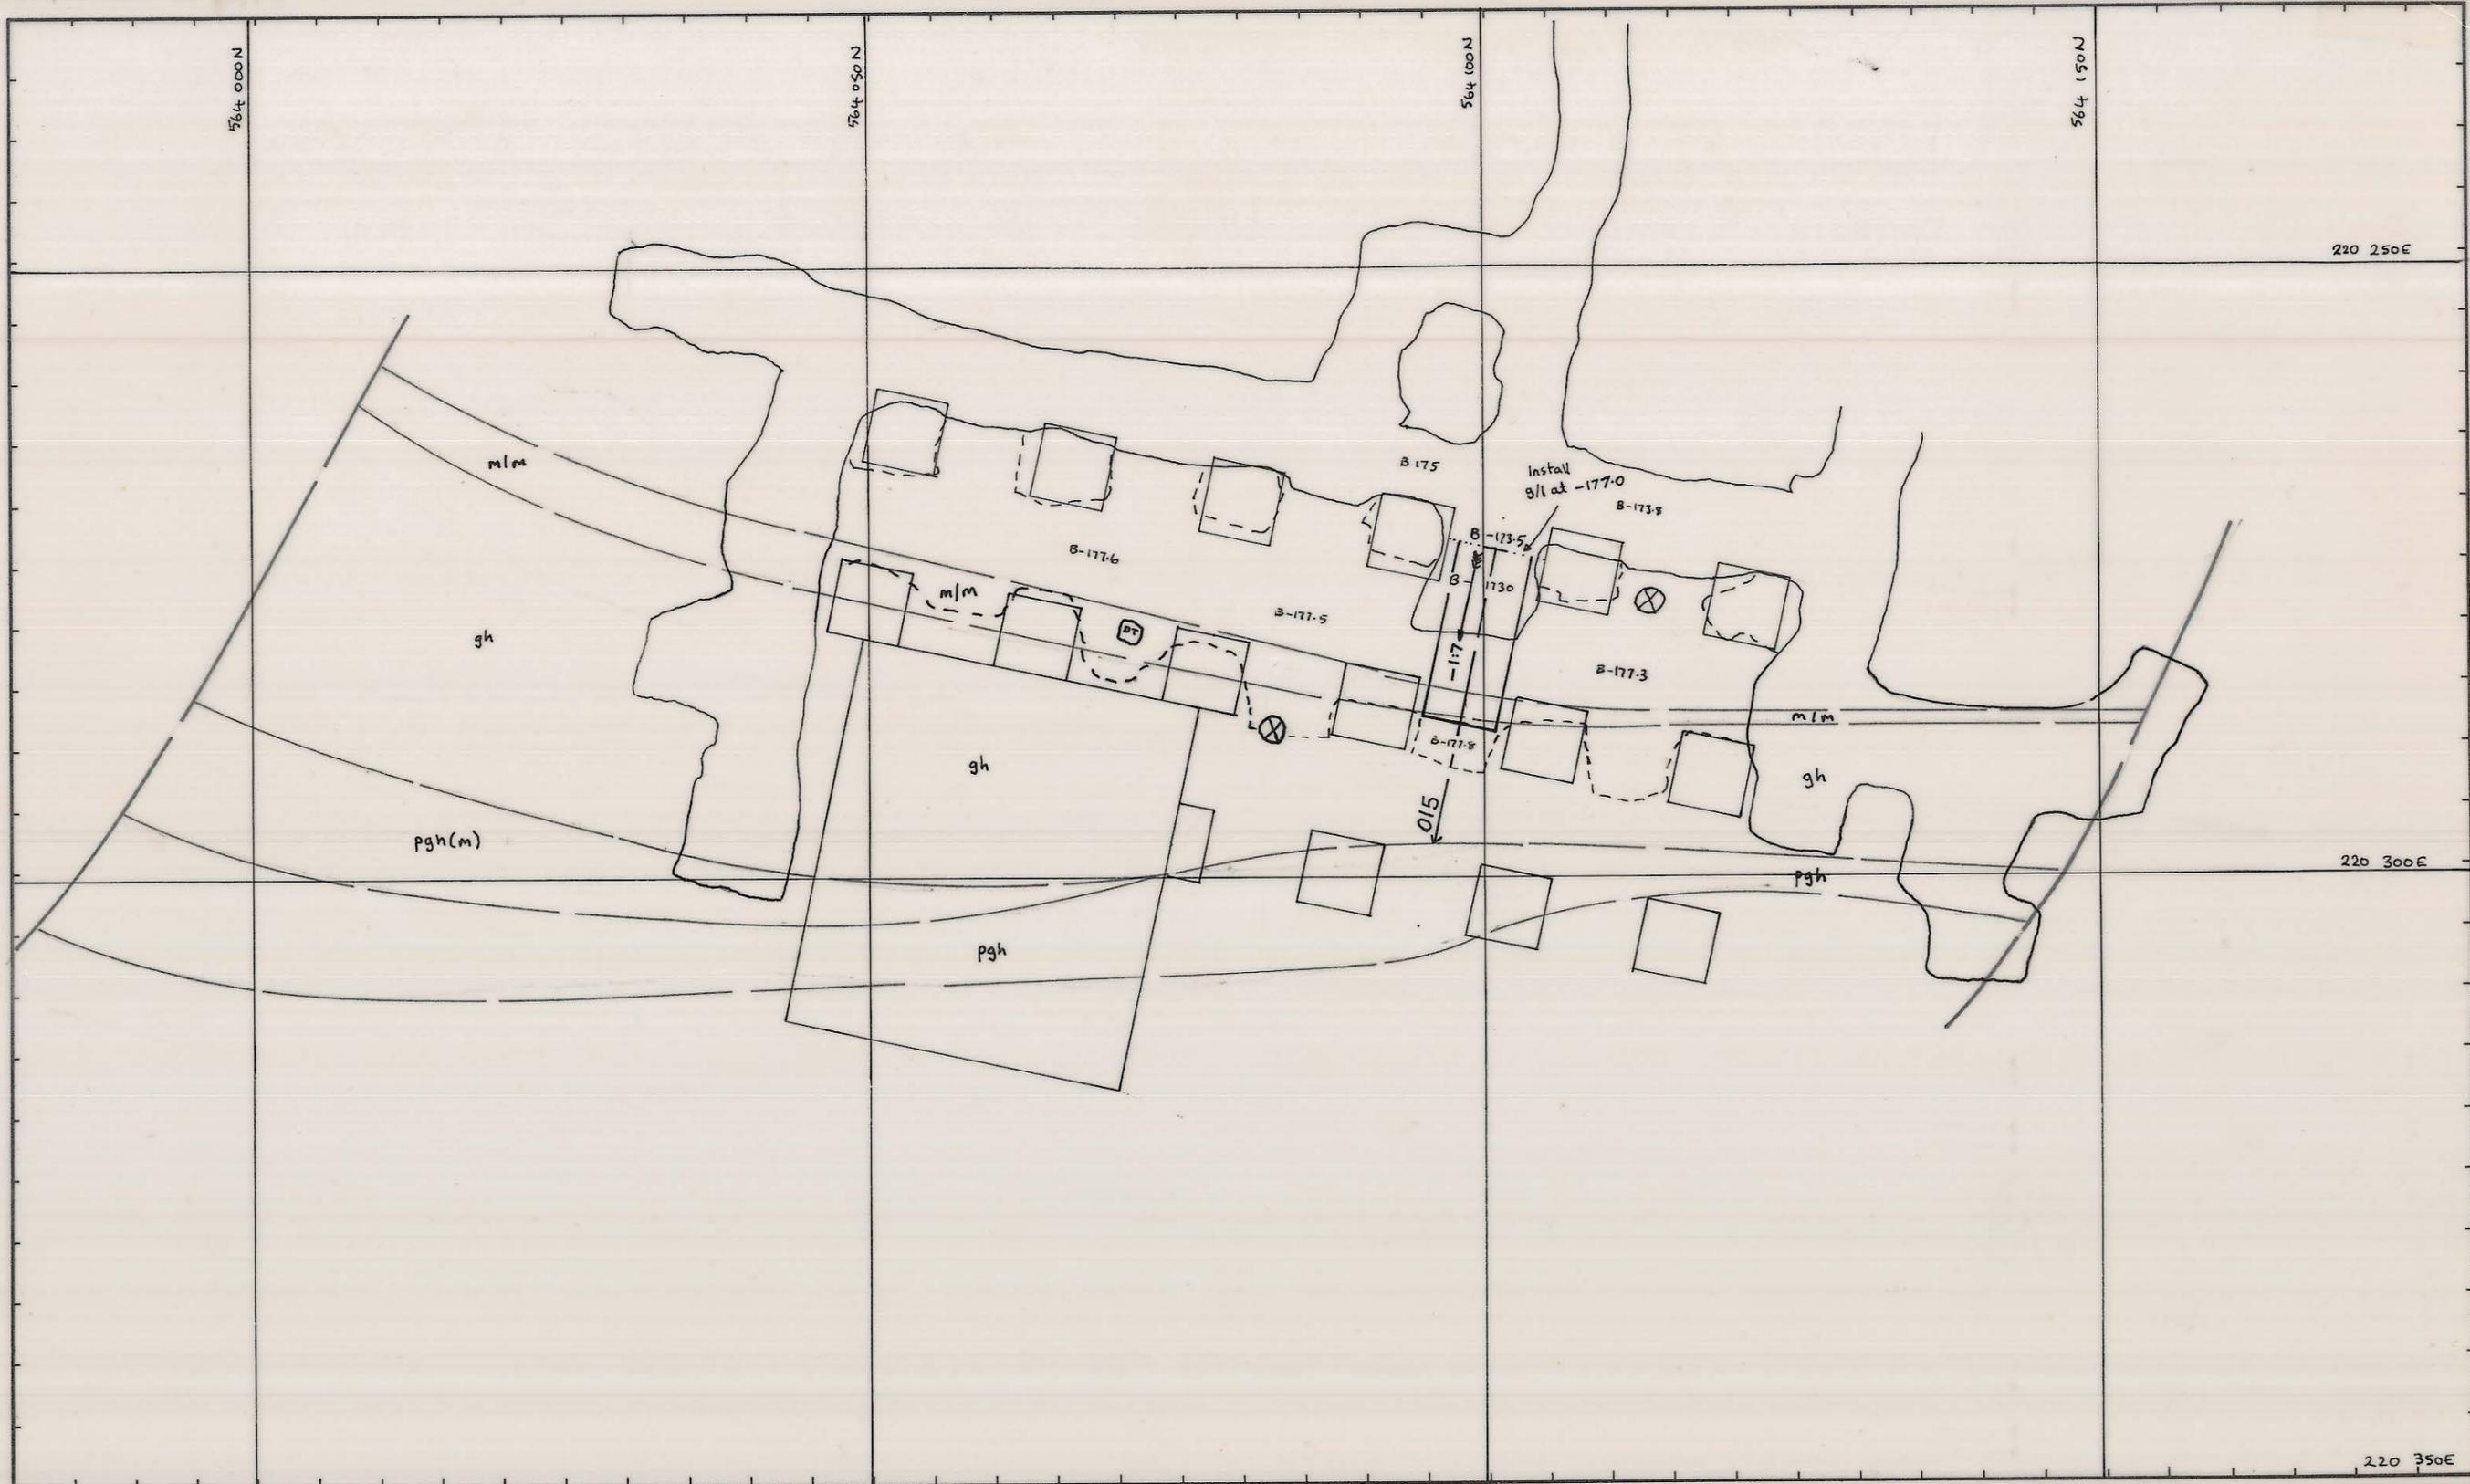

REF PLAN

Geology AT -175 m R.L.

Mining Supt *M.A.H.* 19-08-86

GEOLGY	AD7	19-8-86
SURVEY		
PLANNING	AD7	19-8-86
ROCK MEC.		
GRADE CON.		
DRAFTING		
T.S.S.		

SCALE 1:500

KIS KING ISLAND SCHEELITE GRASSY KING ISLAND

015 RAMP EXTENSION

DRAWING NUMBER

03 DM 04 - 3035