



5 cm

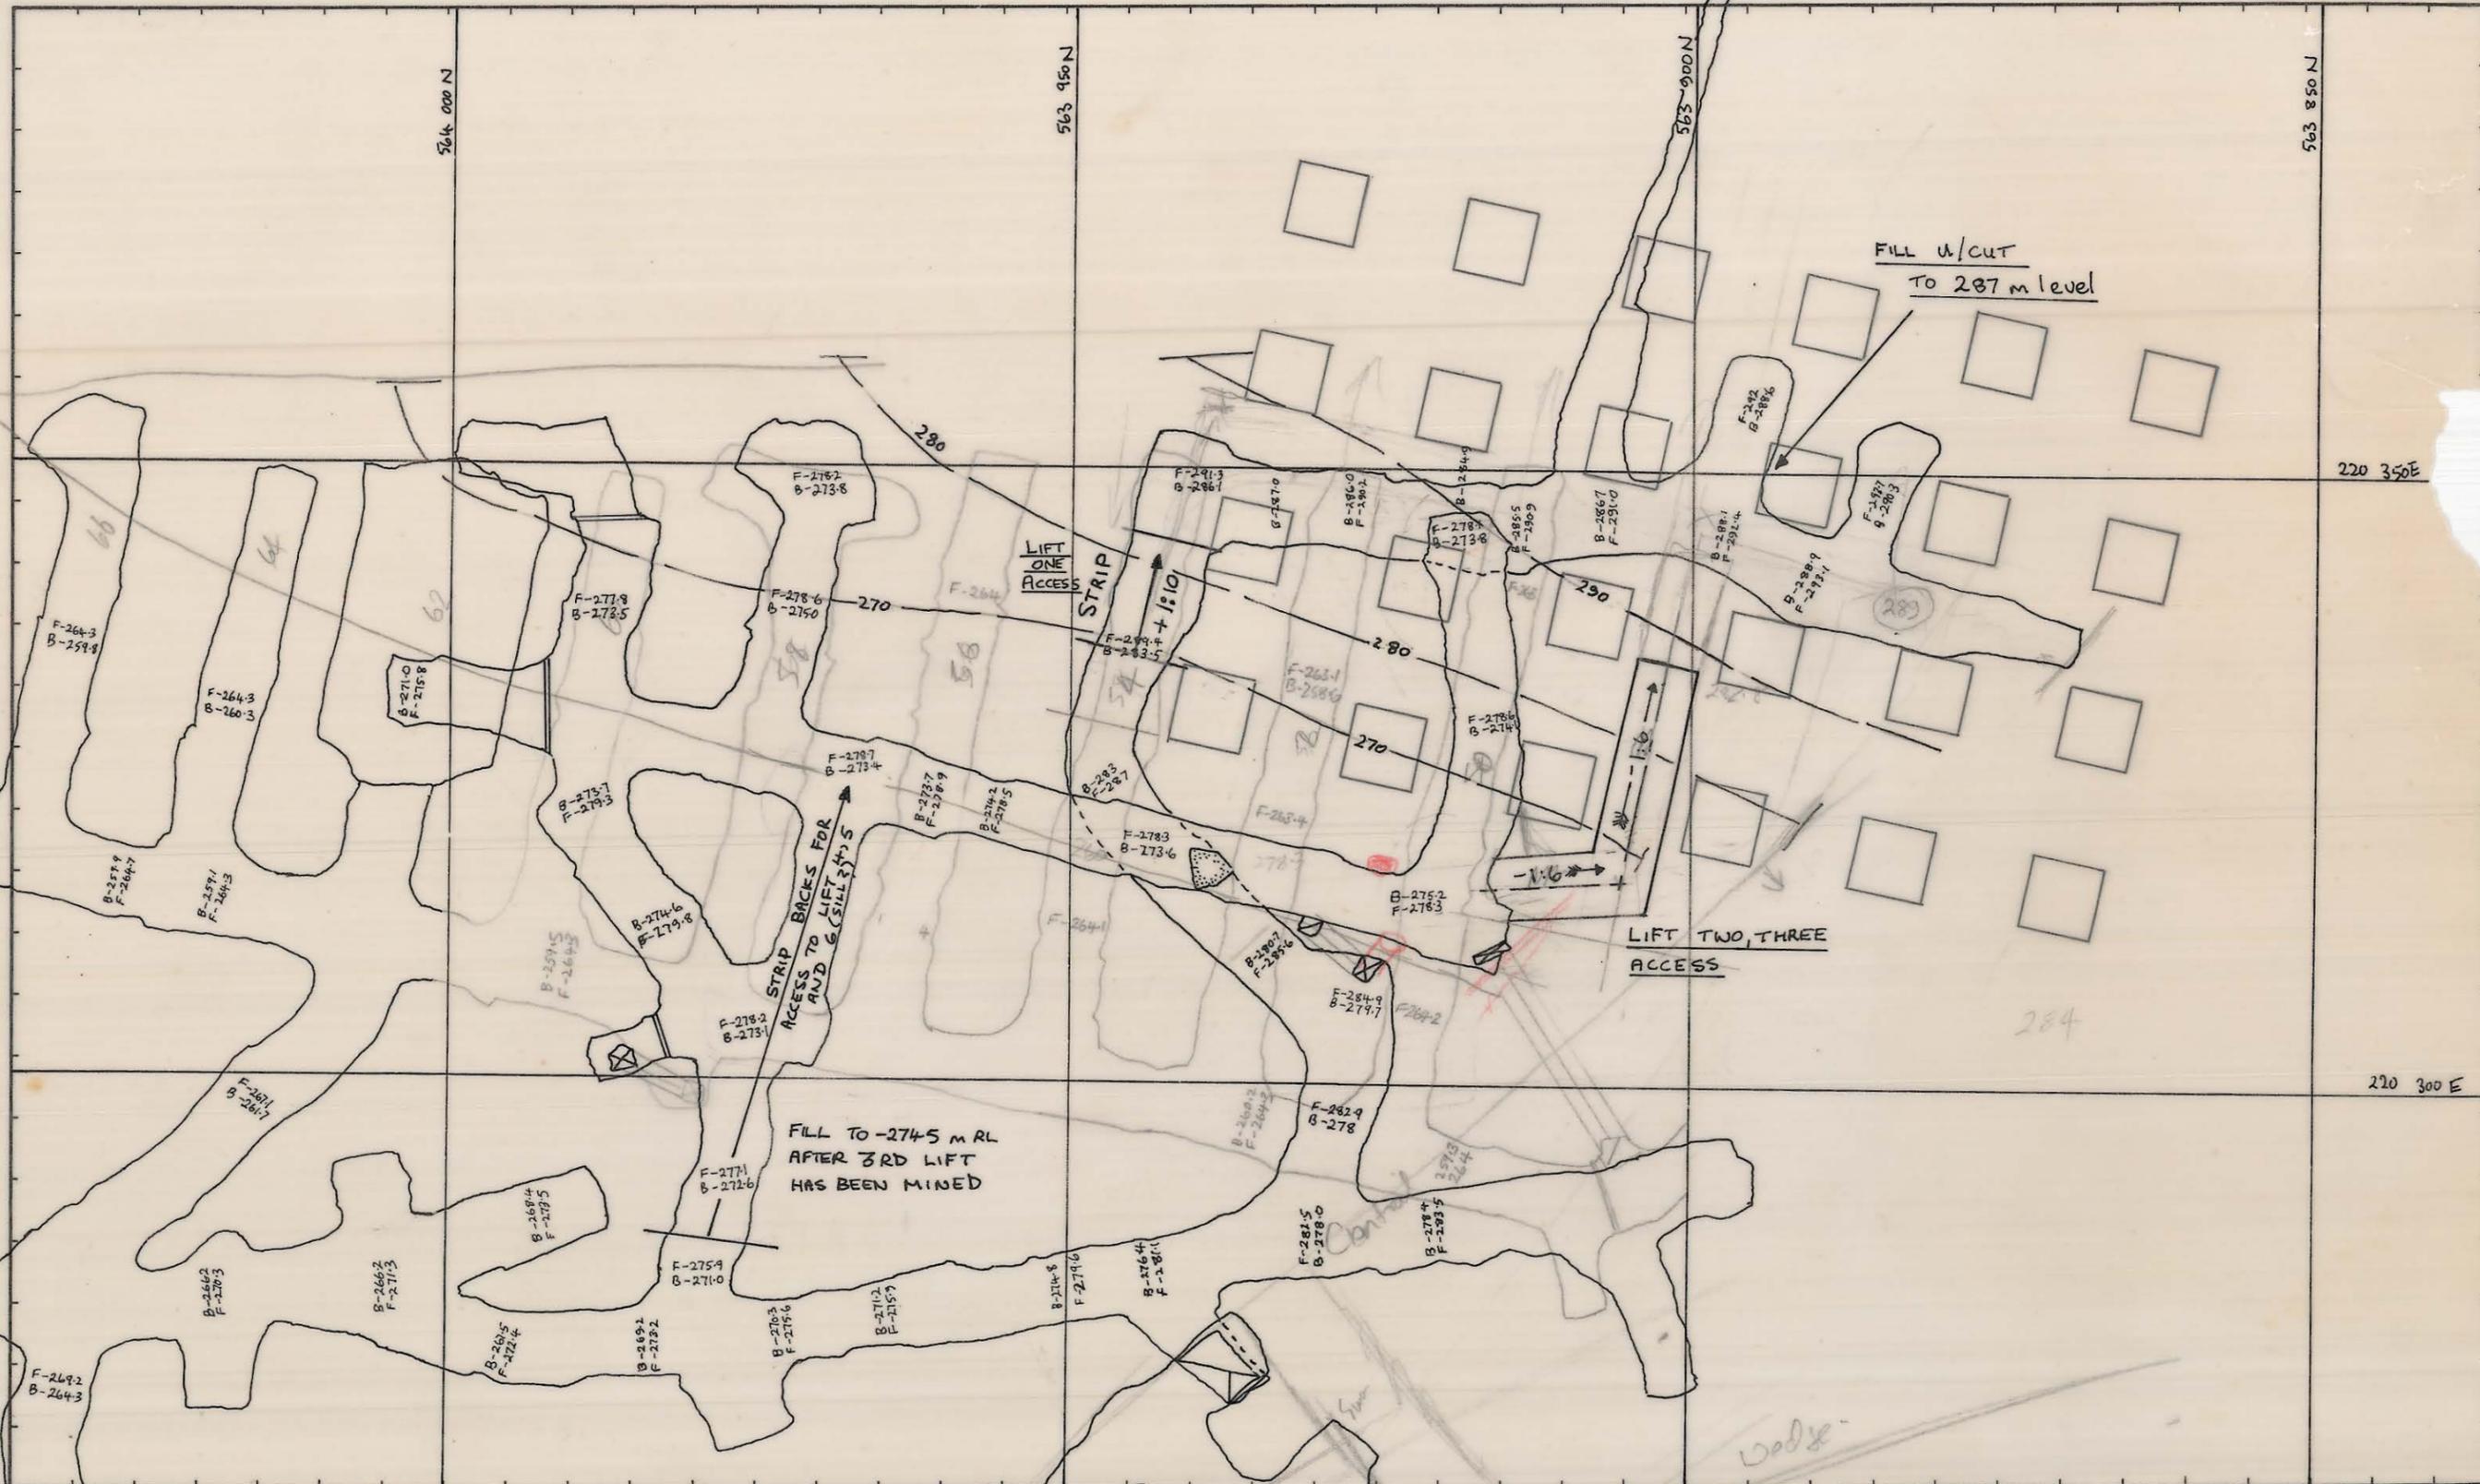

LIFT	FLOOR	BACK	FILL TO	COMMENTS
u/c	293	286	287	Tight fill lower areas
1	287	282.5	283	-
2	283	278.6	278.6	Tight fill to existing 280L
3	278.6	274	274.5	Fill all 280 m Level
4	274.5	270.5	271.5	-
5	271.5	267	-	-
6	268	264	-	Sill Bench to 264 L

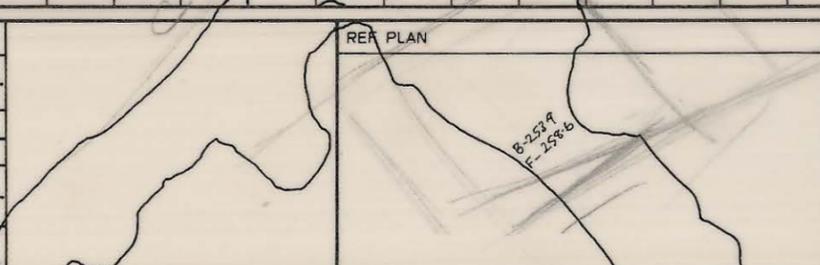

GEOLOGY	ADT	14-2-86
SURVEY		
PLANNING	ADT	14-2-86
ROCK MEC.	dkw	14.2.86
GRADE CON.		
DRAFTING		
T.S.S.		

SCALE 1:500

KIS KING ISLAND SCHEELITE GRASSY KING ISLAND

WEDGE REMNANT STOPING

ACCESS TO 260 m R.L.

DRAWING NUMBER
03 DM04 - 3033