


0374-259

04BH15-103-91

5 cm

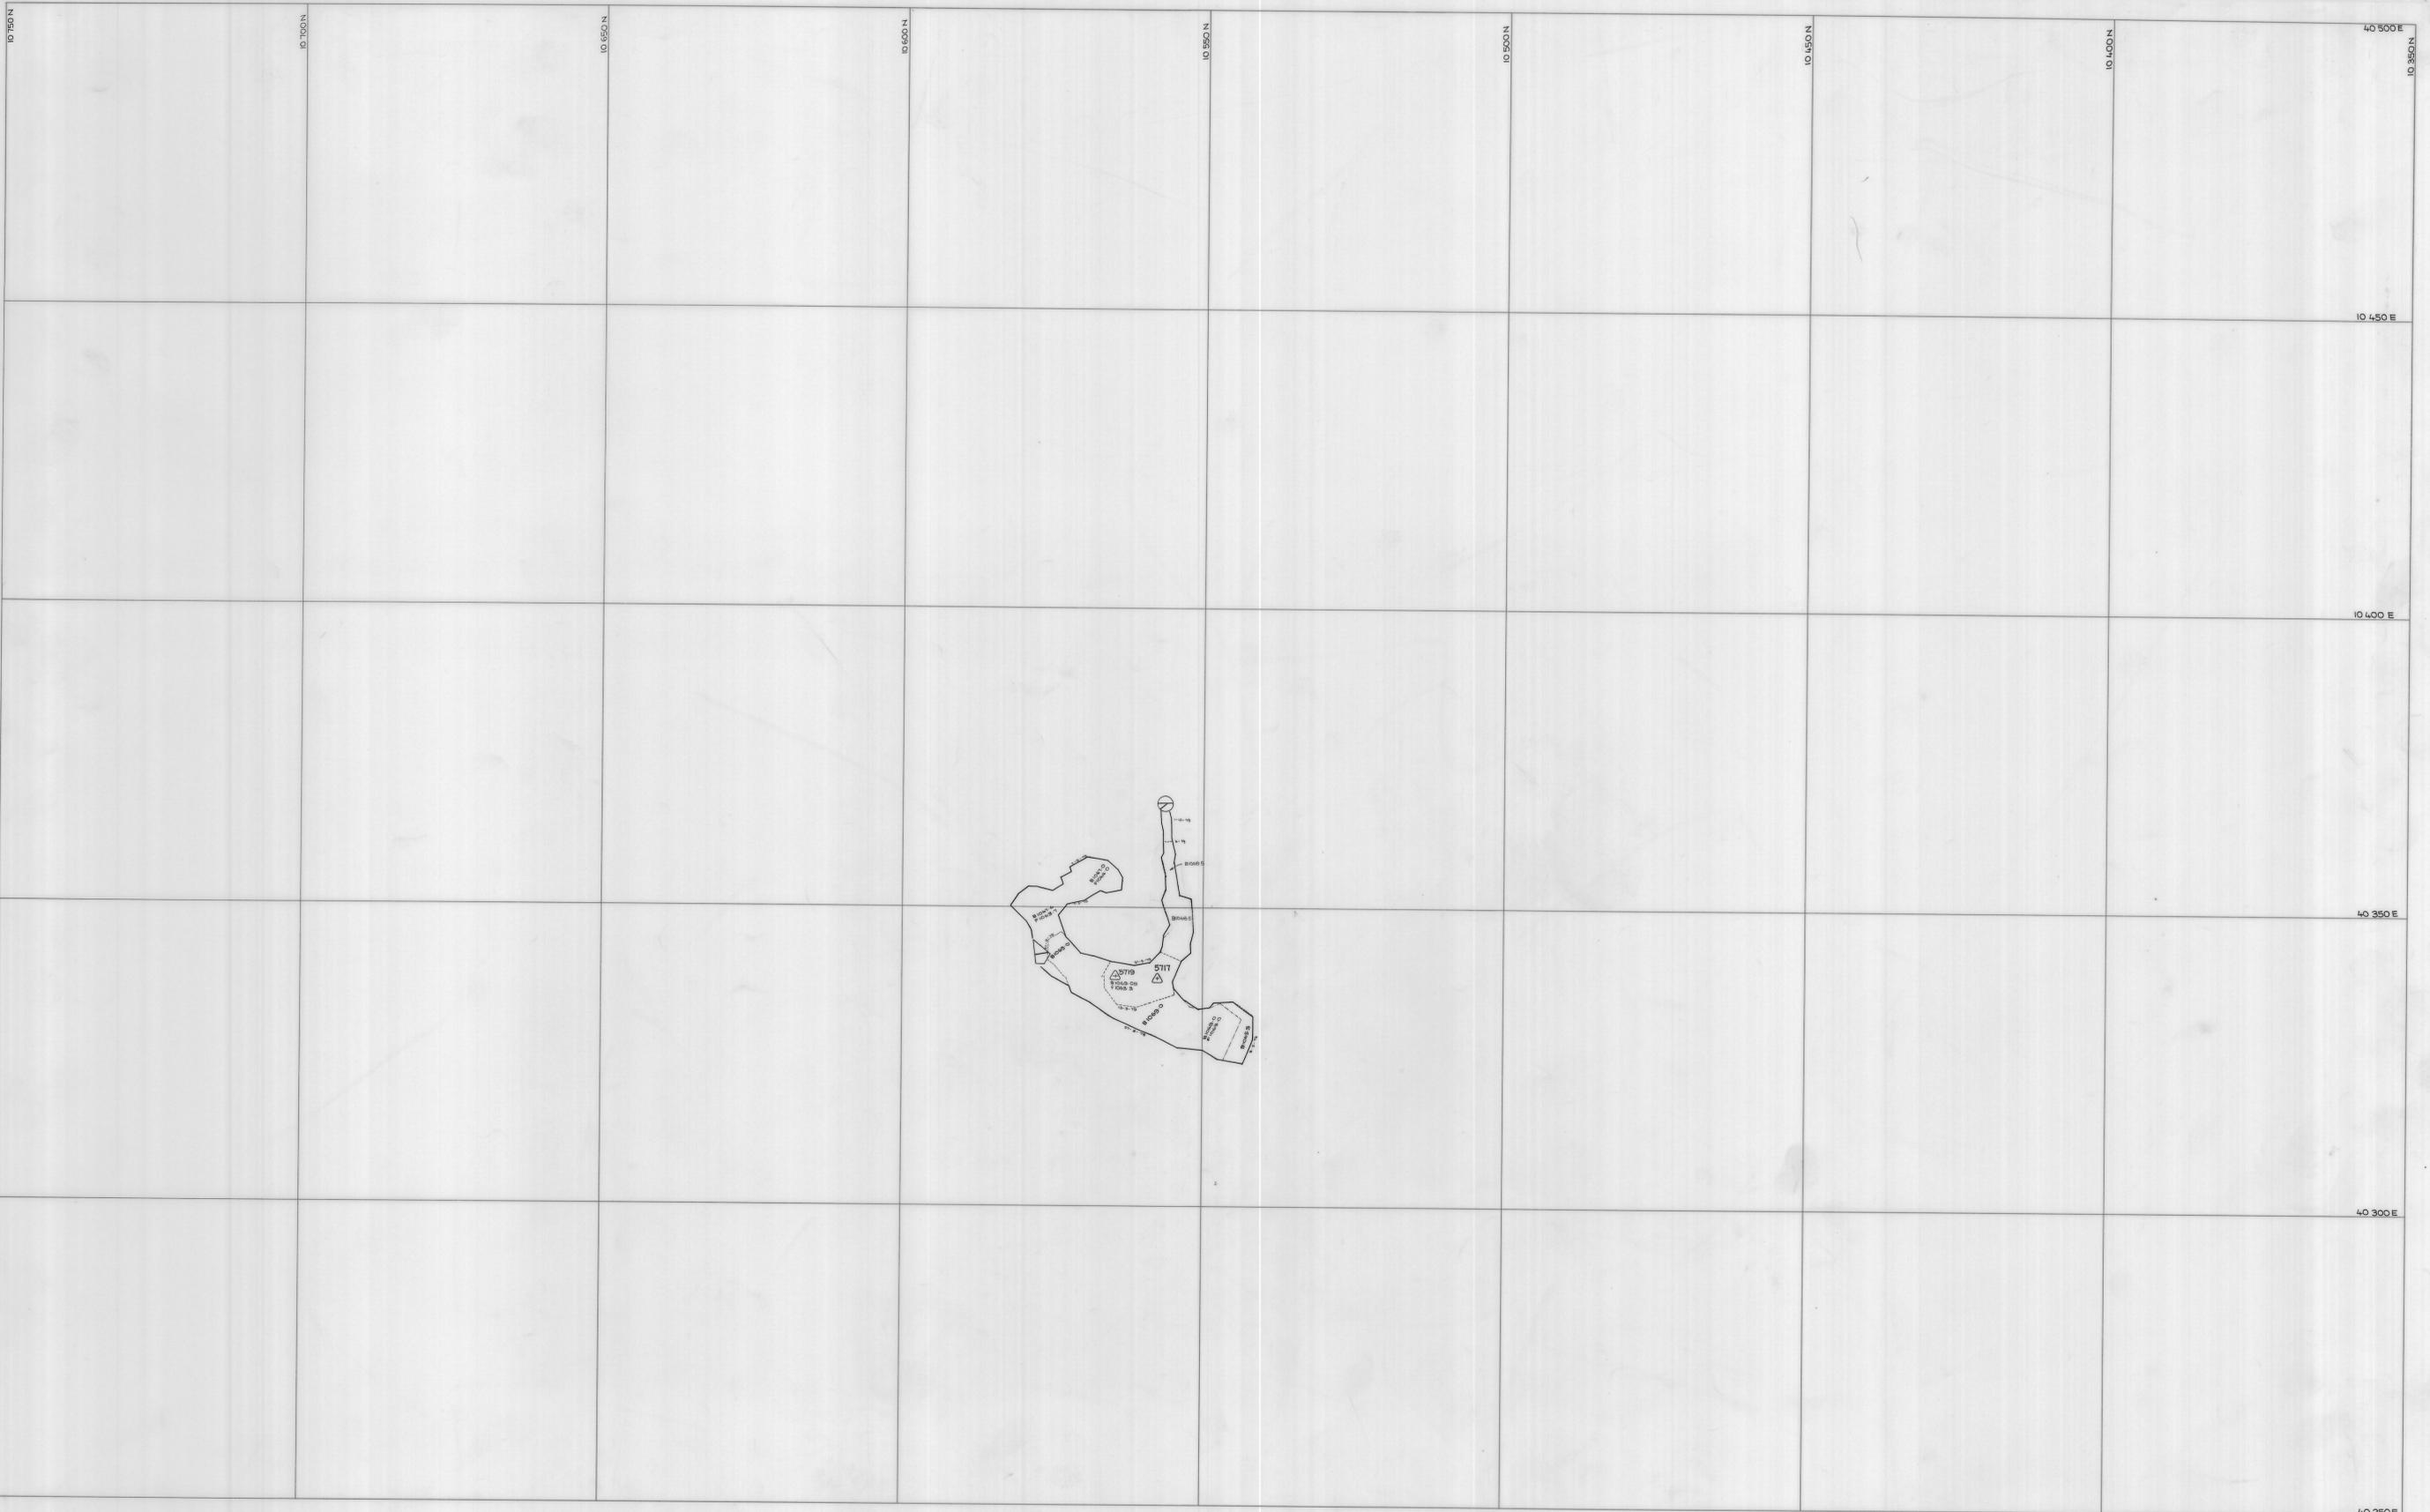

SCALE 1:500

LOCATION

BOLD HEAD MINE

SUBJECT

H 50
A LENS CAVO STOPE
[9th lift]

KIS KING ISLAND SCHEELITE
A DIVISION OF WARRAN INTERNATIONAL

GRASSY KING ISLAND

PLAN NUMBER 03-91
04BH15 - 103 - 91

north