


5 cm

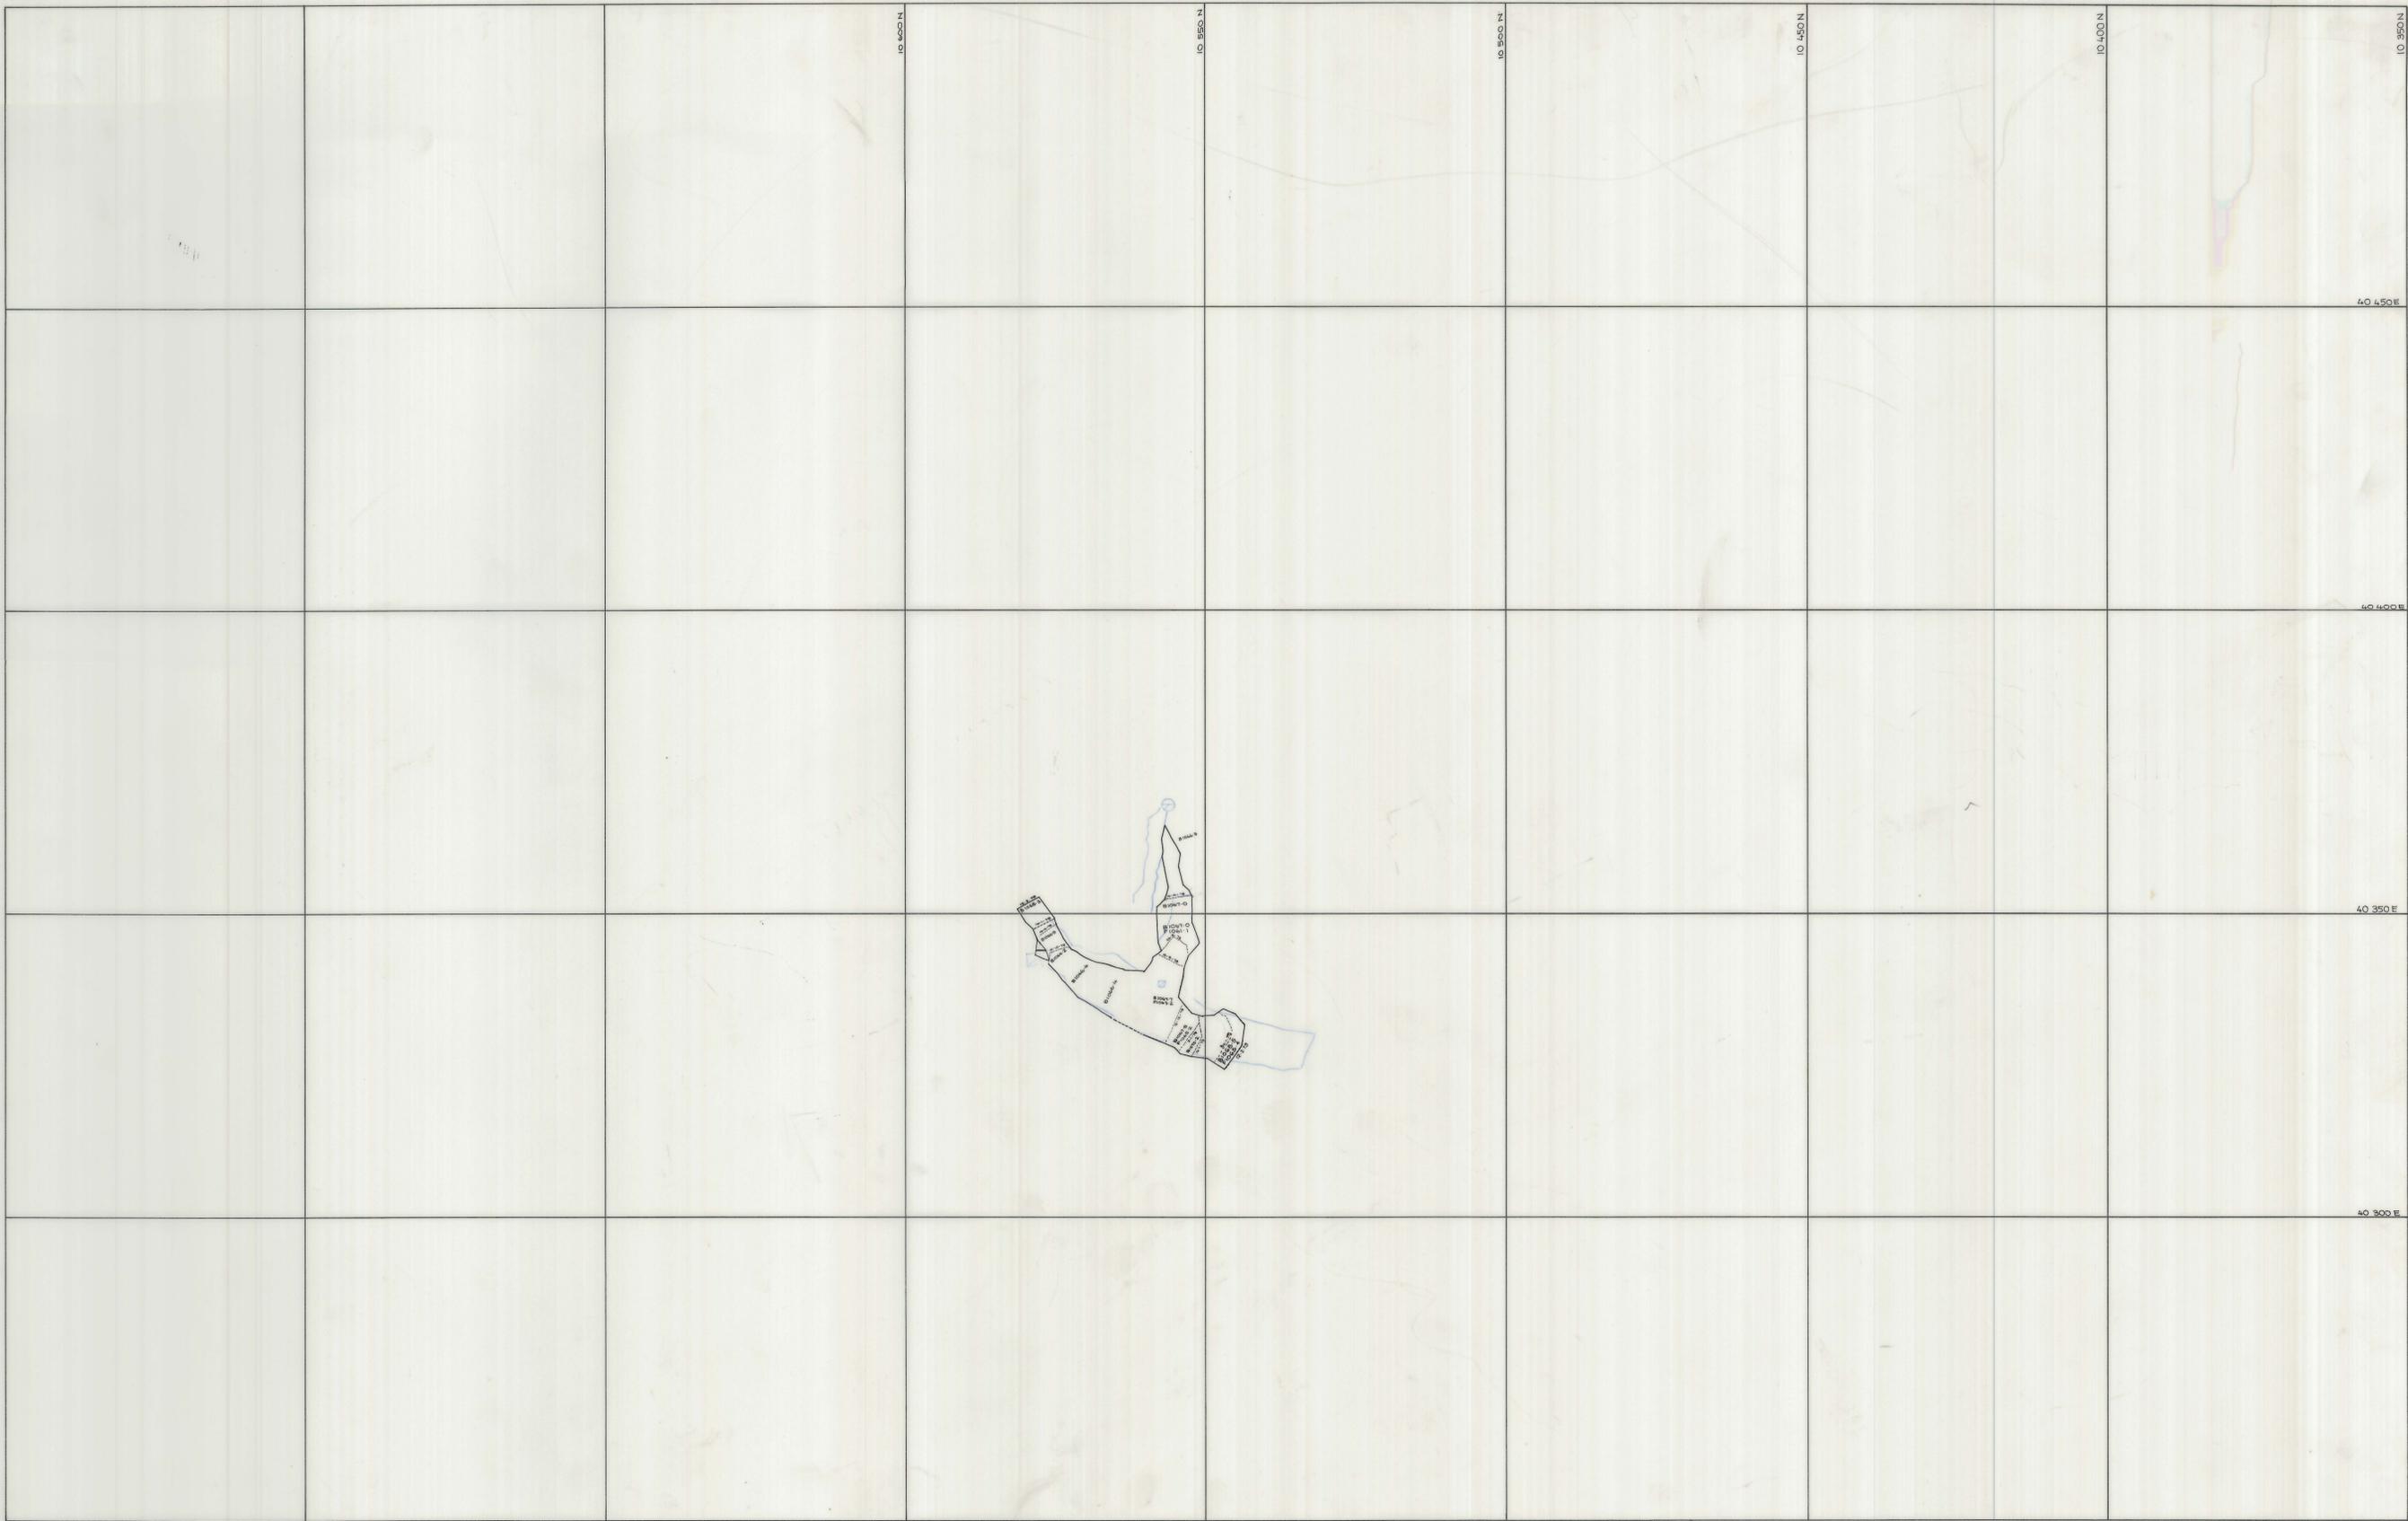

	SCALE 1: 500	LOCATION BOLD HEAD MINE	
		SUBJECT H 50 A LENS CAVO STOPE [ 8th Lift]	