
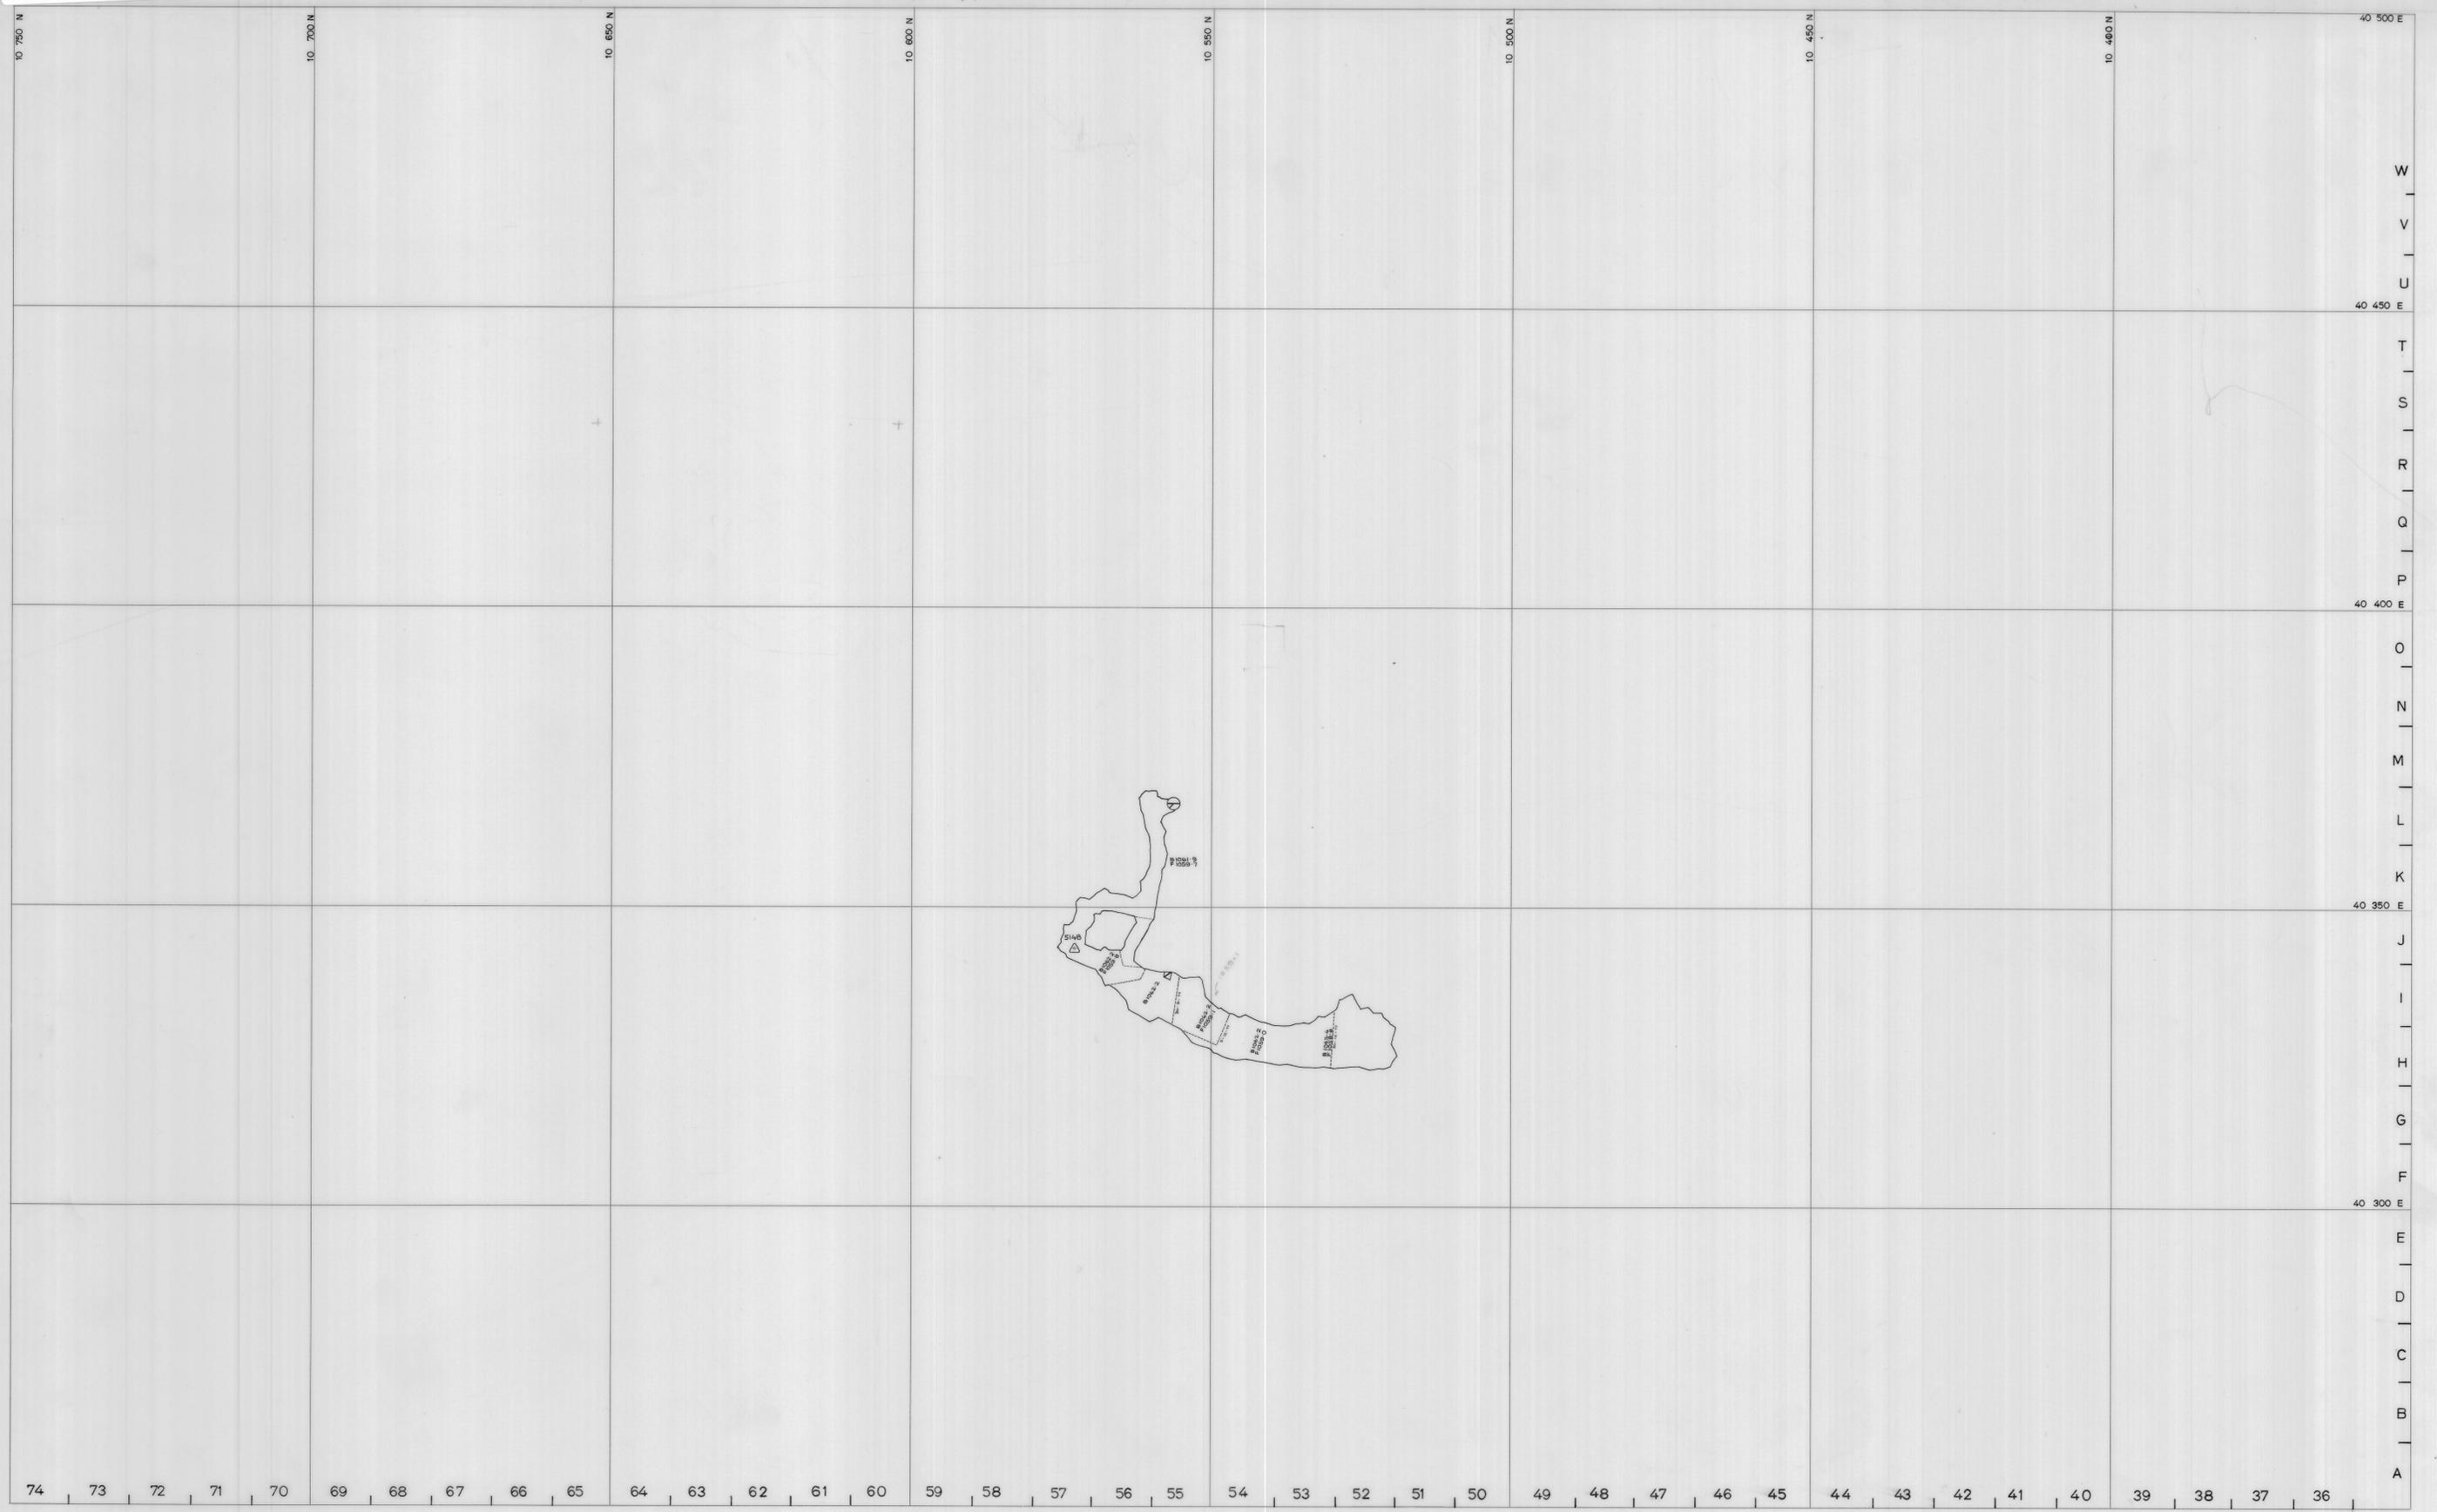


0374 - 262

04BH15-103-94

H50  
6th  
LIFT

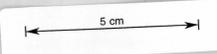

74 73 72 71 70 69 68 67 66 65 64 63 62 61 60 59 58 57 56 55 54 53 52 51 50 49 48 47 46 45 44 43 42 41 40 39 38 37 36

A B C D E

	<p>SCALE 1 500</p>	<p>LOCATION BOLD HEAD MINE</p> <p>SUBJECT H 50 A LENS CAVO STOPE [6th Lift]</p> <p>north</p>	 <p>KING ISLAND SCHEELITE A DIVISION OF WARMAN INTERNATIONAL</p> <p>GRASSY KING ISLAND</p> <p>PLAN NUMBER 04BH15-103-94</p>
--	--------------------	--	--