
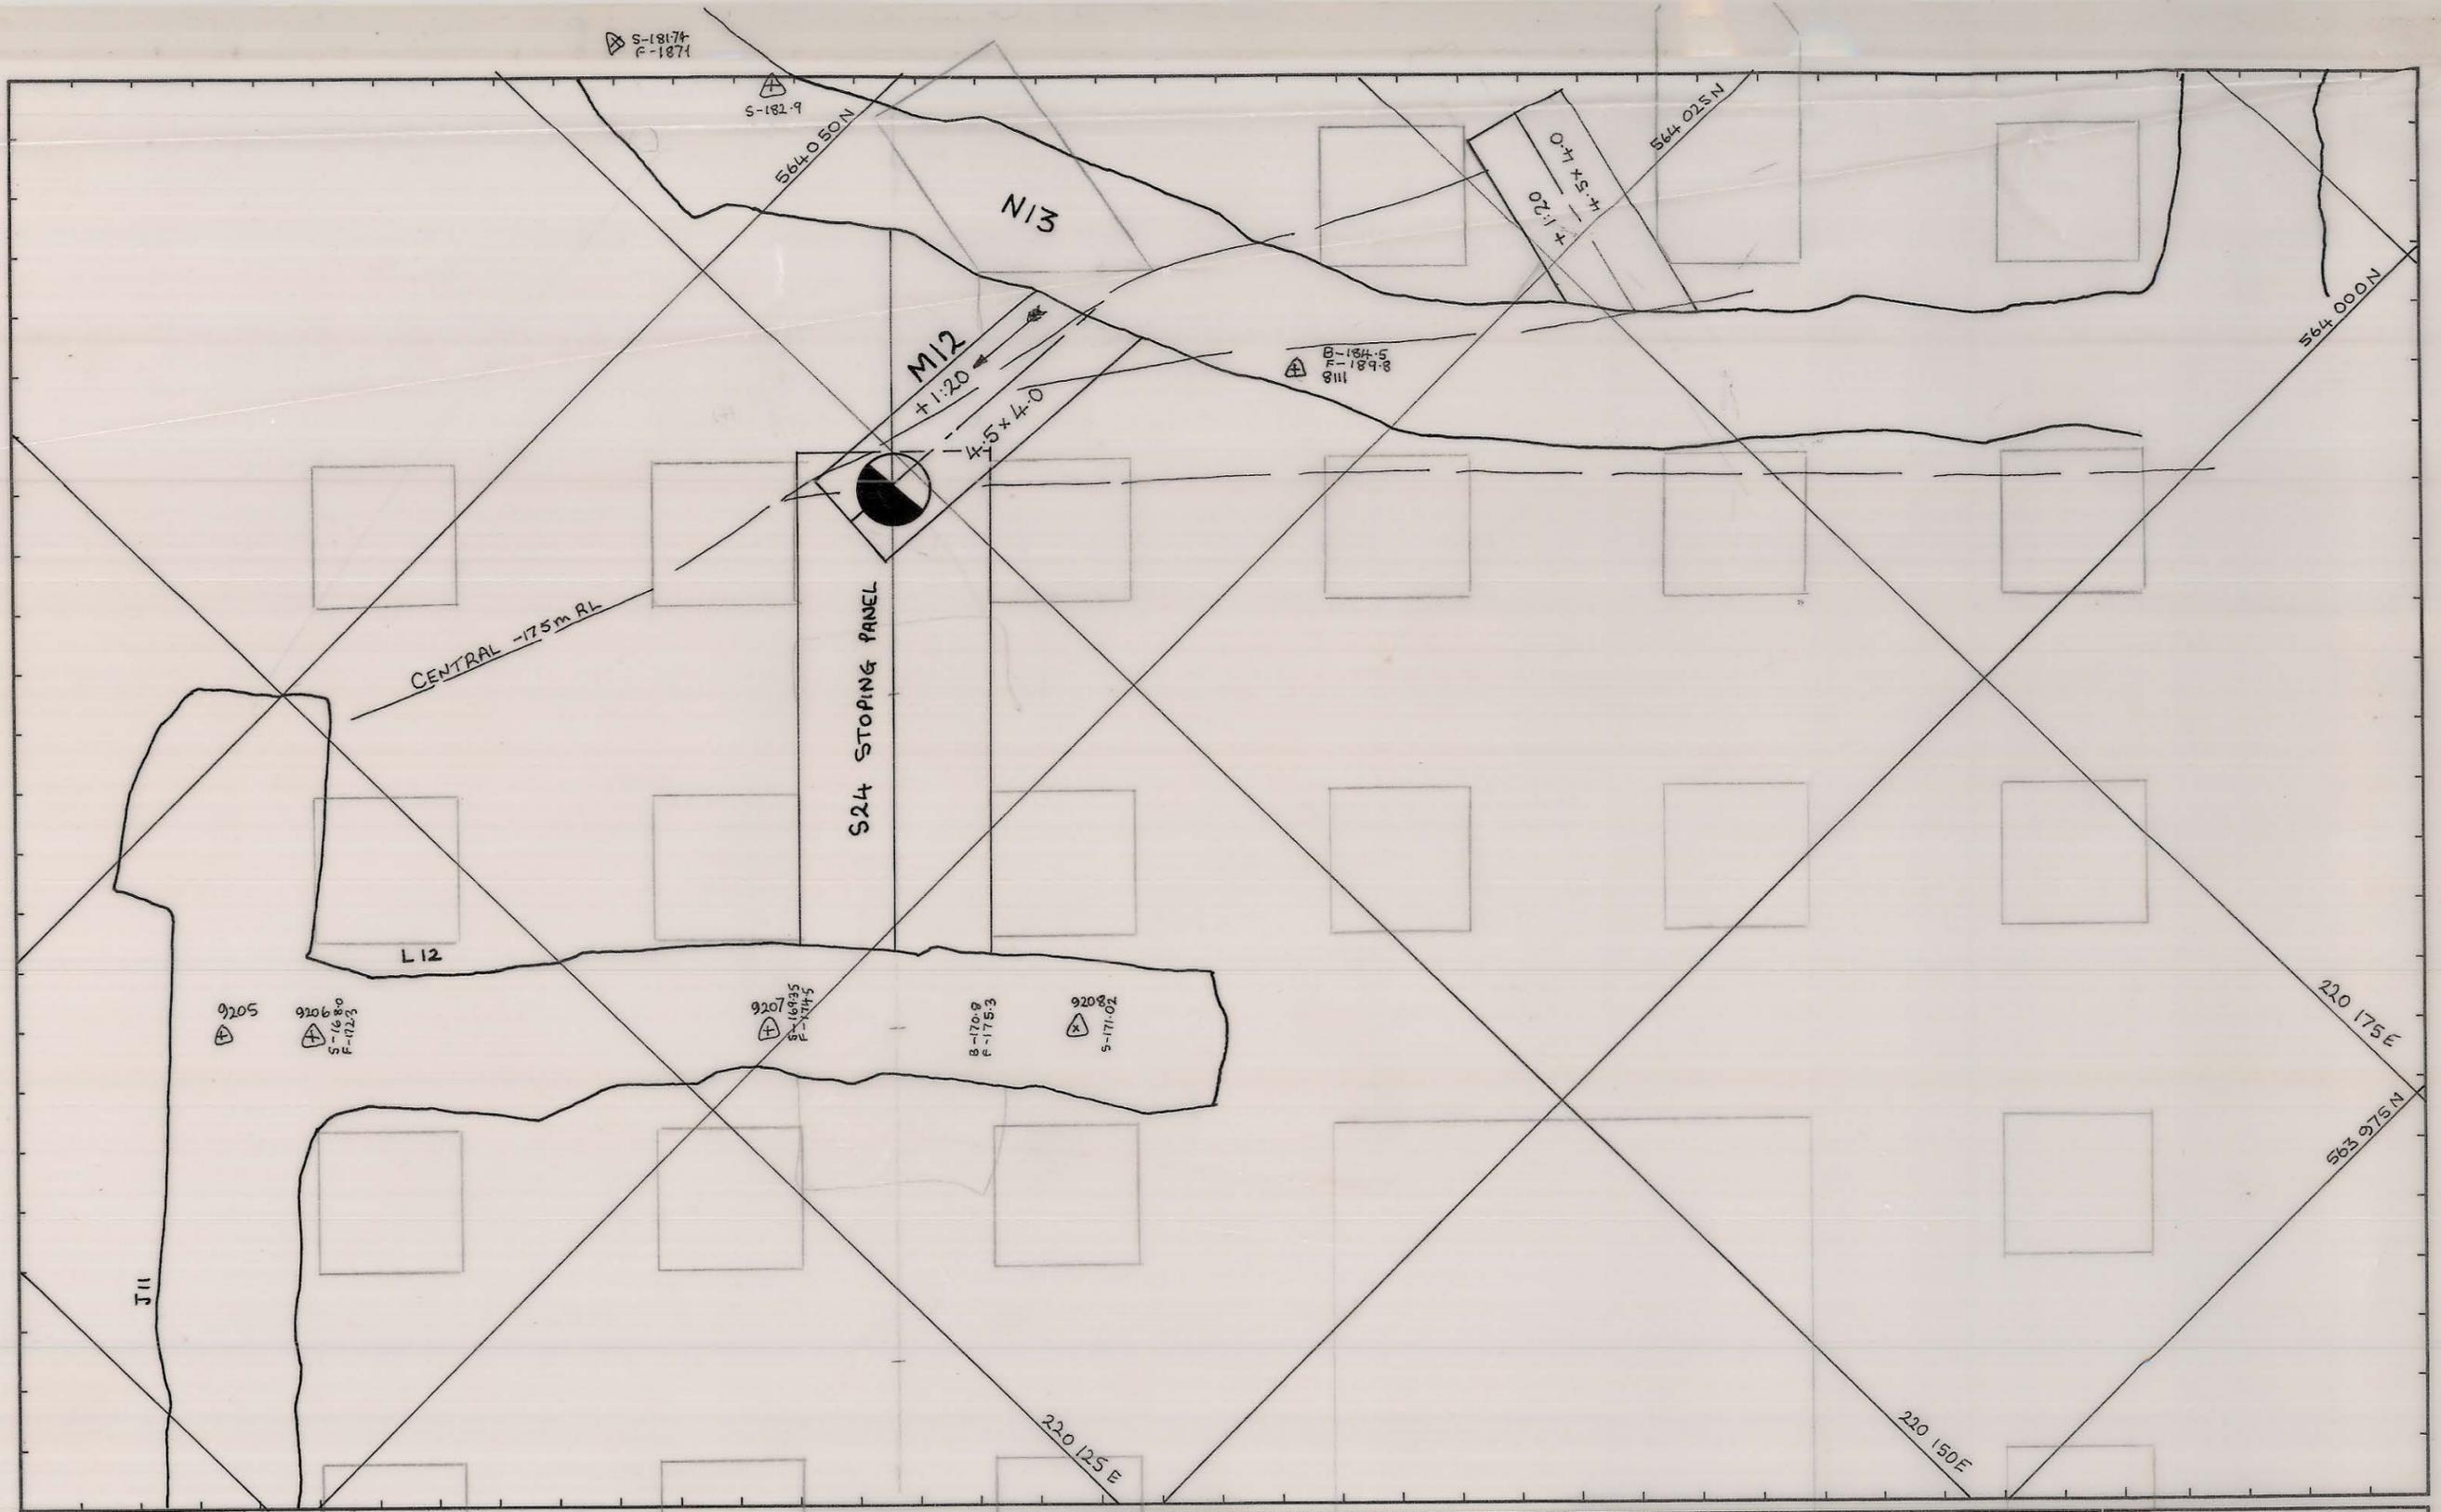


03DM06-3001

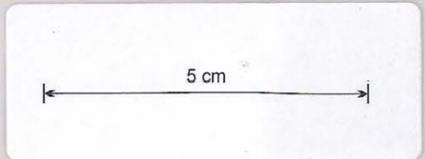

REF PLAN  
 Mining Supt: *Mark Daly* 08/07/85

GEOLOGY		
SURVEY		
PLANNING	ADT	26-6-85
ROCK MEC.		
GRADE CON.		
DRAFTING		
T.S.S.		

SCALE 1: 250

**KIS** KING ISLAND SCHEELITE  
GRASSY KING ISLAND

**M12 OREPASS**  
**LOWER PIT**

DRAWING NUMBER  
03 DM 06 - 3001