


03 DM 05 4011

0374_2630

5 cm

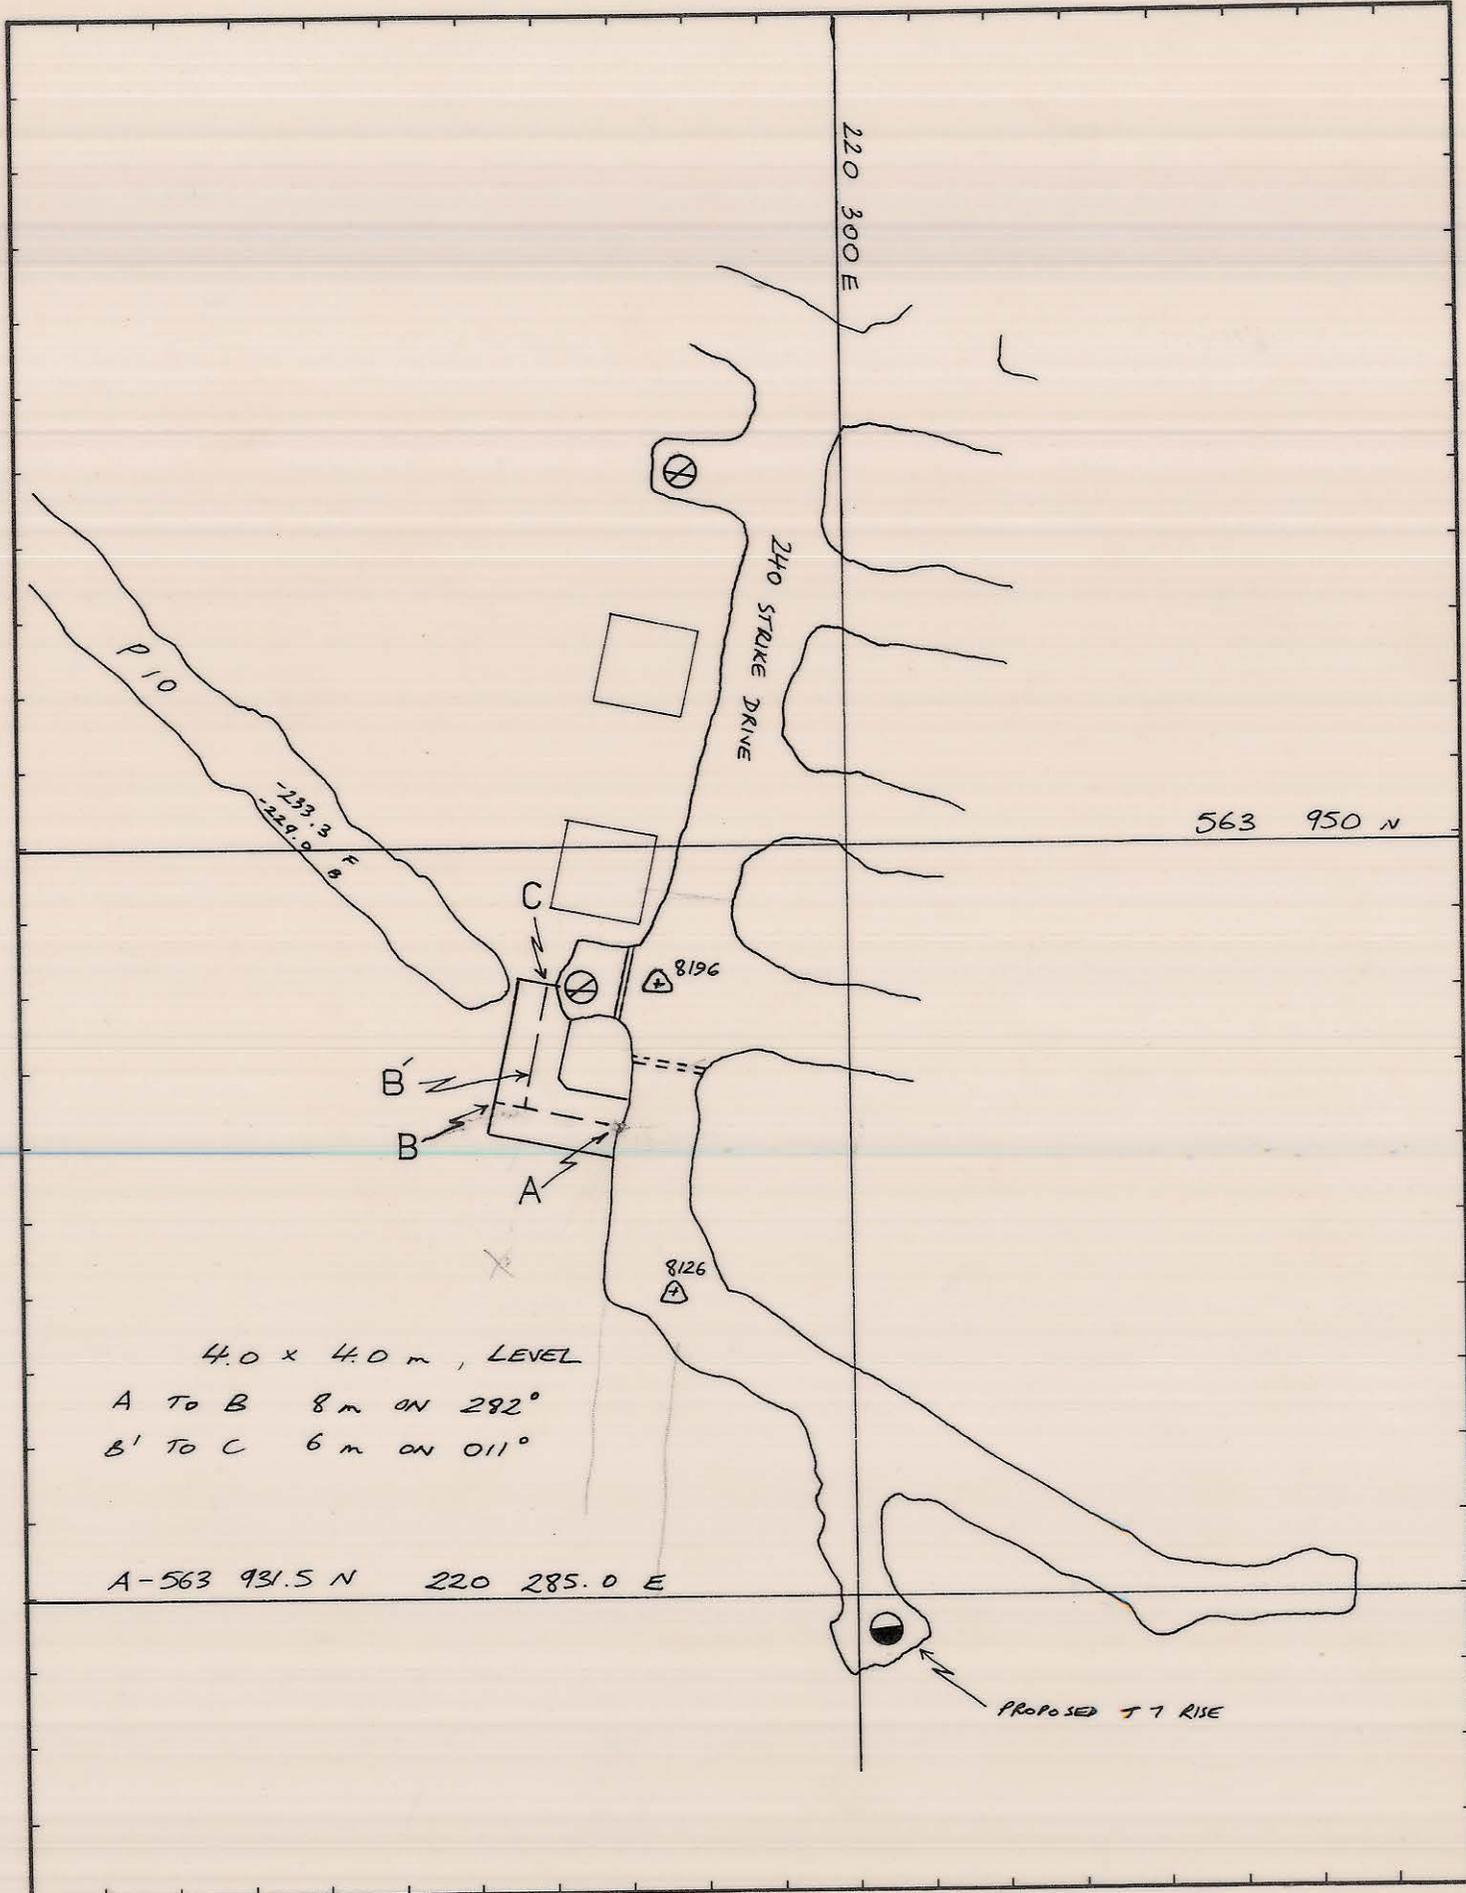

4.0 x 4.0 m , LEVEL
 A TO B 8 m ON 292°
 B' TO C 6 m ON 011°

A-563 931.5 N 220 285.0 E

REF PLAN

GEOLOGY

SURVEY

PLANNING

ROCK.MEC.

GRADE CON.

DRAFTING

T.S.S.

1:500
SCALE



KING ISLAND SCHEELITE
GRASSY KING ISLAND

EXHAUST BY-PASS

T7 TO S8 UPGRADE BOREHOLES

DRAWING NUMBER

03 DM 05 4011