


27 JUN 1981

03 DM 05 - 3003

D14 BOREHOLE EXHAUST

0374_2634

5 cm

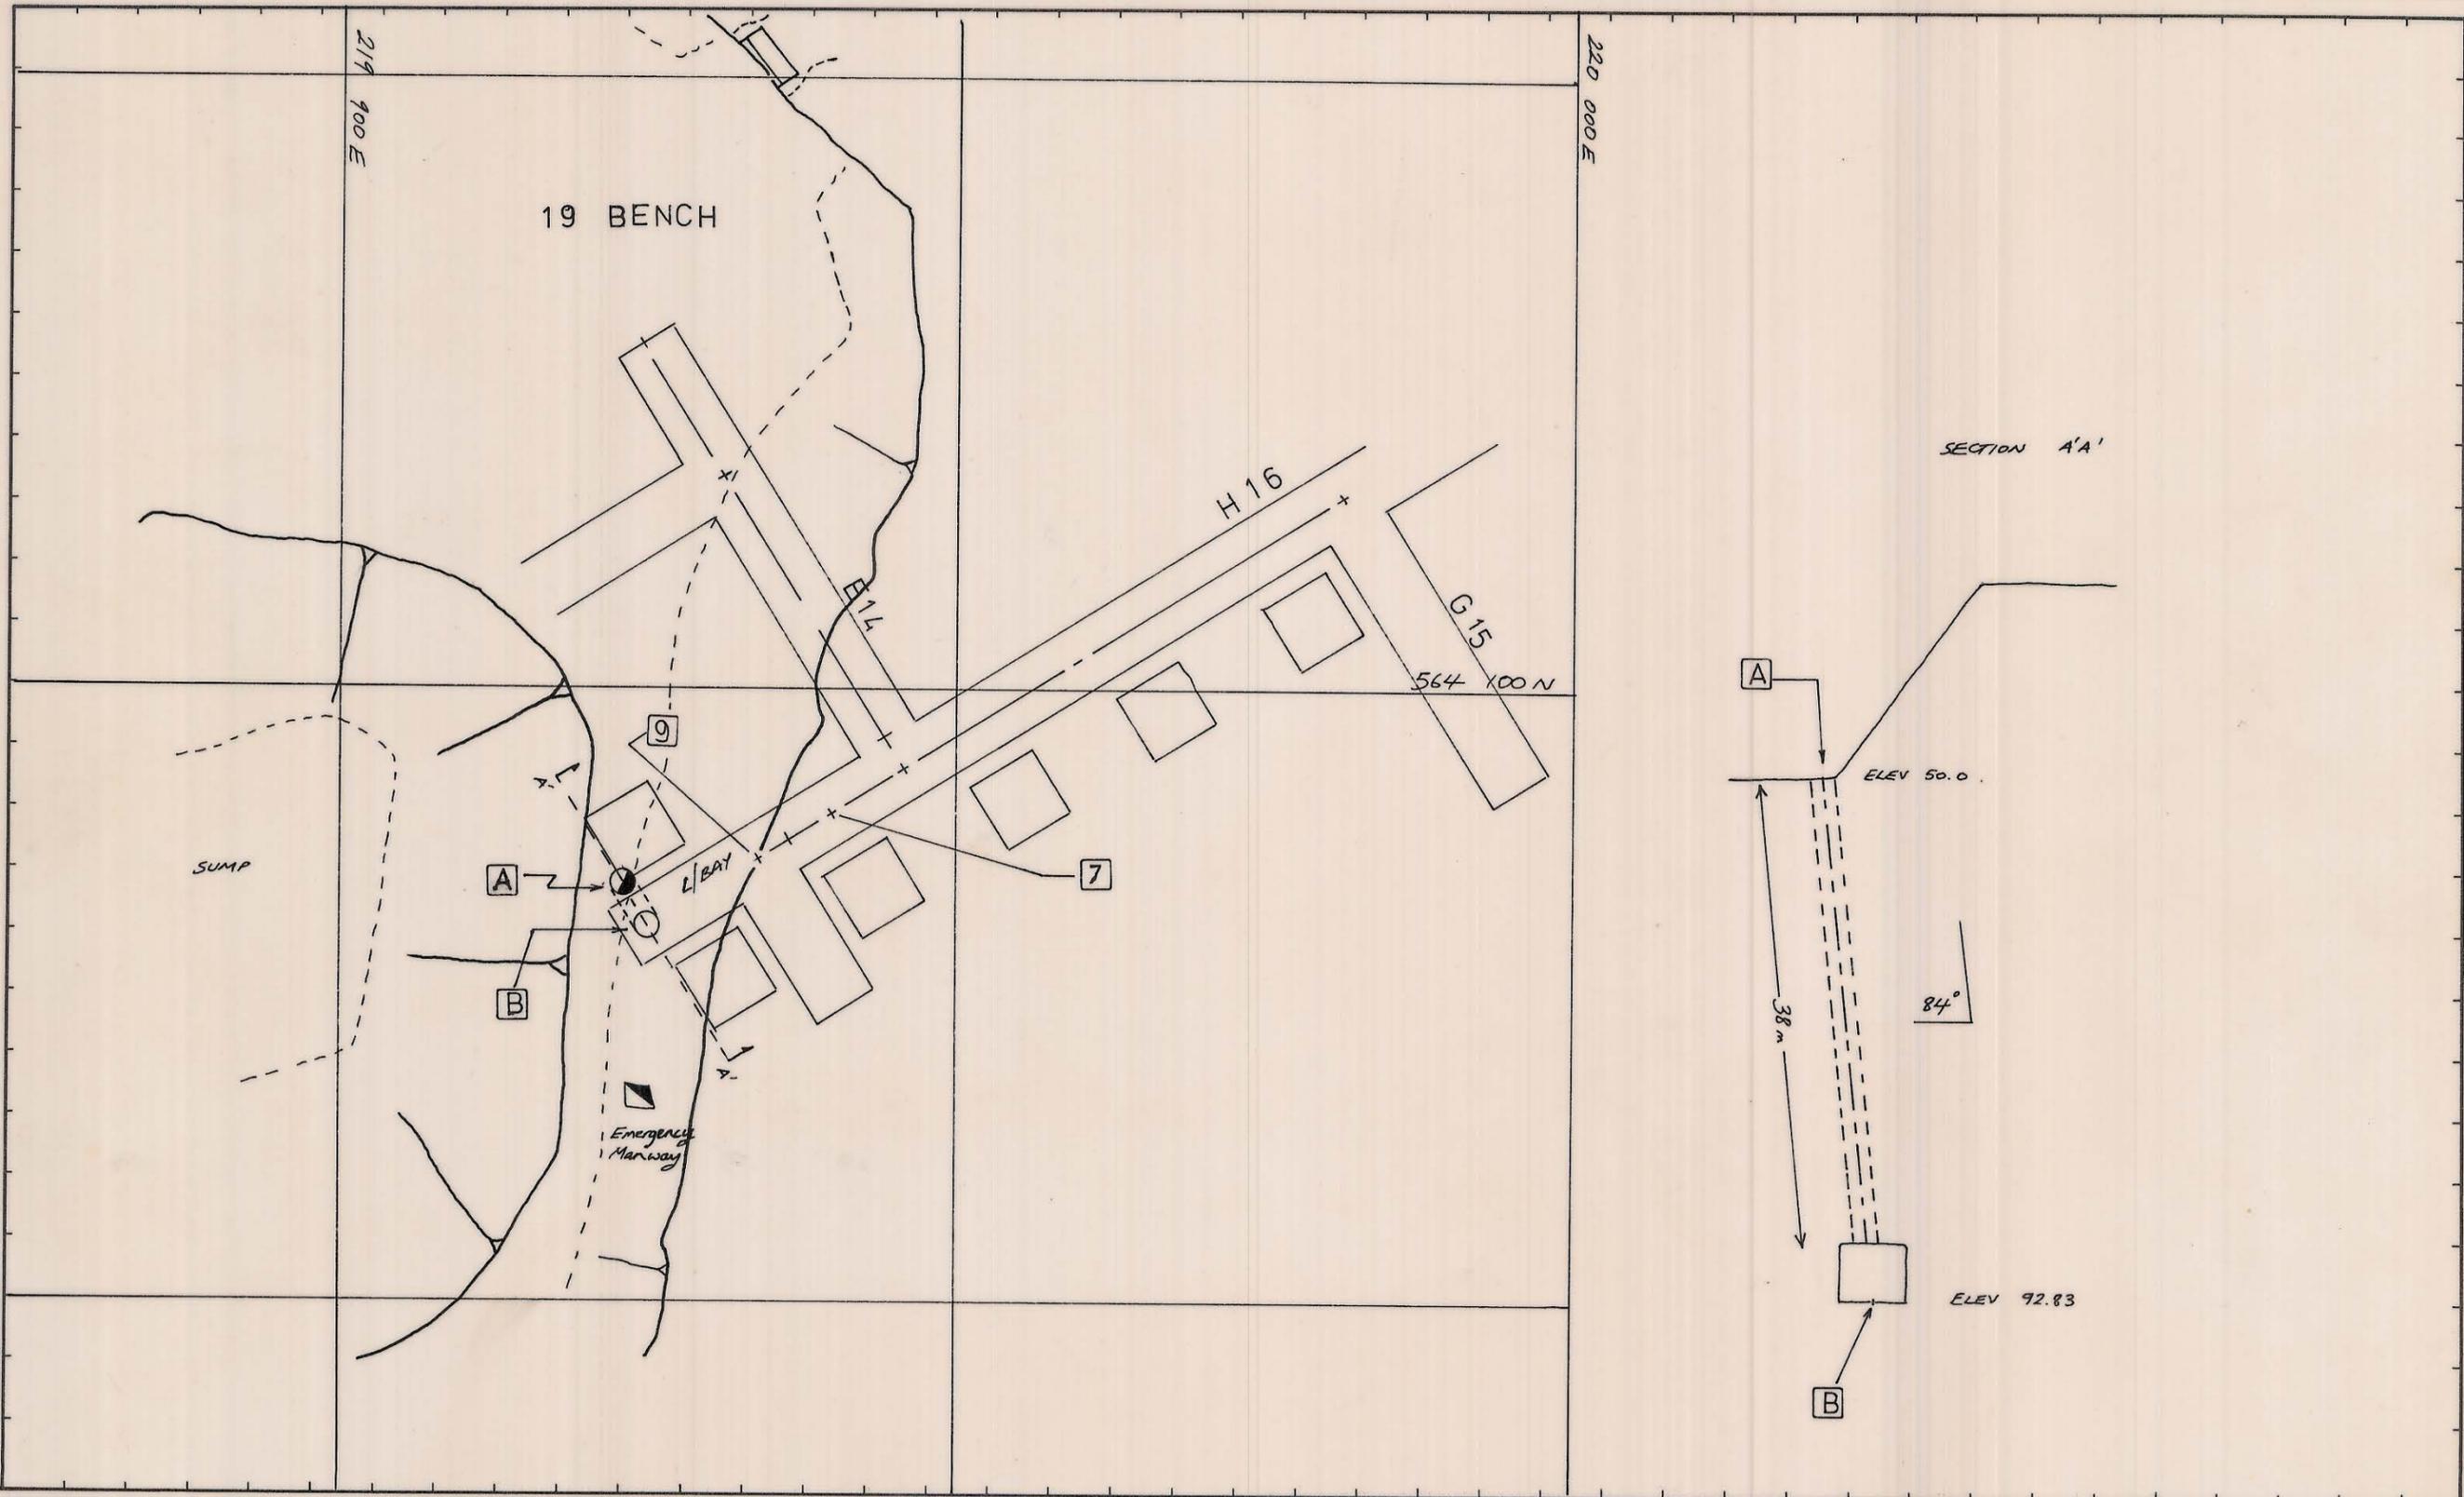

POINT	N	E	R.L.
7	564 089.83	219 939.69	B. F. -74.22
9	564 086.12	219 933.75	B. -88.03 F. -92.83
A	564 084.00	219 923.00	A -50.00
B	564 080.50	219 925.00	R -92.83

REF PLAN 044003 - 0097 OPEN CUT
FOR H 16 DEVELOPMENT SEE
03 DM 03 - 1019

GEOLOGY	RES P.	L. G. 2
SURVEY		
PLANNING	MR.	27.10.80
ROCK MEC.		
GRADE CON.		DOLPHIN SURF.
DRAFTING		
T.S.S.	24C	27/10/80

SCALE 1:500
KIS KING ISLAND SCHEELITE GRASSY KING ISLAND
UPPER PIT SLOPE
VENTILATION BORE HOLE D 14
DRAWING NUMBER 03 DM 05 - 3003