
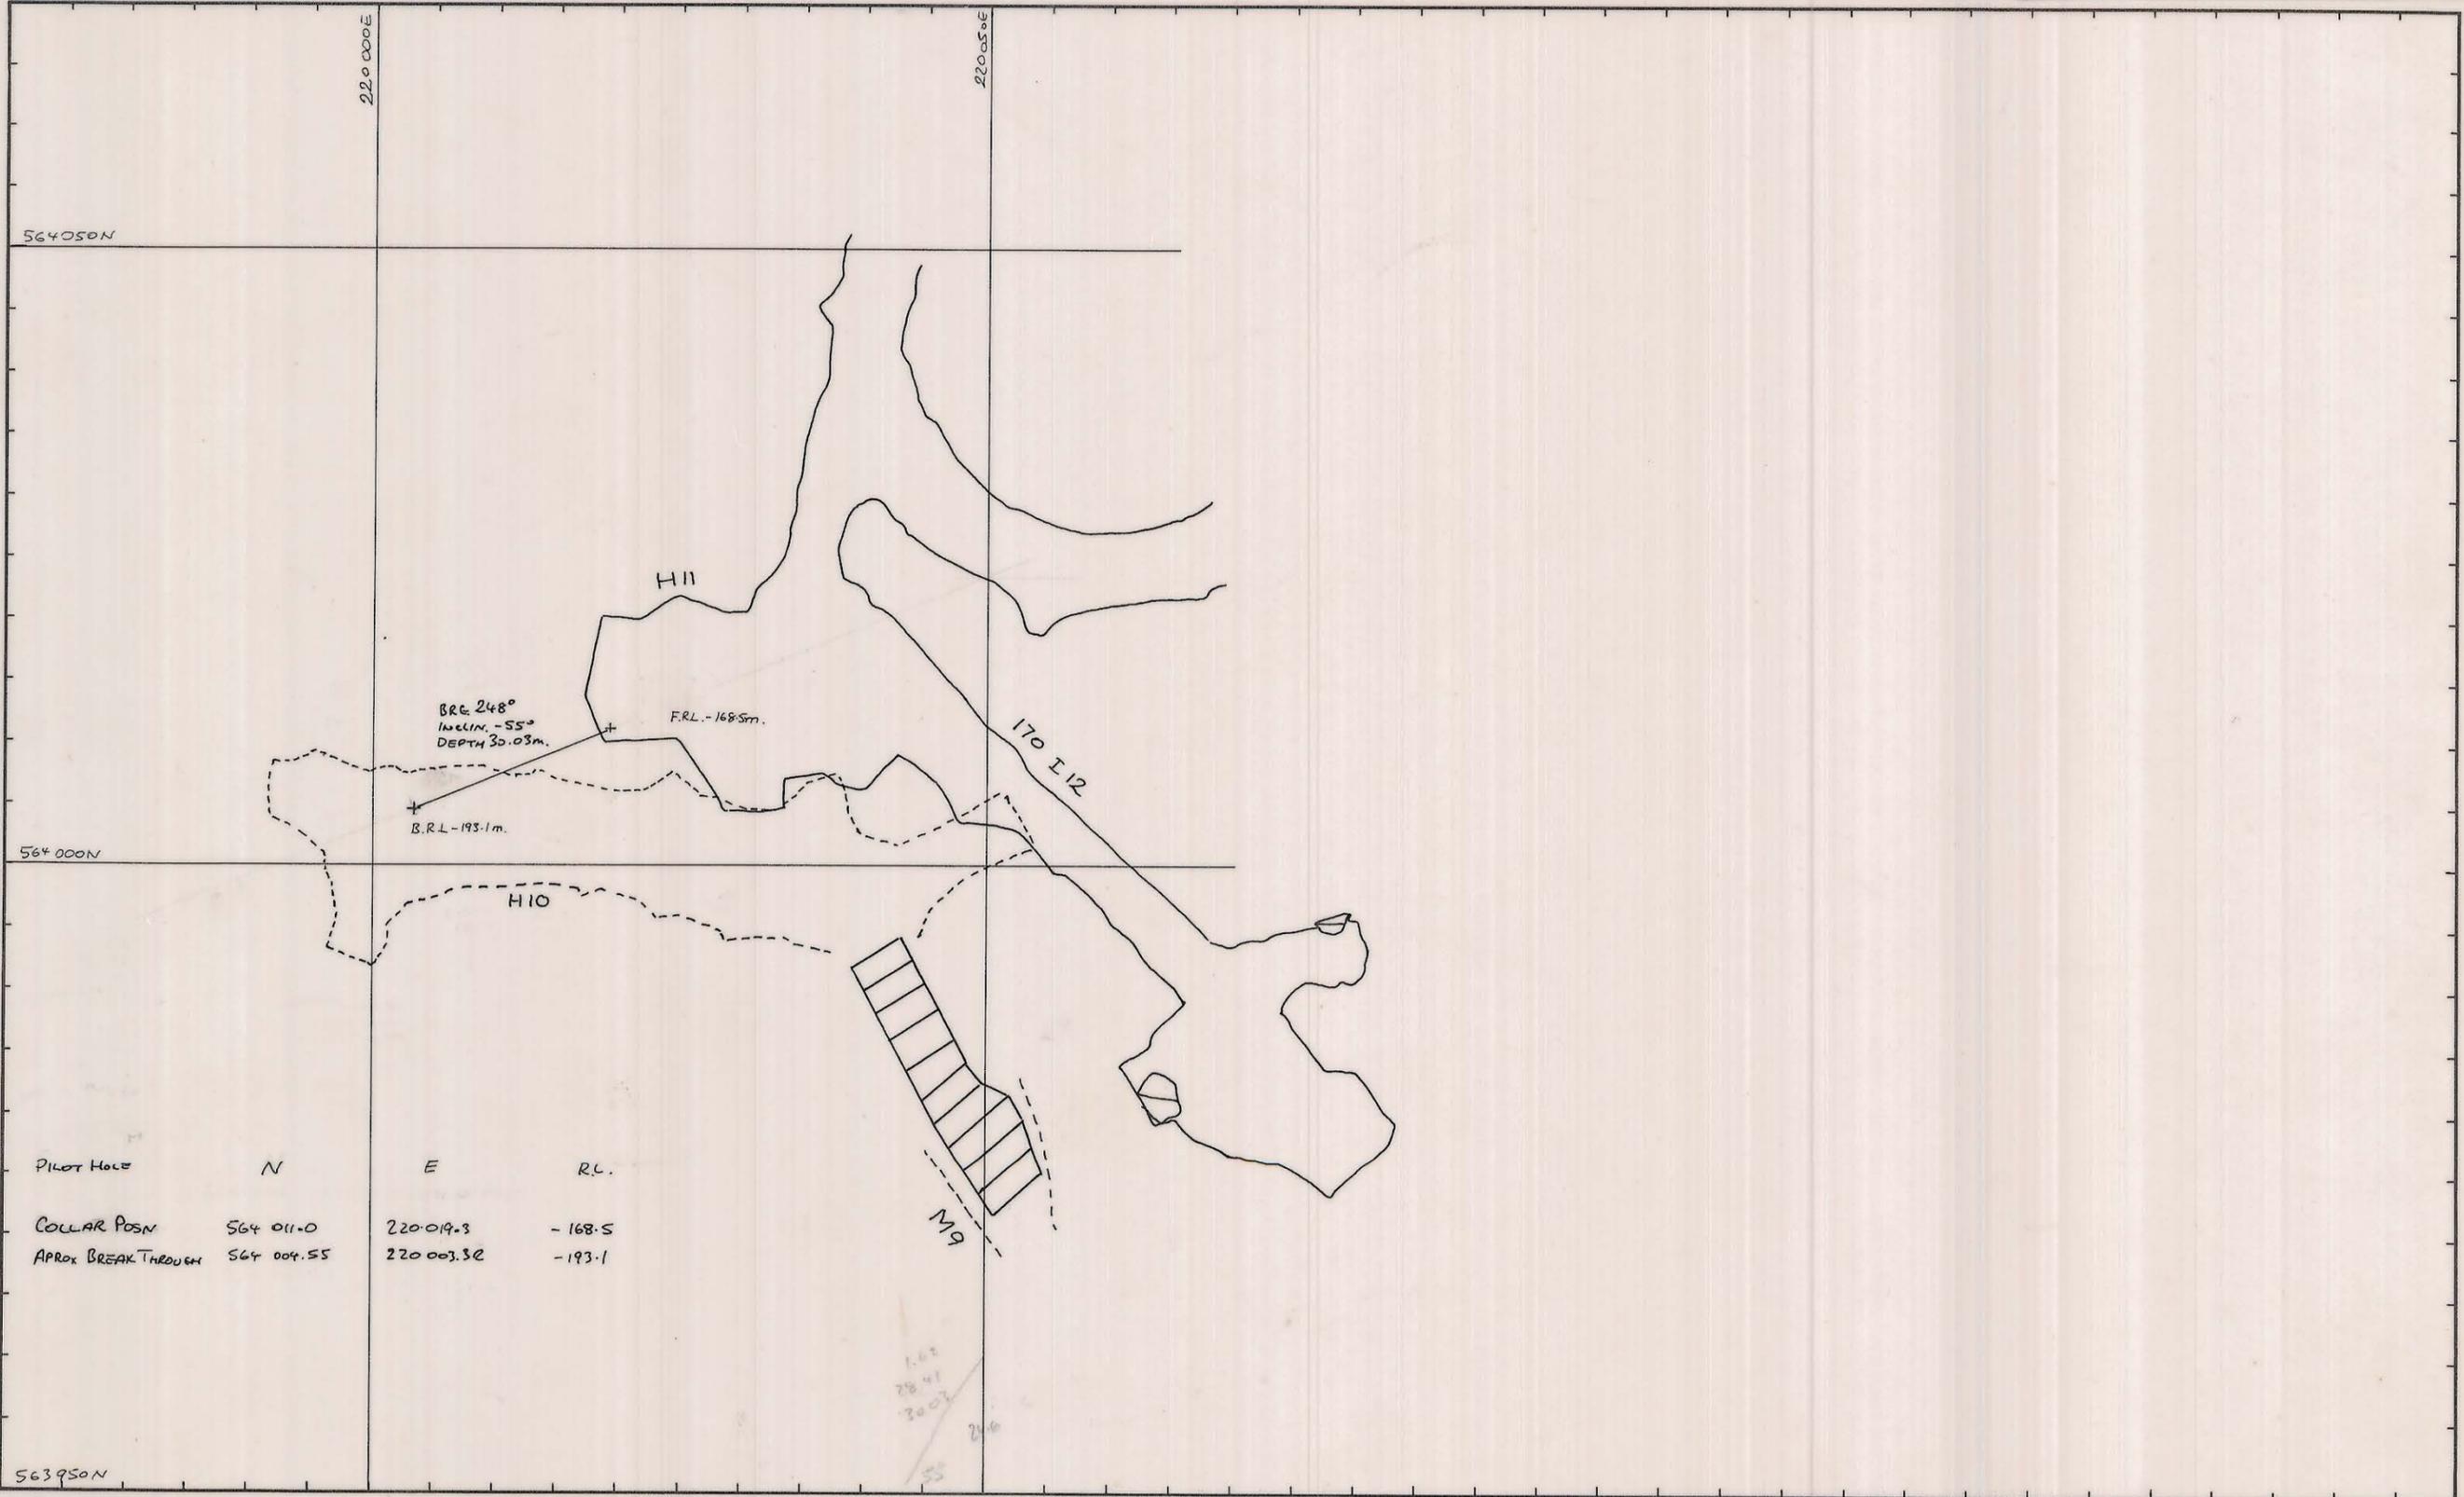


03DM05-3006

0374_2636

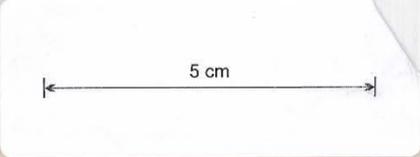

PILOT HOLE	N	E	R.L.
COLLAR POSN	564 011.0	220 019.3	-168.5
APPROX BREAK THROUGH	564 004.55	220 003.32	-193.1

RISE DIMENSIONS 2.0m. x 2.0m
 Height 30m.
 Inclination +55°

REF PLAN	
----------	--

GEOLOGY	
SURVEY	<i>glh</i>
PLANNING	<i>W.lyn</i> 7 7 81
ROCK MEC.	
GRADE CON.	
DRAFTING	<i>W.lyn</i> 7 7 81
T.S.S.	

SCALE 1:500

KIS KING ISLAND SCHEELITE
GRASSY KING ISLAND

SOUTHERN 0/B PIT DAG WEST 0/B
 RETURN AIR VENTILATION RISE
 (193 H11 RISE)

DRAWING NUMBER **03DM05-3006**