
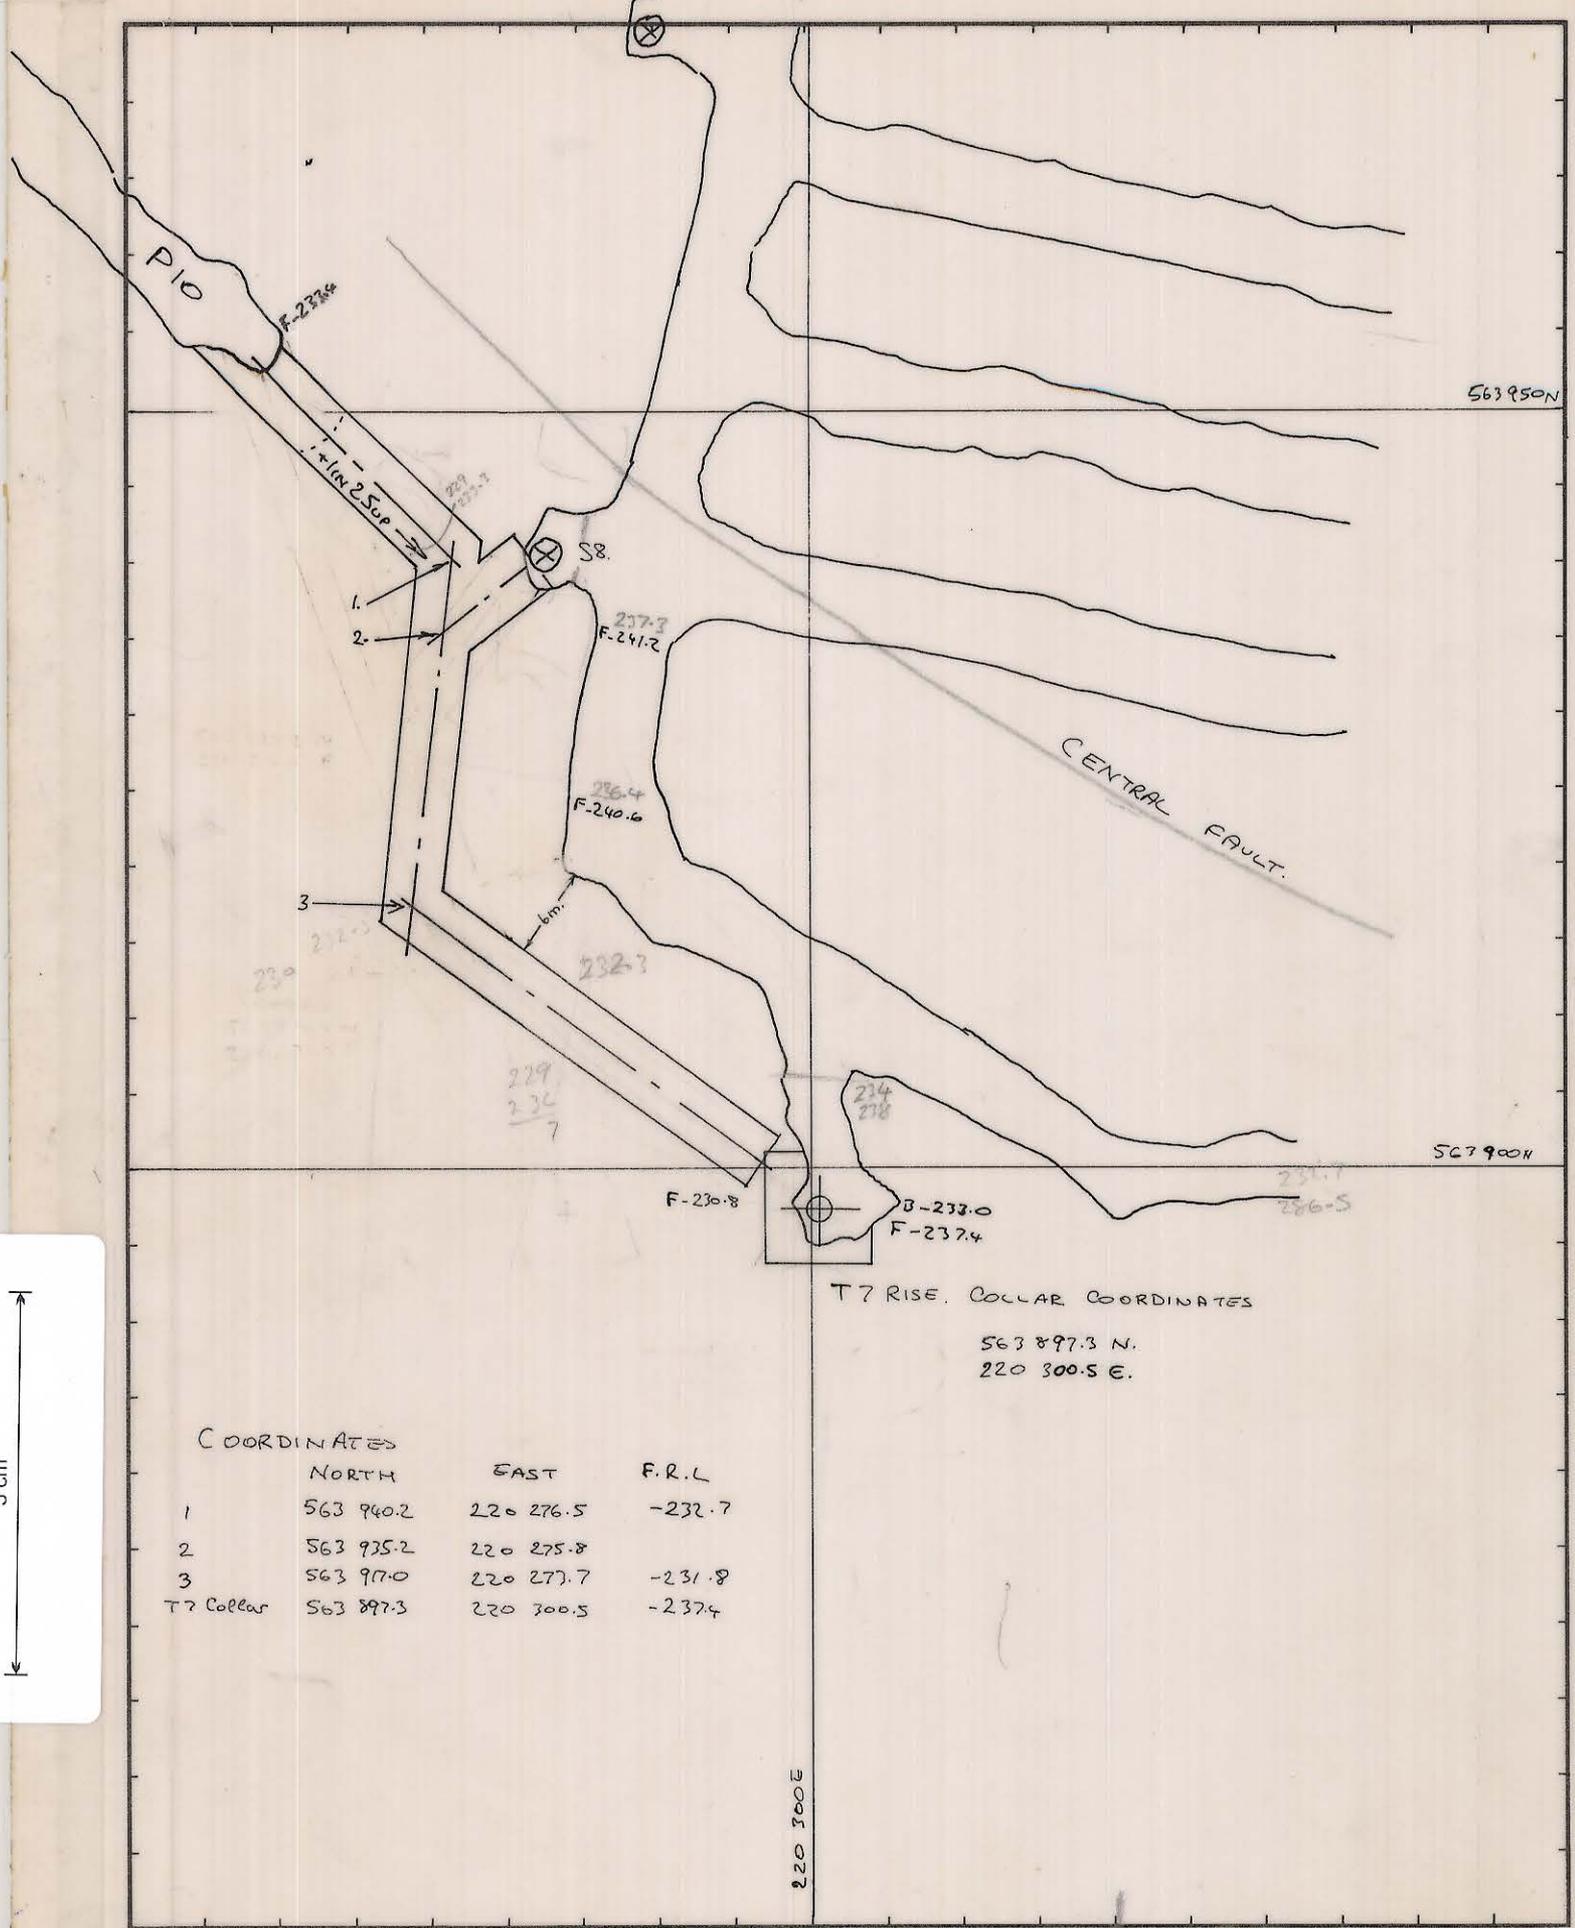


03DM05-1006A

0374\_2643

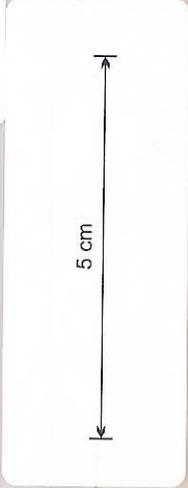

COORDINATES

	NORTH	EAST	F.R.L
1	563 940.2	220 276.5	-232.7
2	563 935.2	220 275.8	
3	563 917.0	220 277.7	-231.8
T7 Collar	563 897.3	220 300.5	-237.4

T7 RISE. COLLAR COORDINATES  
 563 897.3 N.  
 220 300.5 E.

REF PLAN	GEOLOGY	RESO	25-9-81	1:500 SCALE	
	SURVEY	<i>W. G. M.</i>	2/10/81		
	PLANNING	<i>W. G. M.</i>	23/9/81	240 metre level T7 Vent. Rise and Vent. Return to S8 Vent. Rise.	
	ROCK.MEC.	<i>J.C.</i>	7/10/81		
	GRADE CON. MINE SUPT.				
DRAFTING			DRAWING NUMBER	03 DM05 1006A	
T.S.S.					

*W. G. M. 2/10/81*