




0374_2656

MASTER
ENGINEER PILLAR
EXTRACTION
-220m LEVEL-

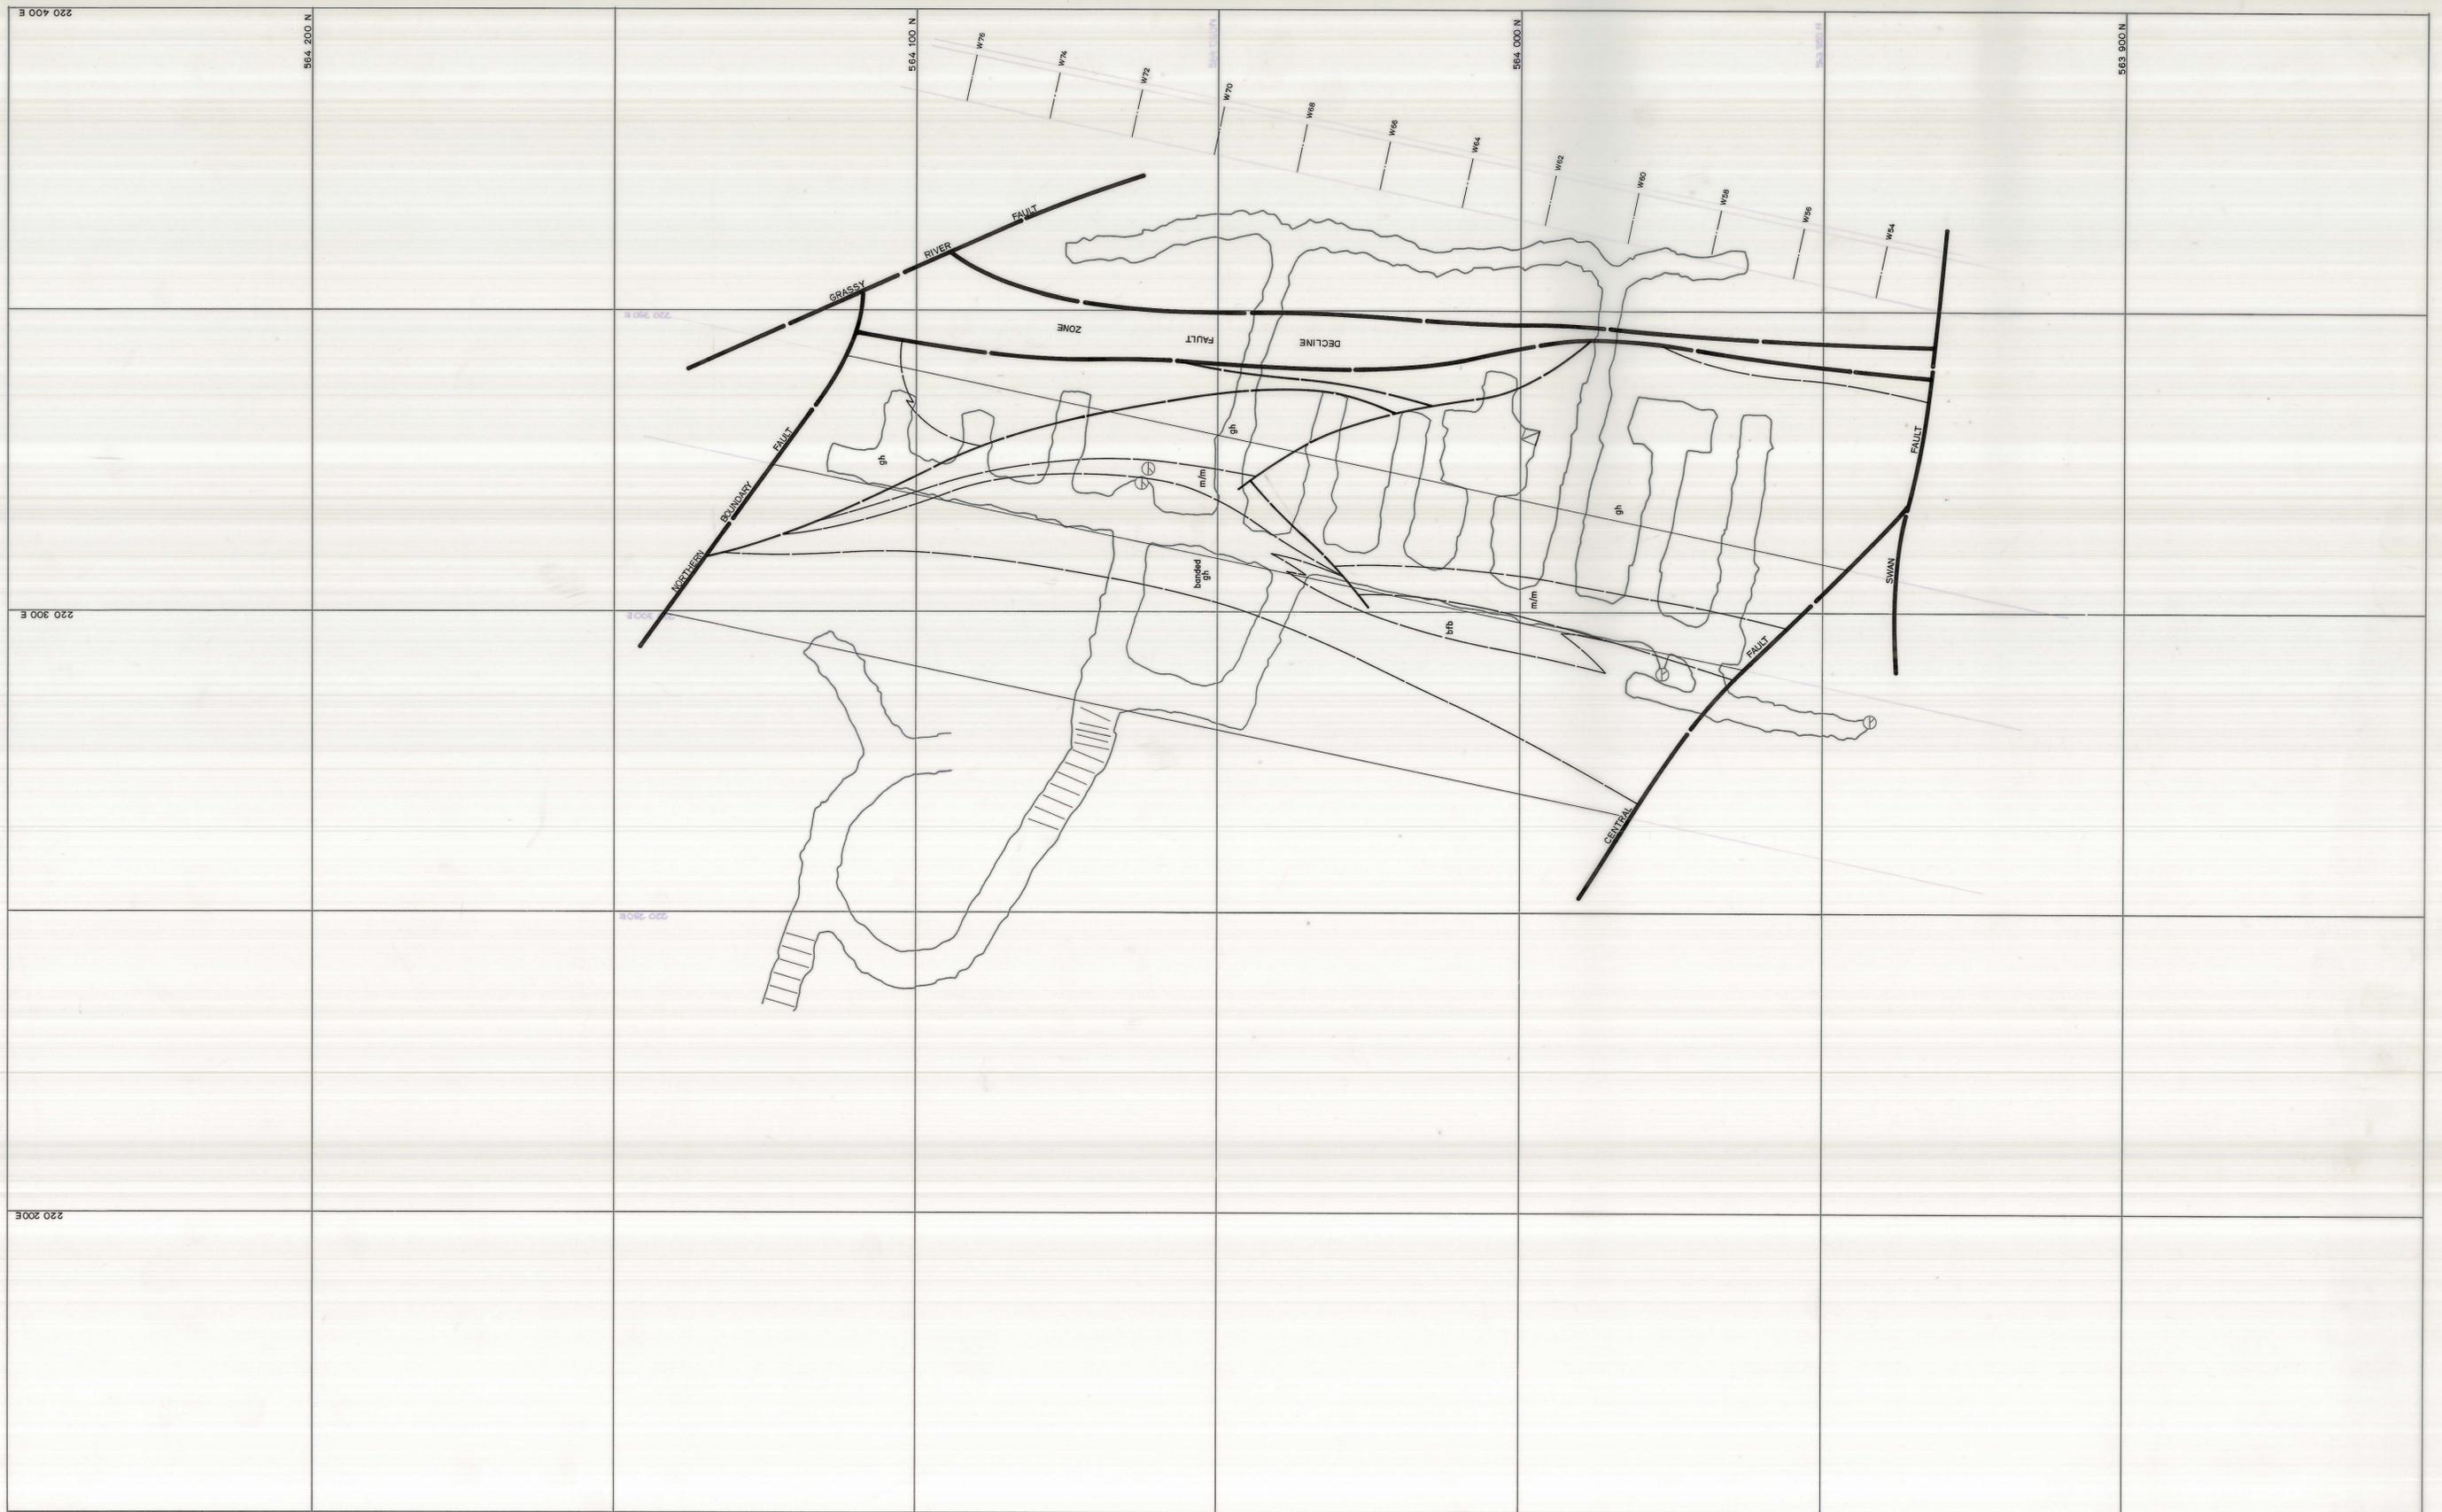

	SCALE 1:	<p>north</p>	LOCATION SUBJECT <p>-220m LEVEL</p>	<p>KIS KING ISLAND SCHEELITE A DIVISION OF WARMAN INTERNATIONAL</p> <p>GRASSY KING ISLAND</p> <p>PLAN NUMBER</p> <p>-220m LEVEL</p>
--	----------	--------------	---	--