




0374\_2657

MASTER  
BARRIER PILLAR  
EXTRACTION  
-240m LEVEL

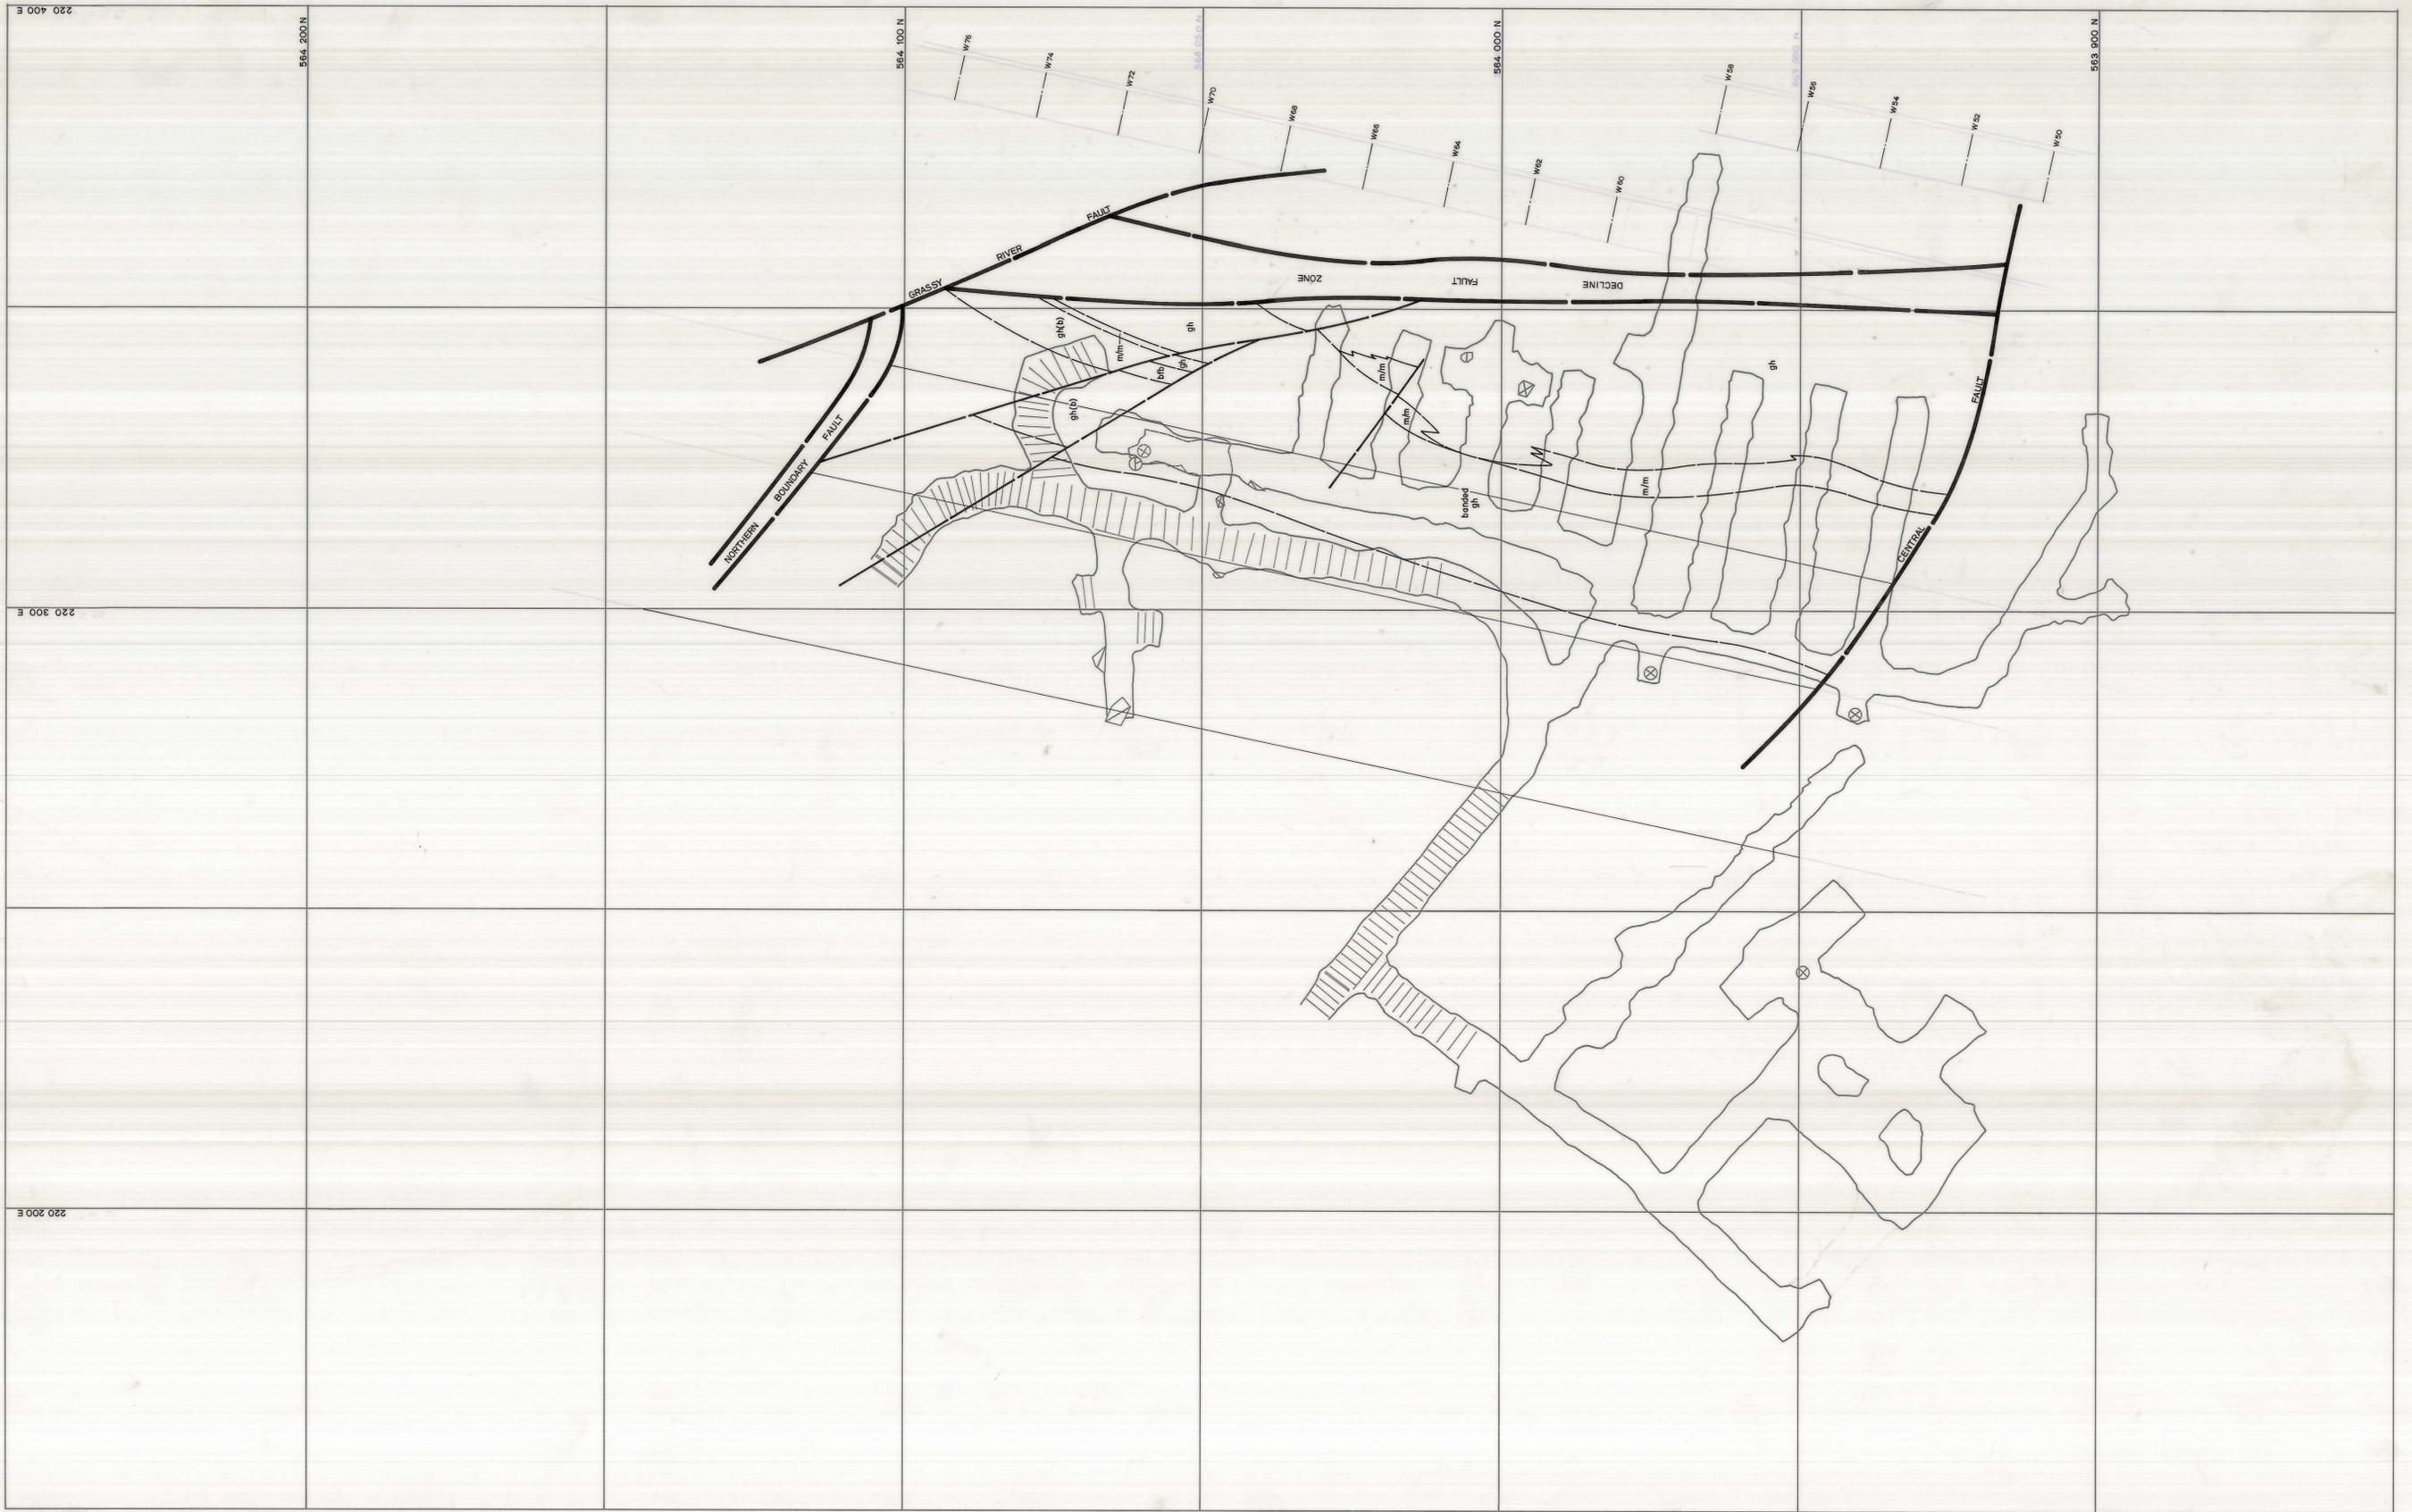

|                 |              |  |  |
|-----------------|--------------|--|--|
| <p>SCALE 1:</p> | <p>north</p> | <p>LOCATION</p> <p>SUBJECT</p> <p>-240m LEVEL</p> <p>-240m LEVEL</p> | <p>KING ISLAND SCHEELITE<br/>A DIVISION OF WARMAN INTERNATIONAL</p> <p>GRASSY KING ISLAND</p> <p>PLAN NUMBER</p> |
|-----------------|--------------|--|--|