


27 JUN 1981

5cm

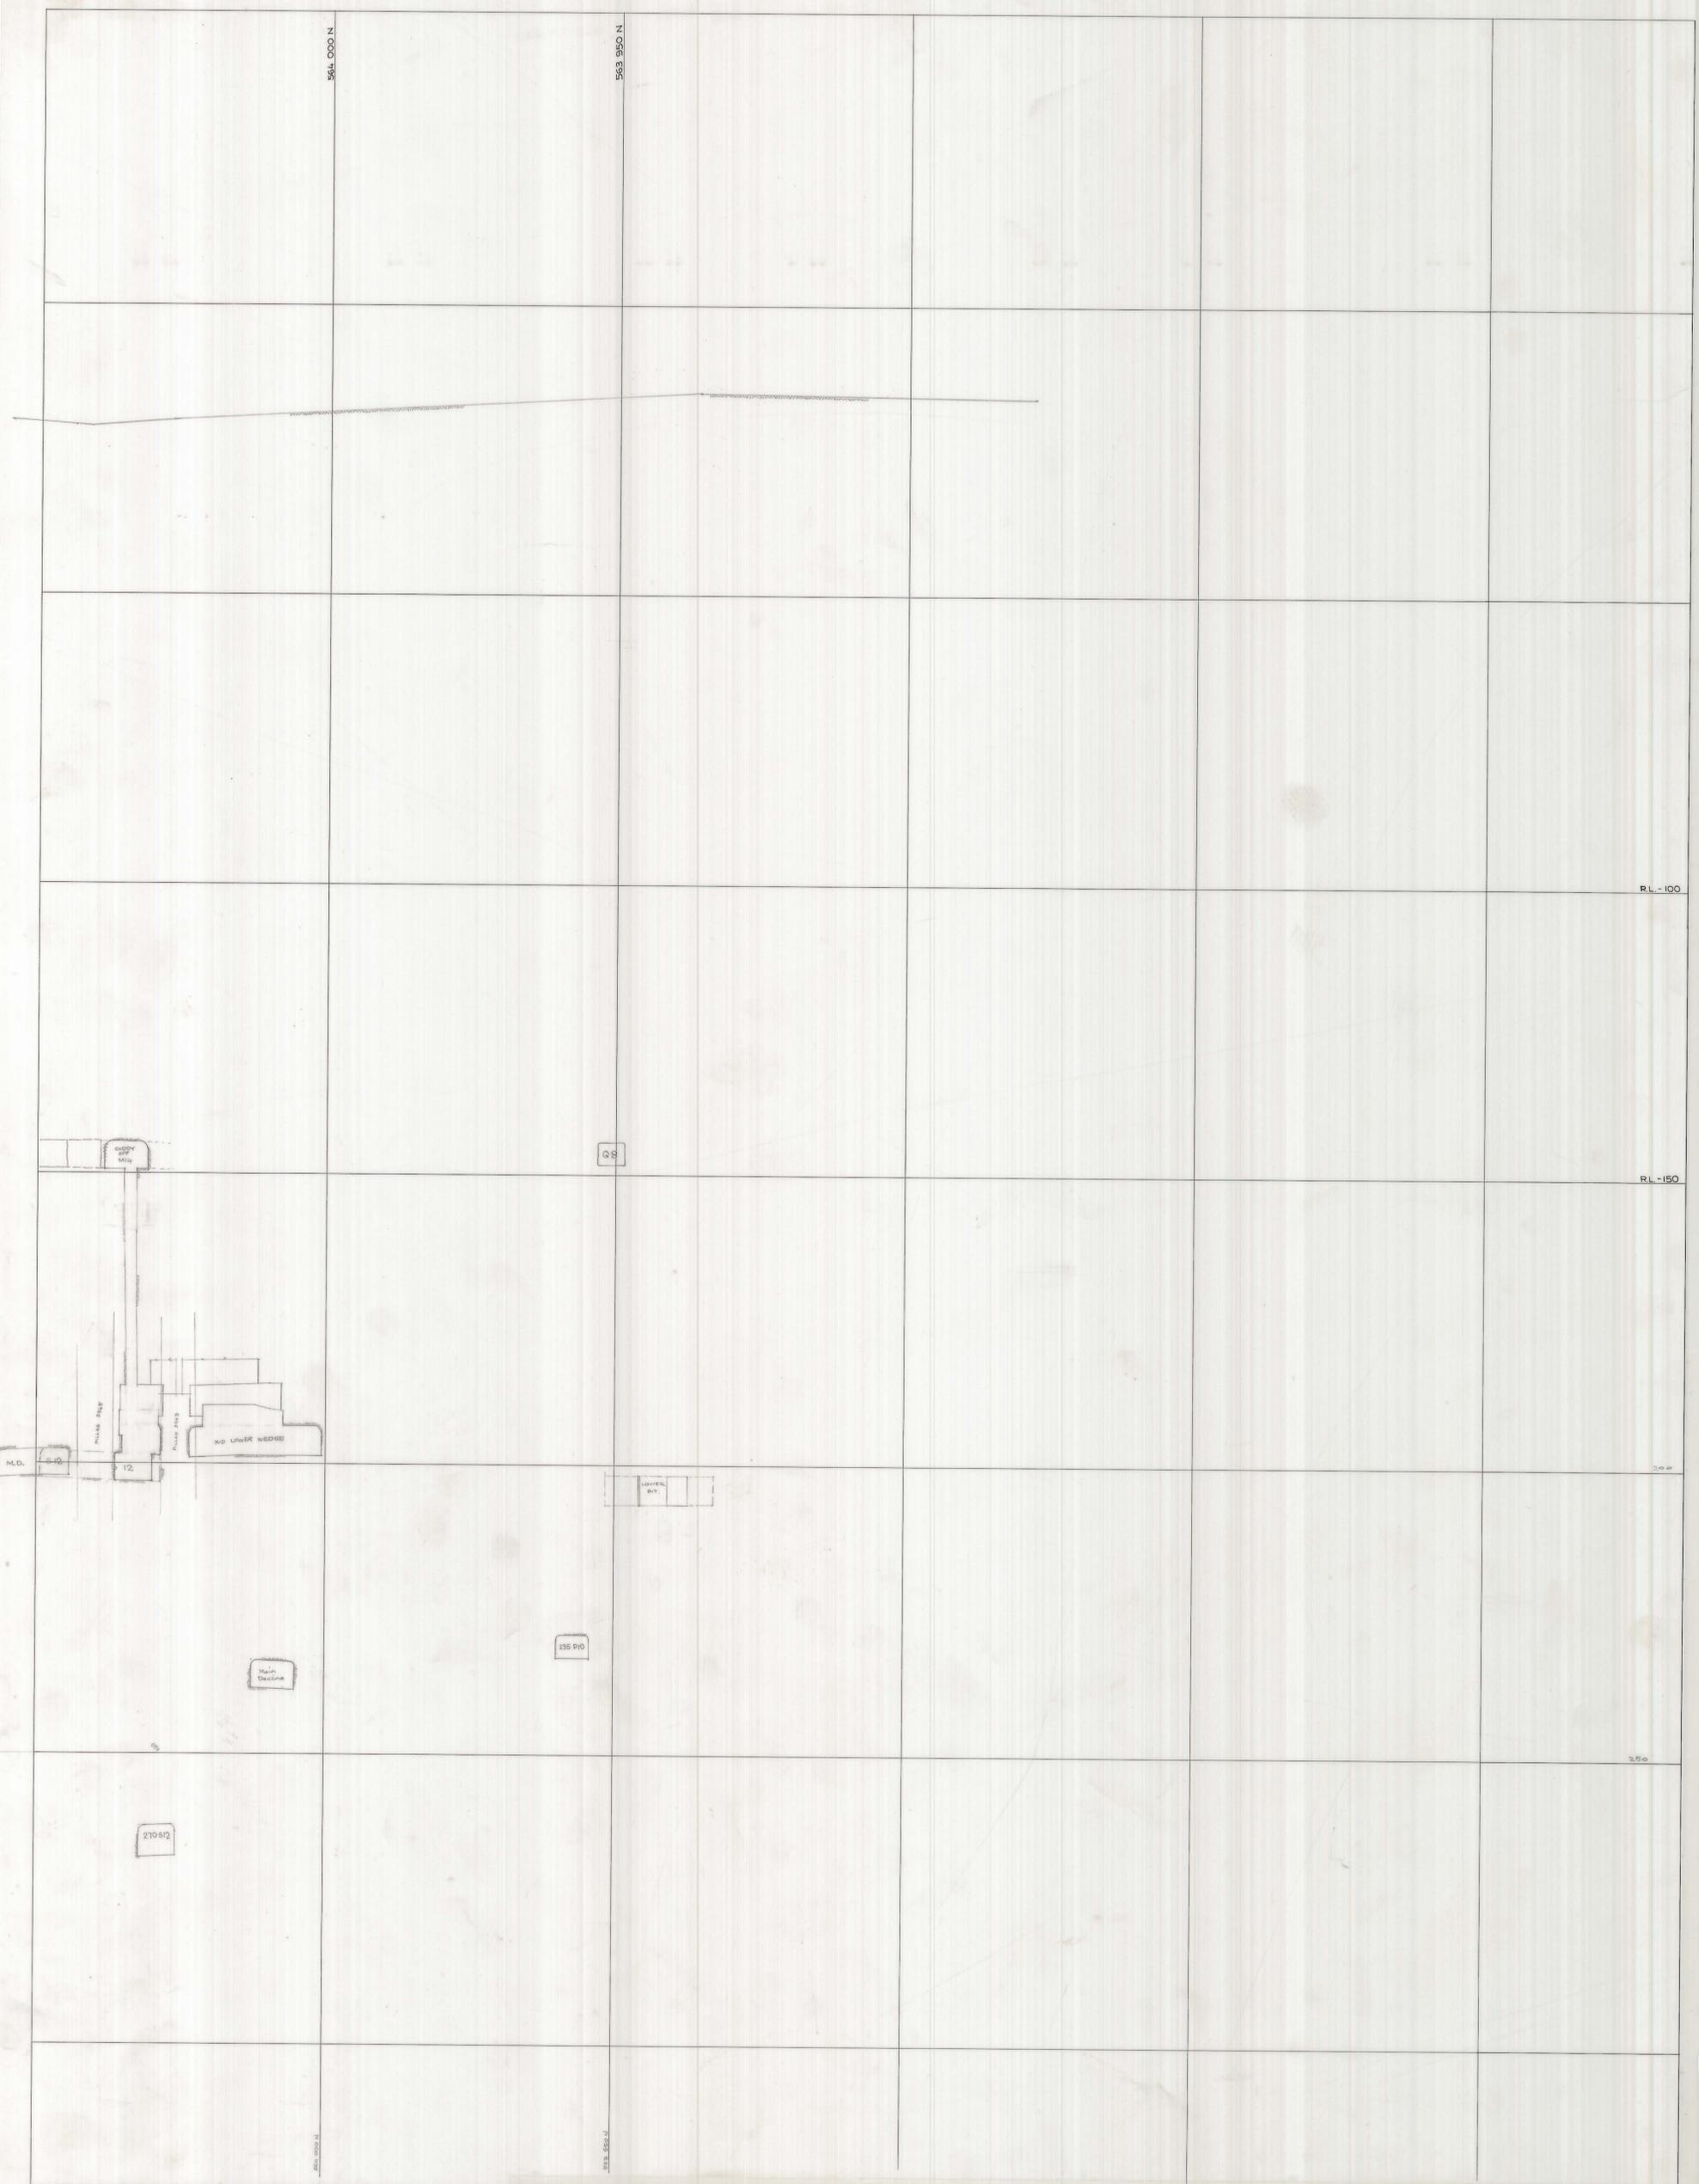

SCALE 1

LOCATION

SUBJECT

220 260 E

KIS KING ISLAND SCHEELITE
A DIVISION OF KAMAX INTERNATIONAL

GRASSY

KING ISLAND

PLAN NUMBER

north

0374_2691