
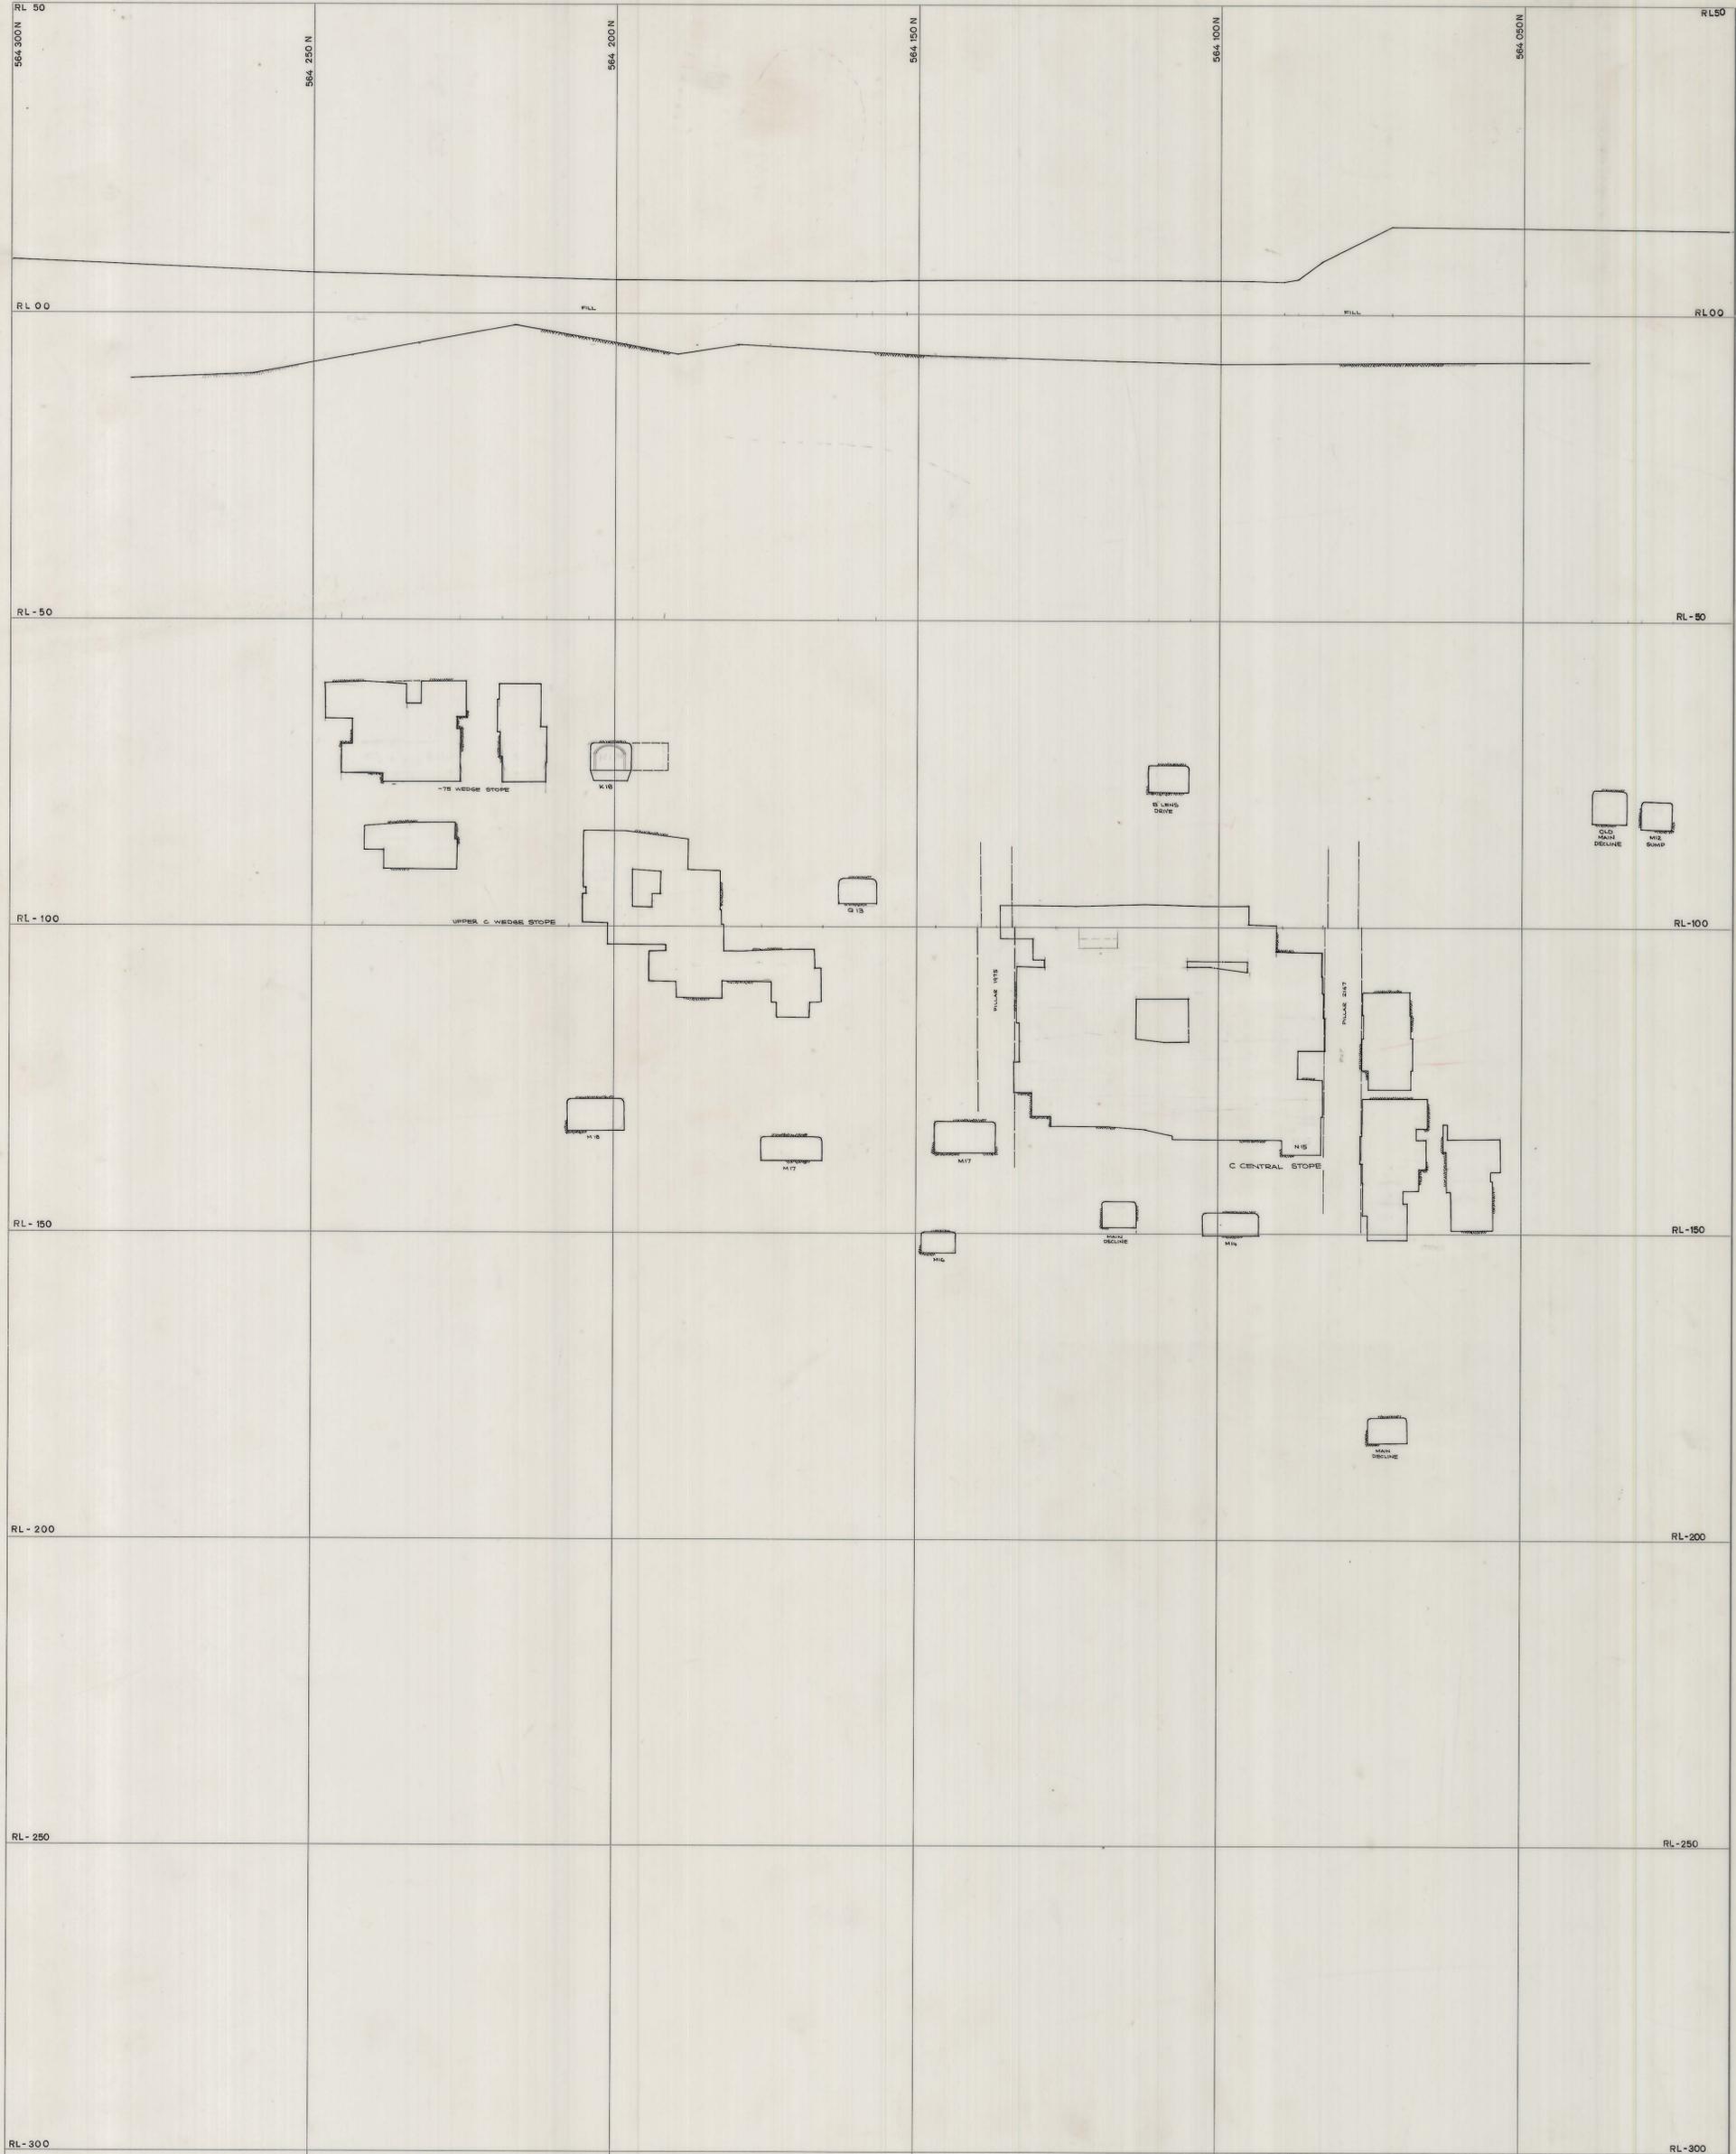


27 JUN 1981

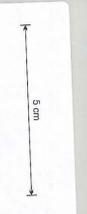

SCALE 1:500	LOCATION DOLPHIN MINE	
looking east	SUBJECT CROSSSECTION 220 140 E	
		GRASSY KING ISLAND PLAN NUMBER 04DM22 - 1022

0374_2692

04DM22-1022

220-140-177