


27 JUN 1981

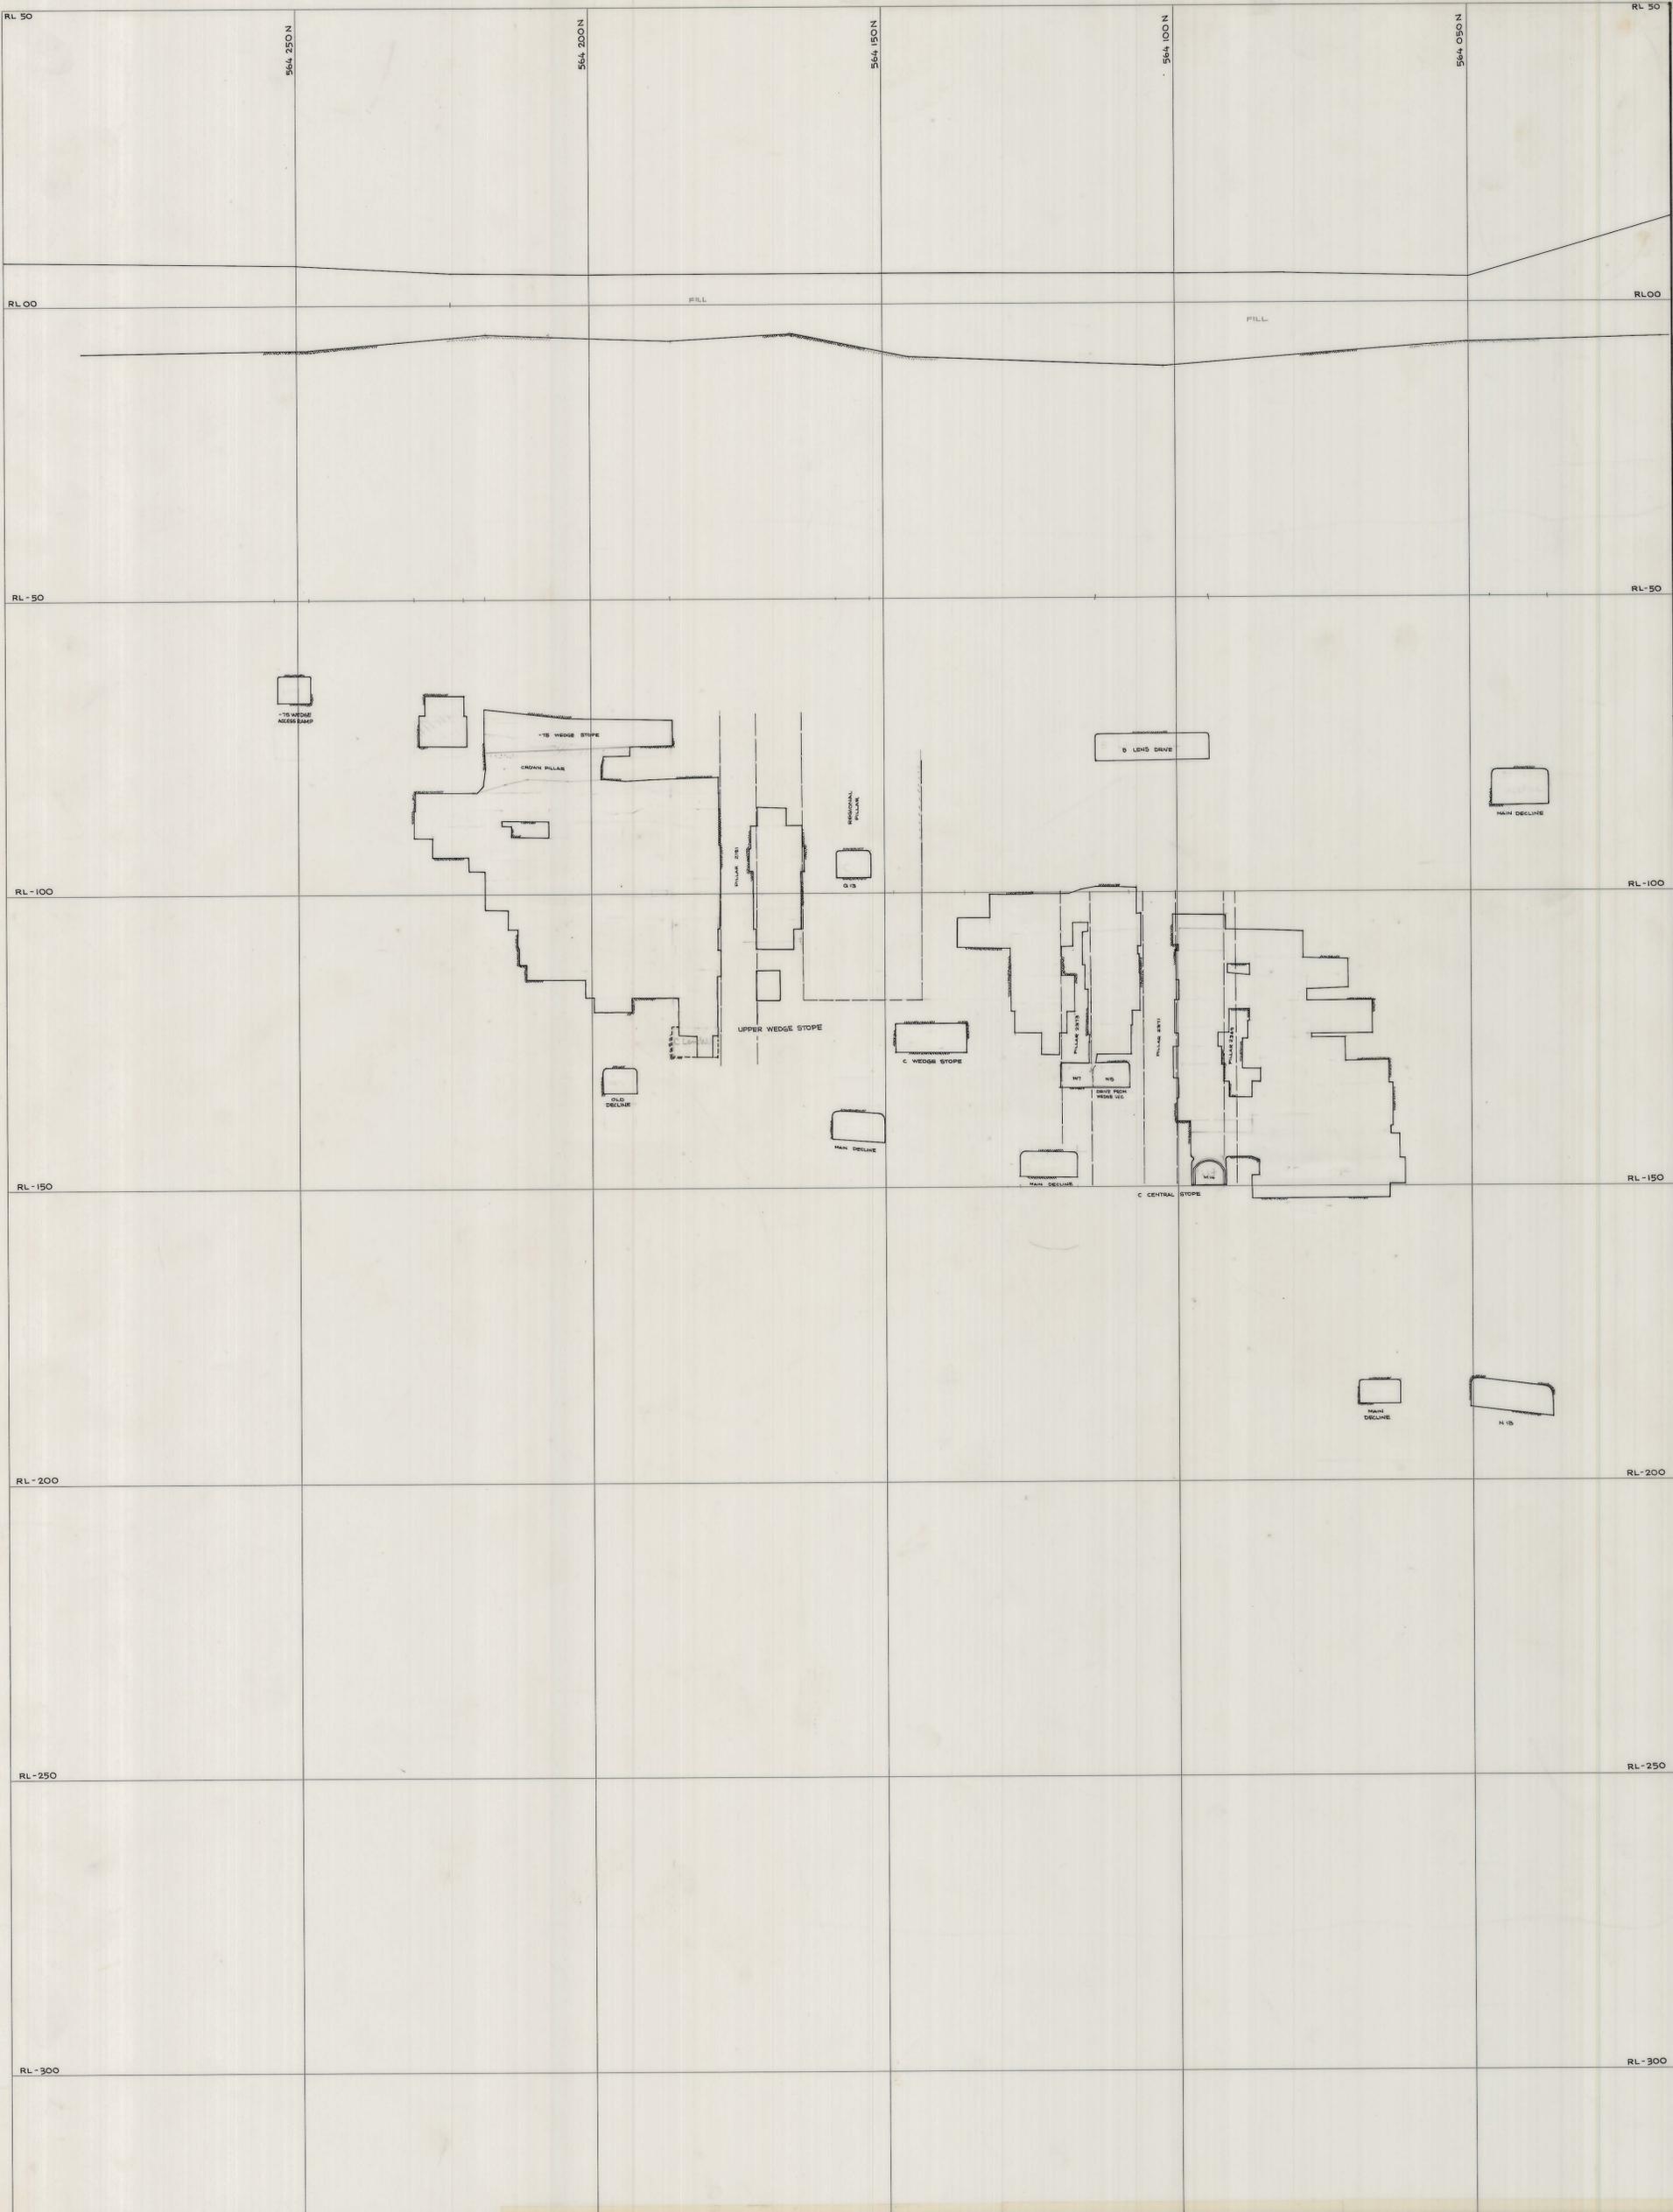

SCALE 1:500	LOCATION DOLPHIN MINE	
looking east	SUBJECT CROSSECTION 220 160 E	
		GRASSY KING ISLAND PLAN NUMBER 04DM22 - 1023

0374_2693

04DM22 - 1023