


27 JUN 1981

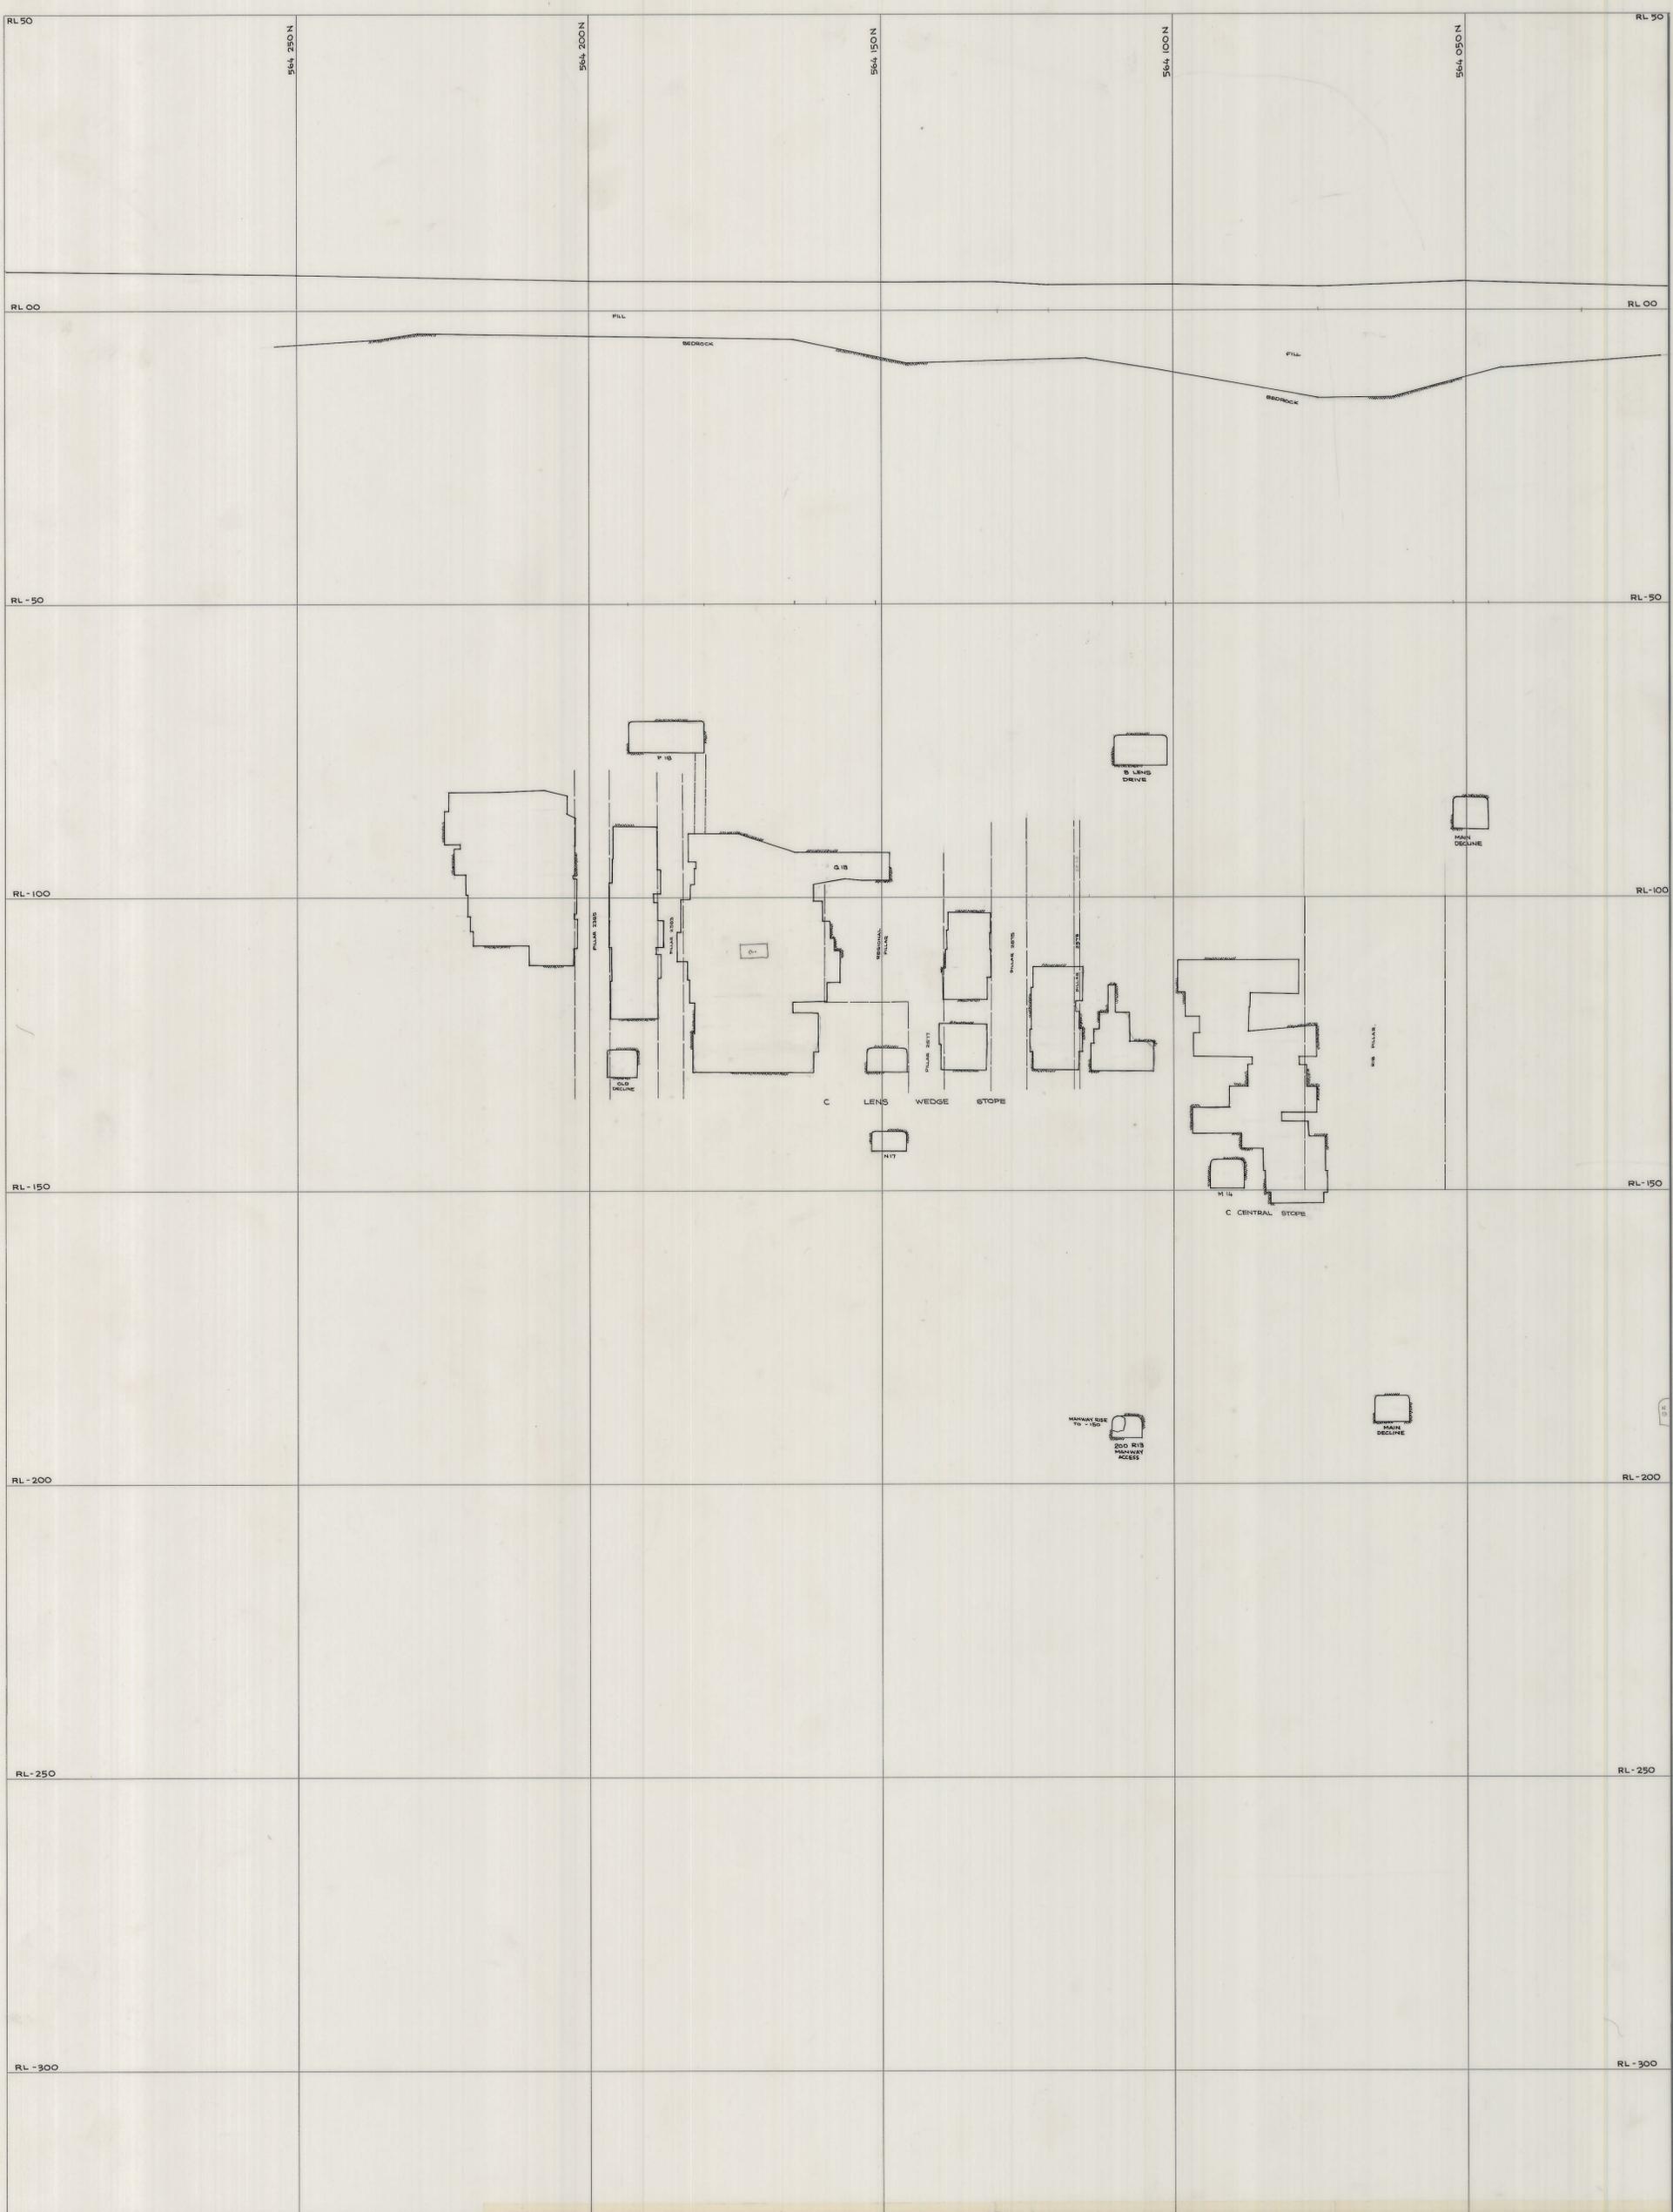

SCALE 1:500	LOCATION DOLPHIN MINE	 KING ISLAND SCHEELITE A DIVISION OF WARMAN INTERNATIONAL GRASSY KING ISLAND PLAN NUMBER 04 DM 22 - 1024
looking east	SUBJECT CROSSECTION 220 180 E	

0374\_2694

04DM22-1024