


27 JUN 1981

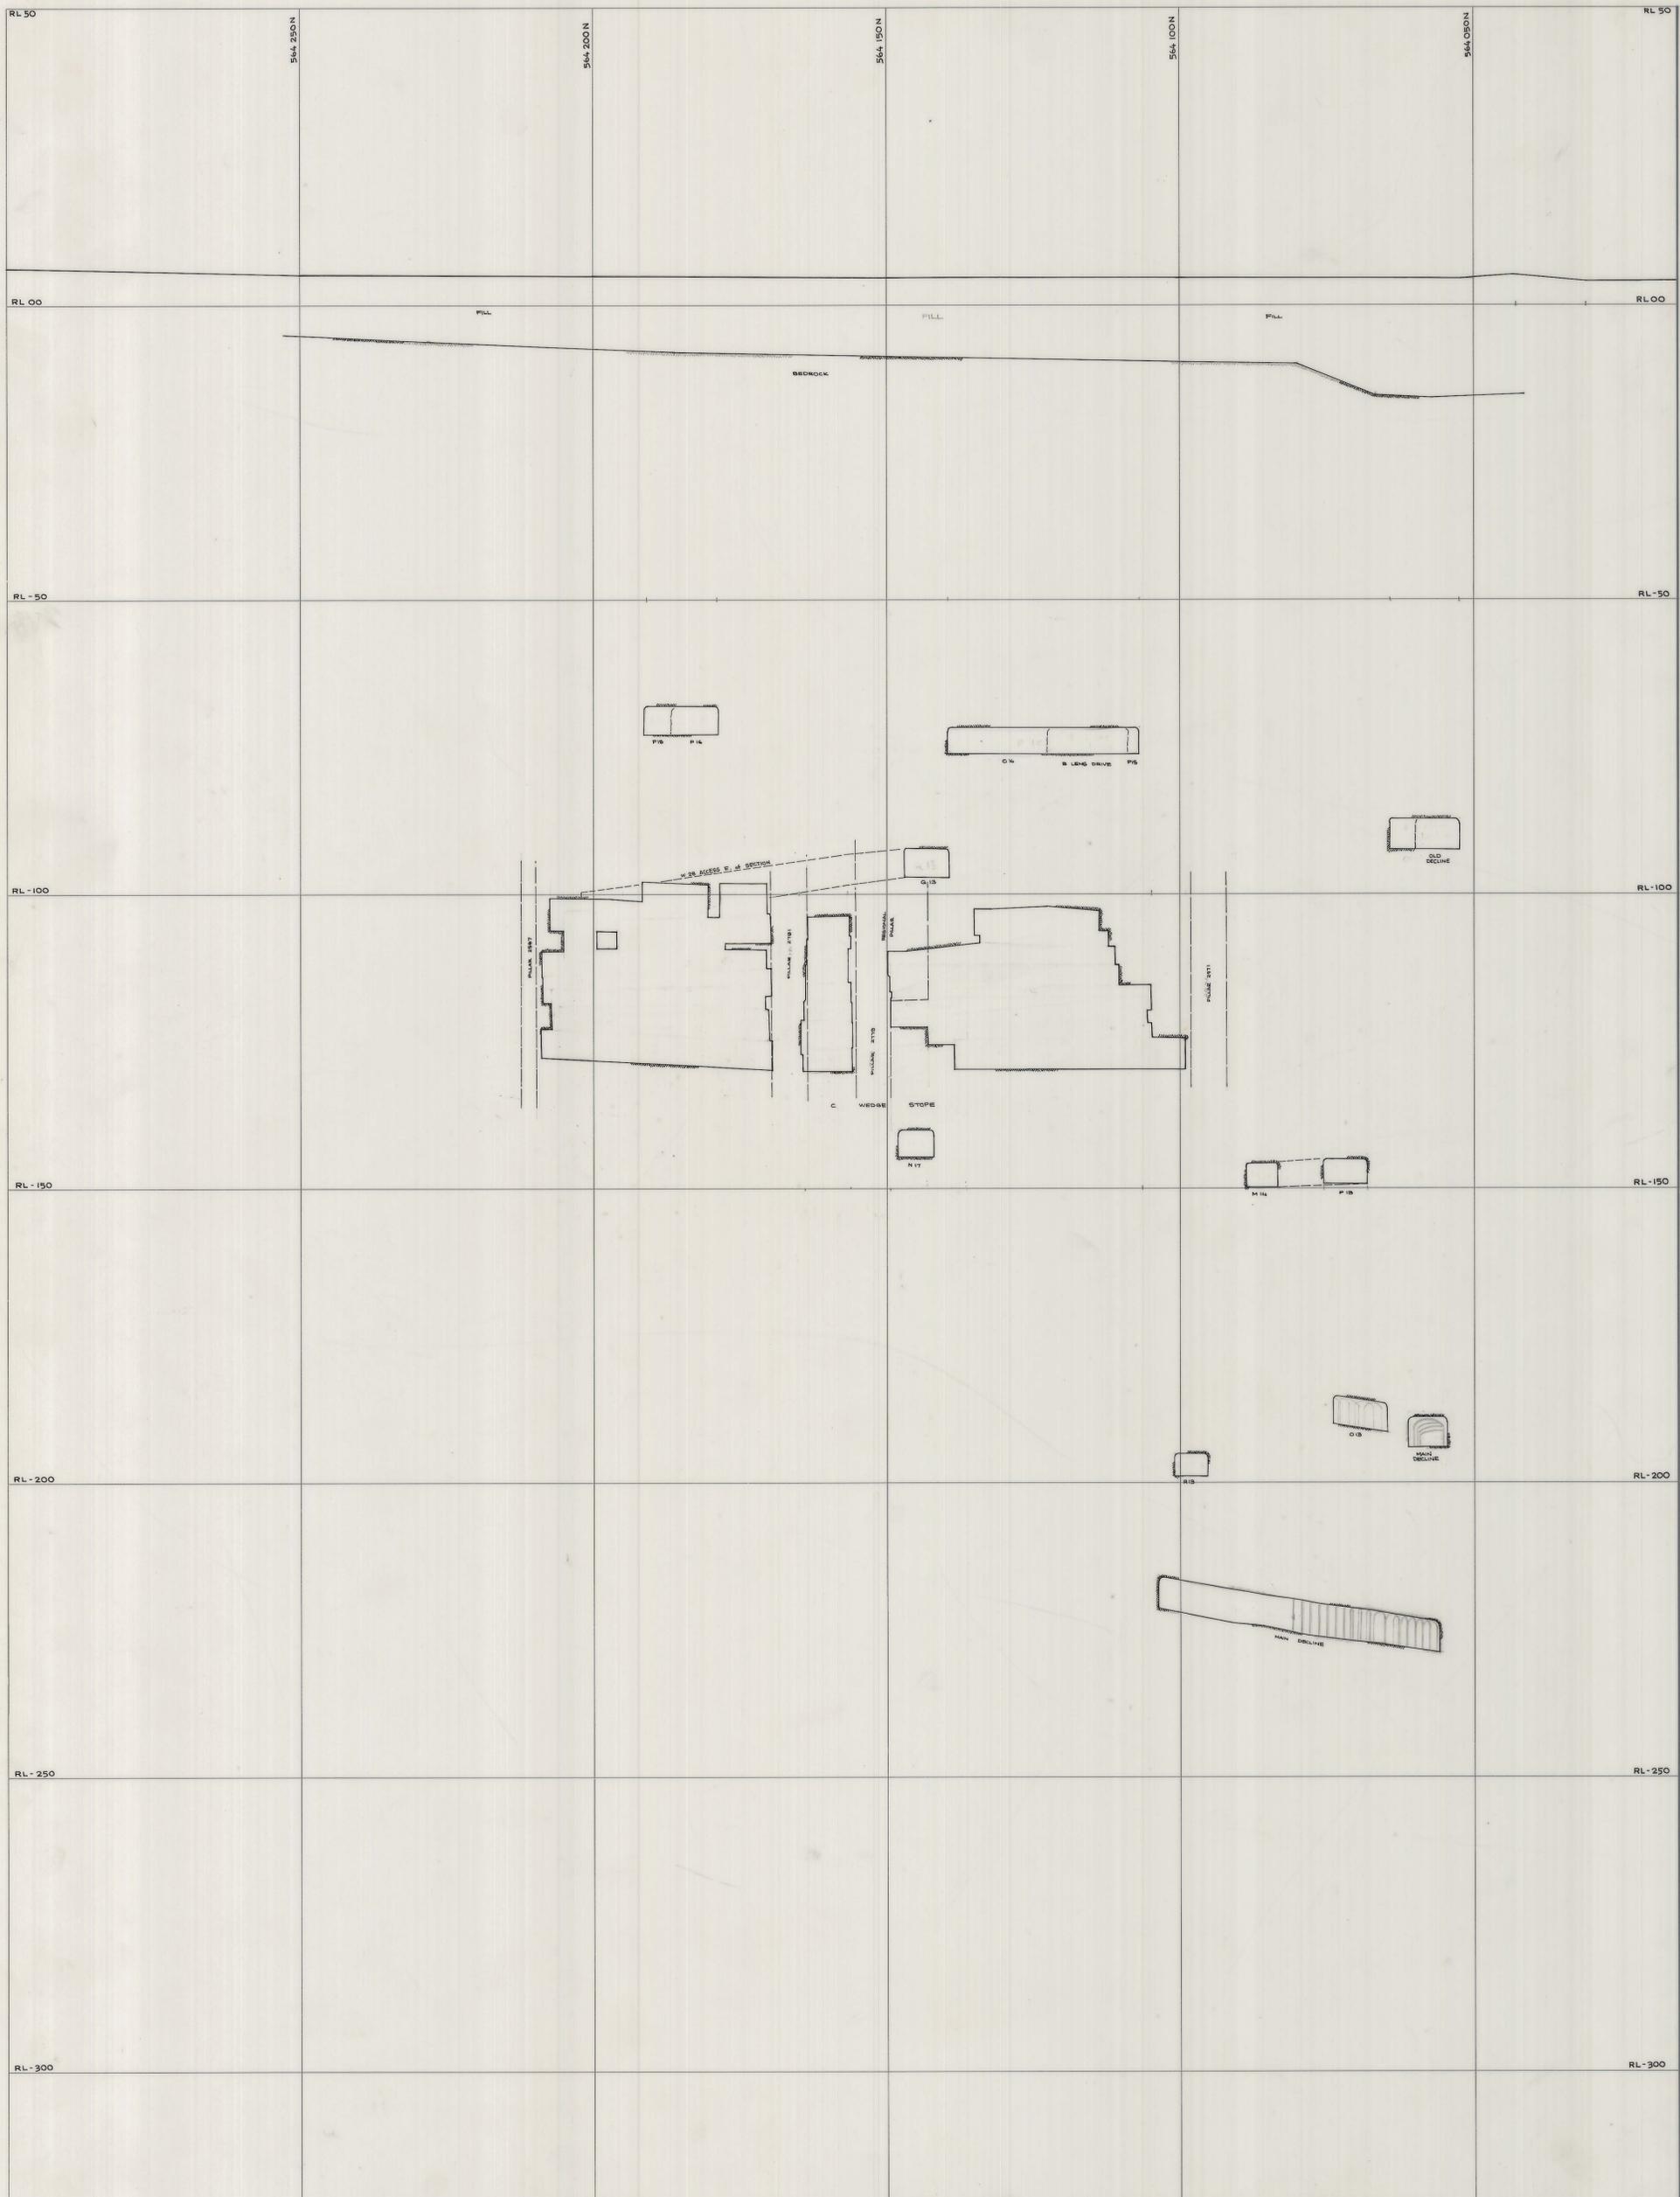

SCALE 1:500	LOCATION DOLPHIN MINE	 KING ISLAND SCHEELITE A DIVISION OF WARMAN INTERNATIONAL GRASSY KING ISLAND PLAN NUMBER 04DM22-1025
looking east	SUBJECT CROSSSECTION 220 200 E	

0374\_2695

04DM22-1025

9