




0374_2703

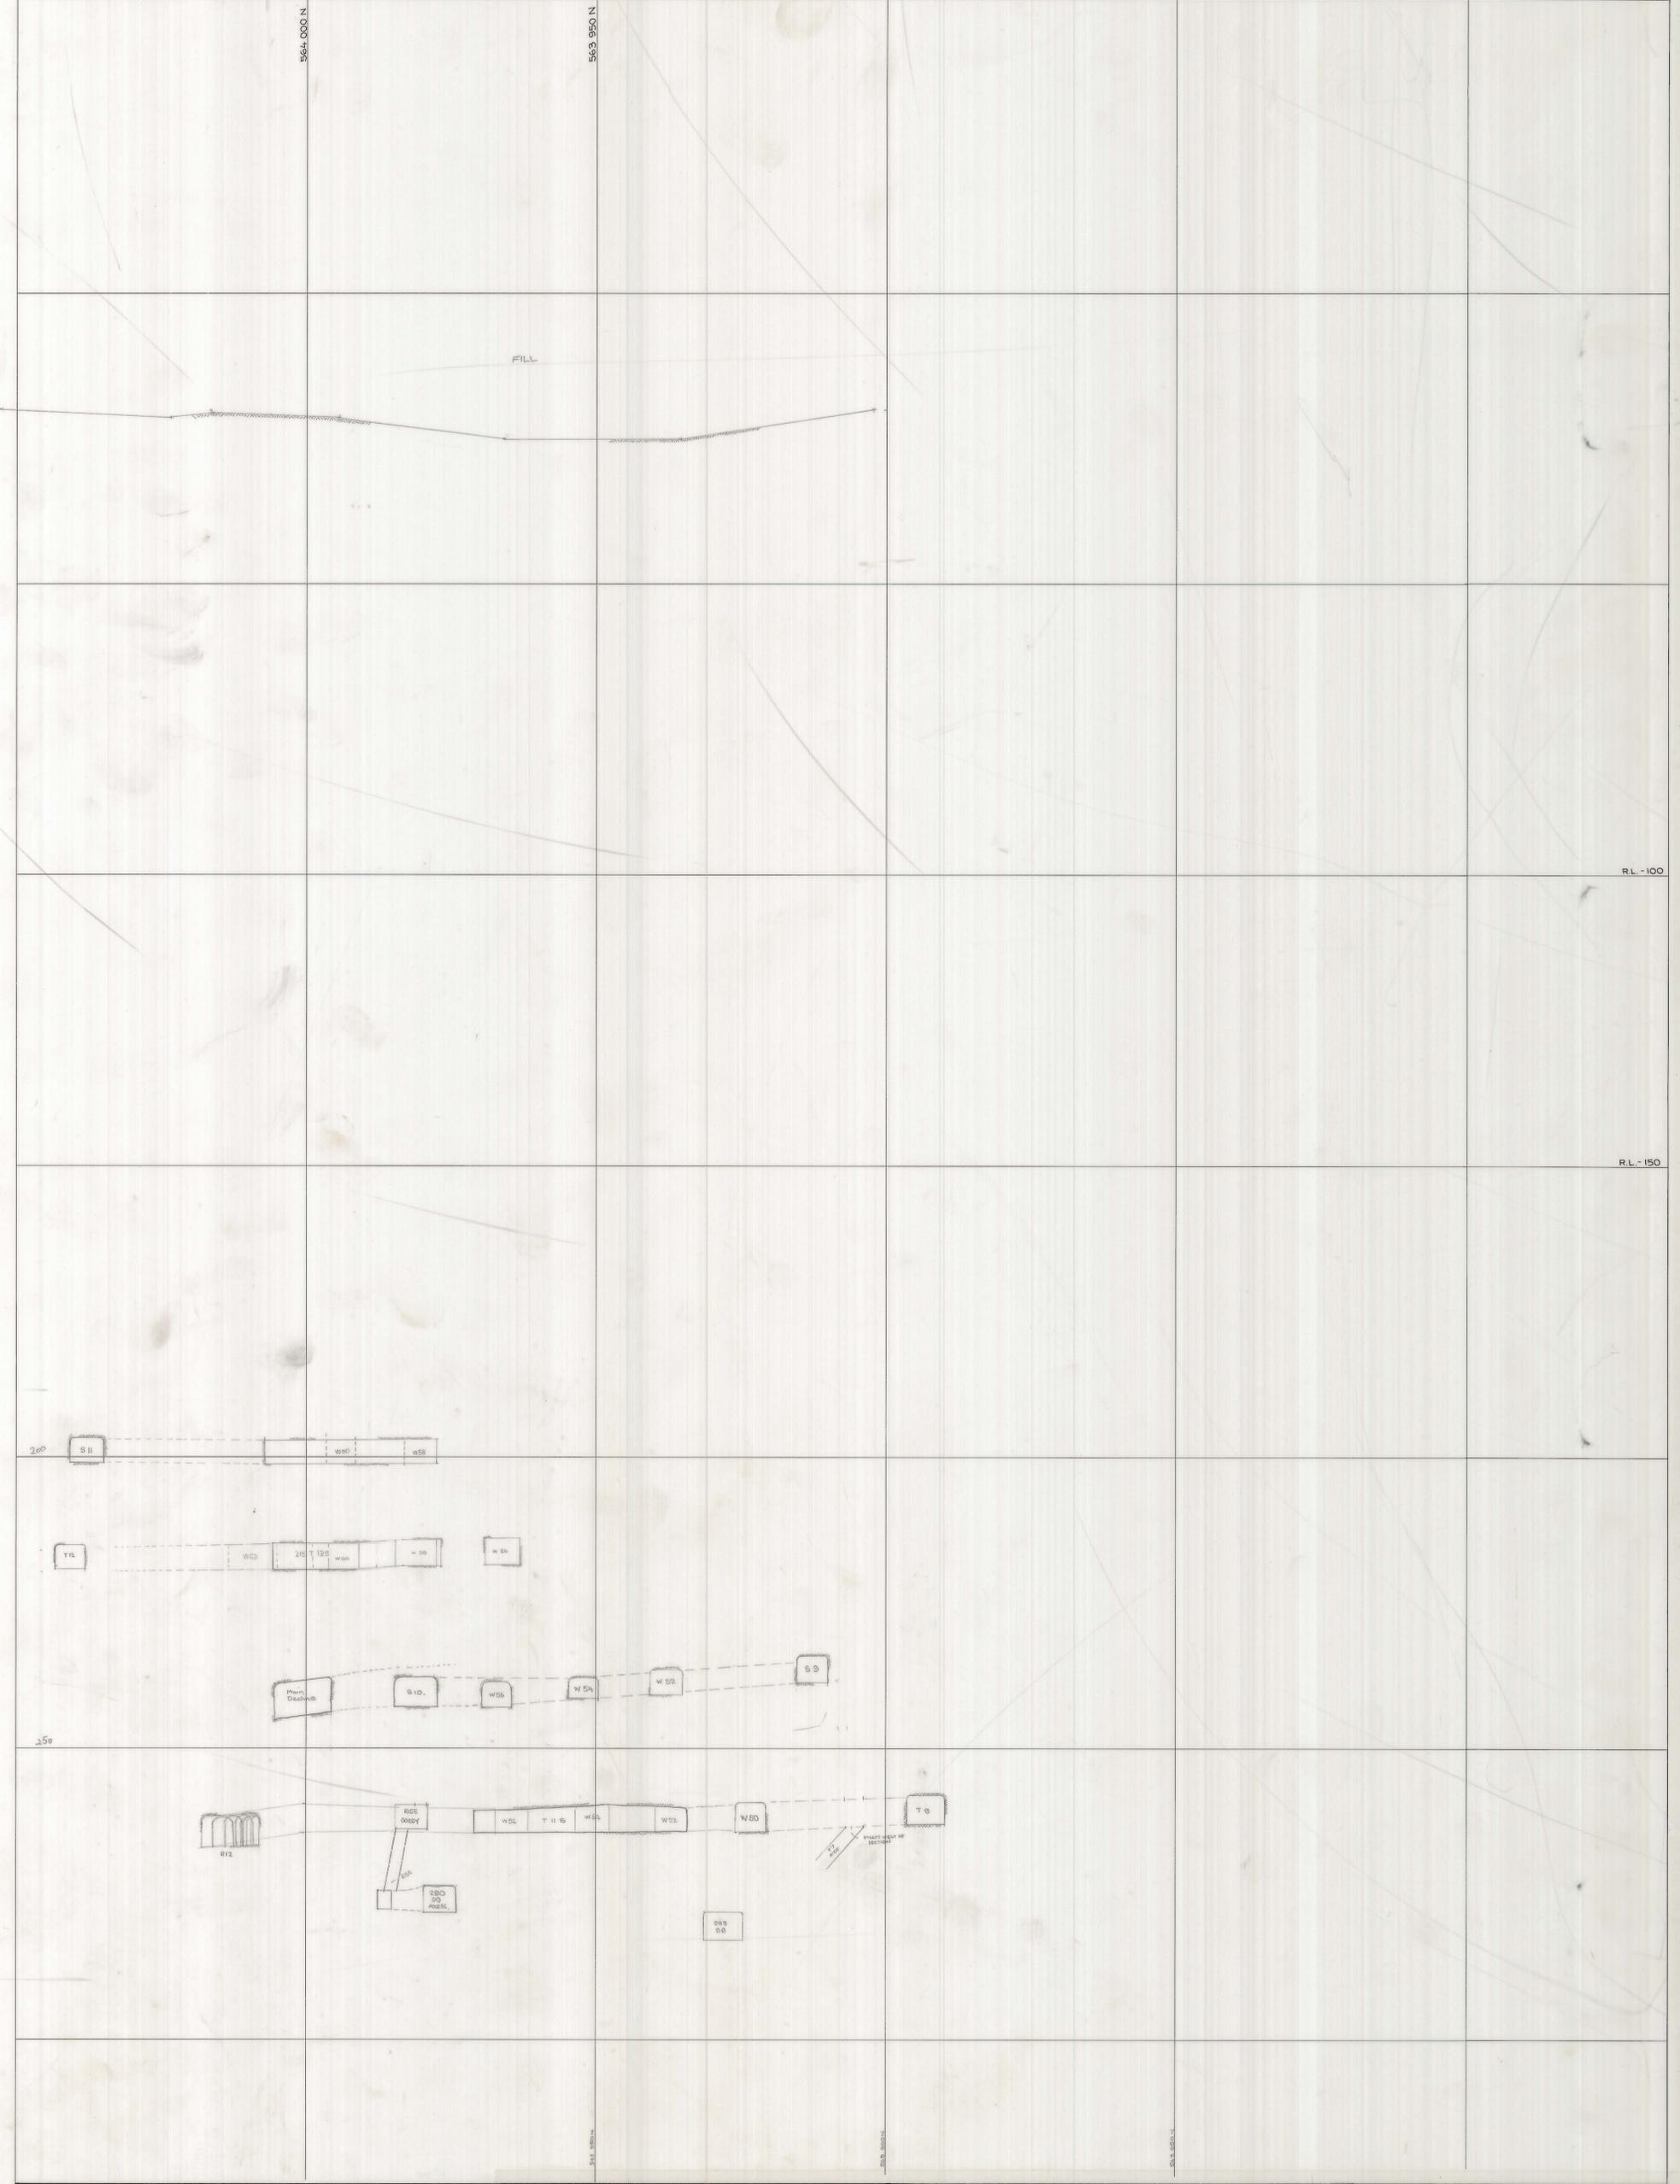

SCALE 1		LOCATION	
SUBJECT		220 300E	
PLAN NUMBER		KING ISLAND	

north