


5 cm

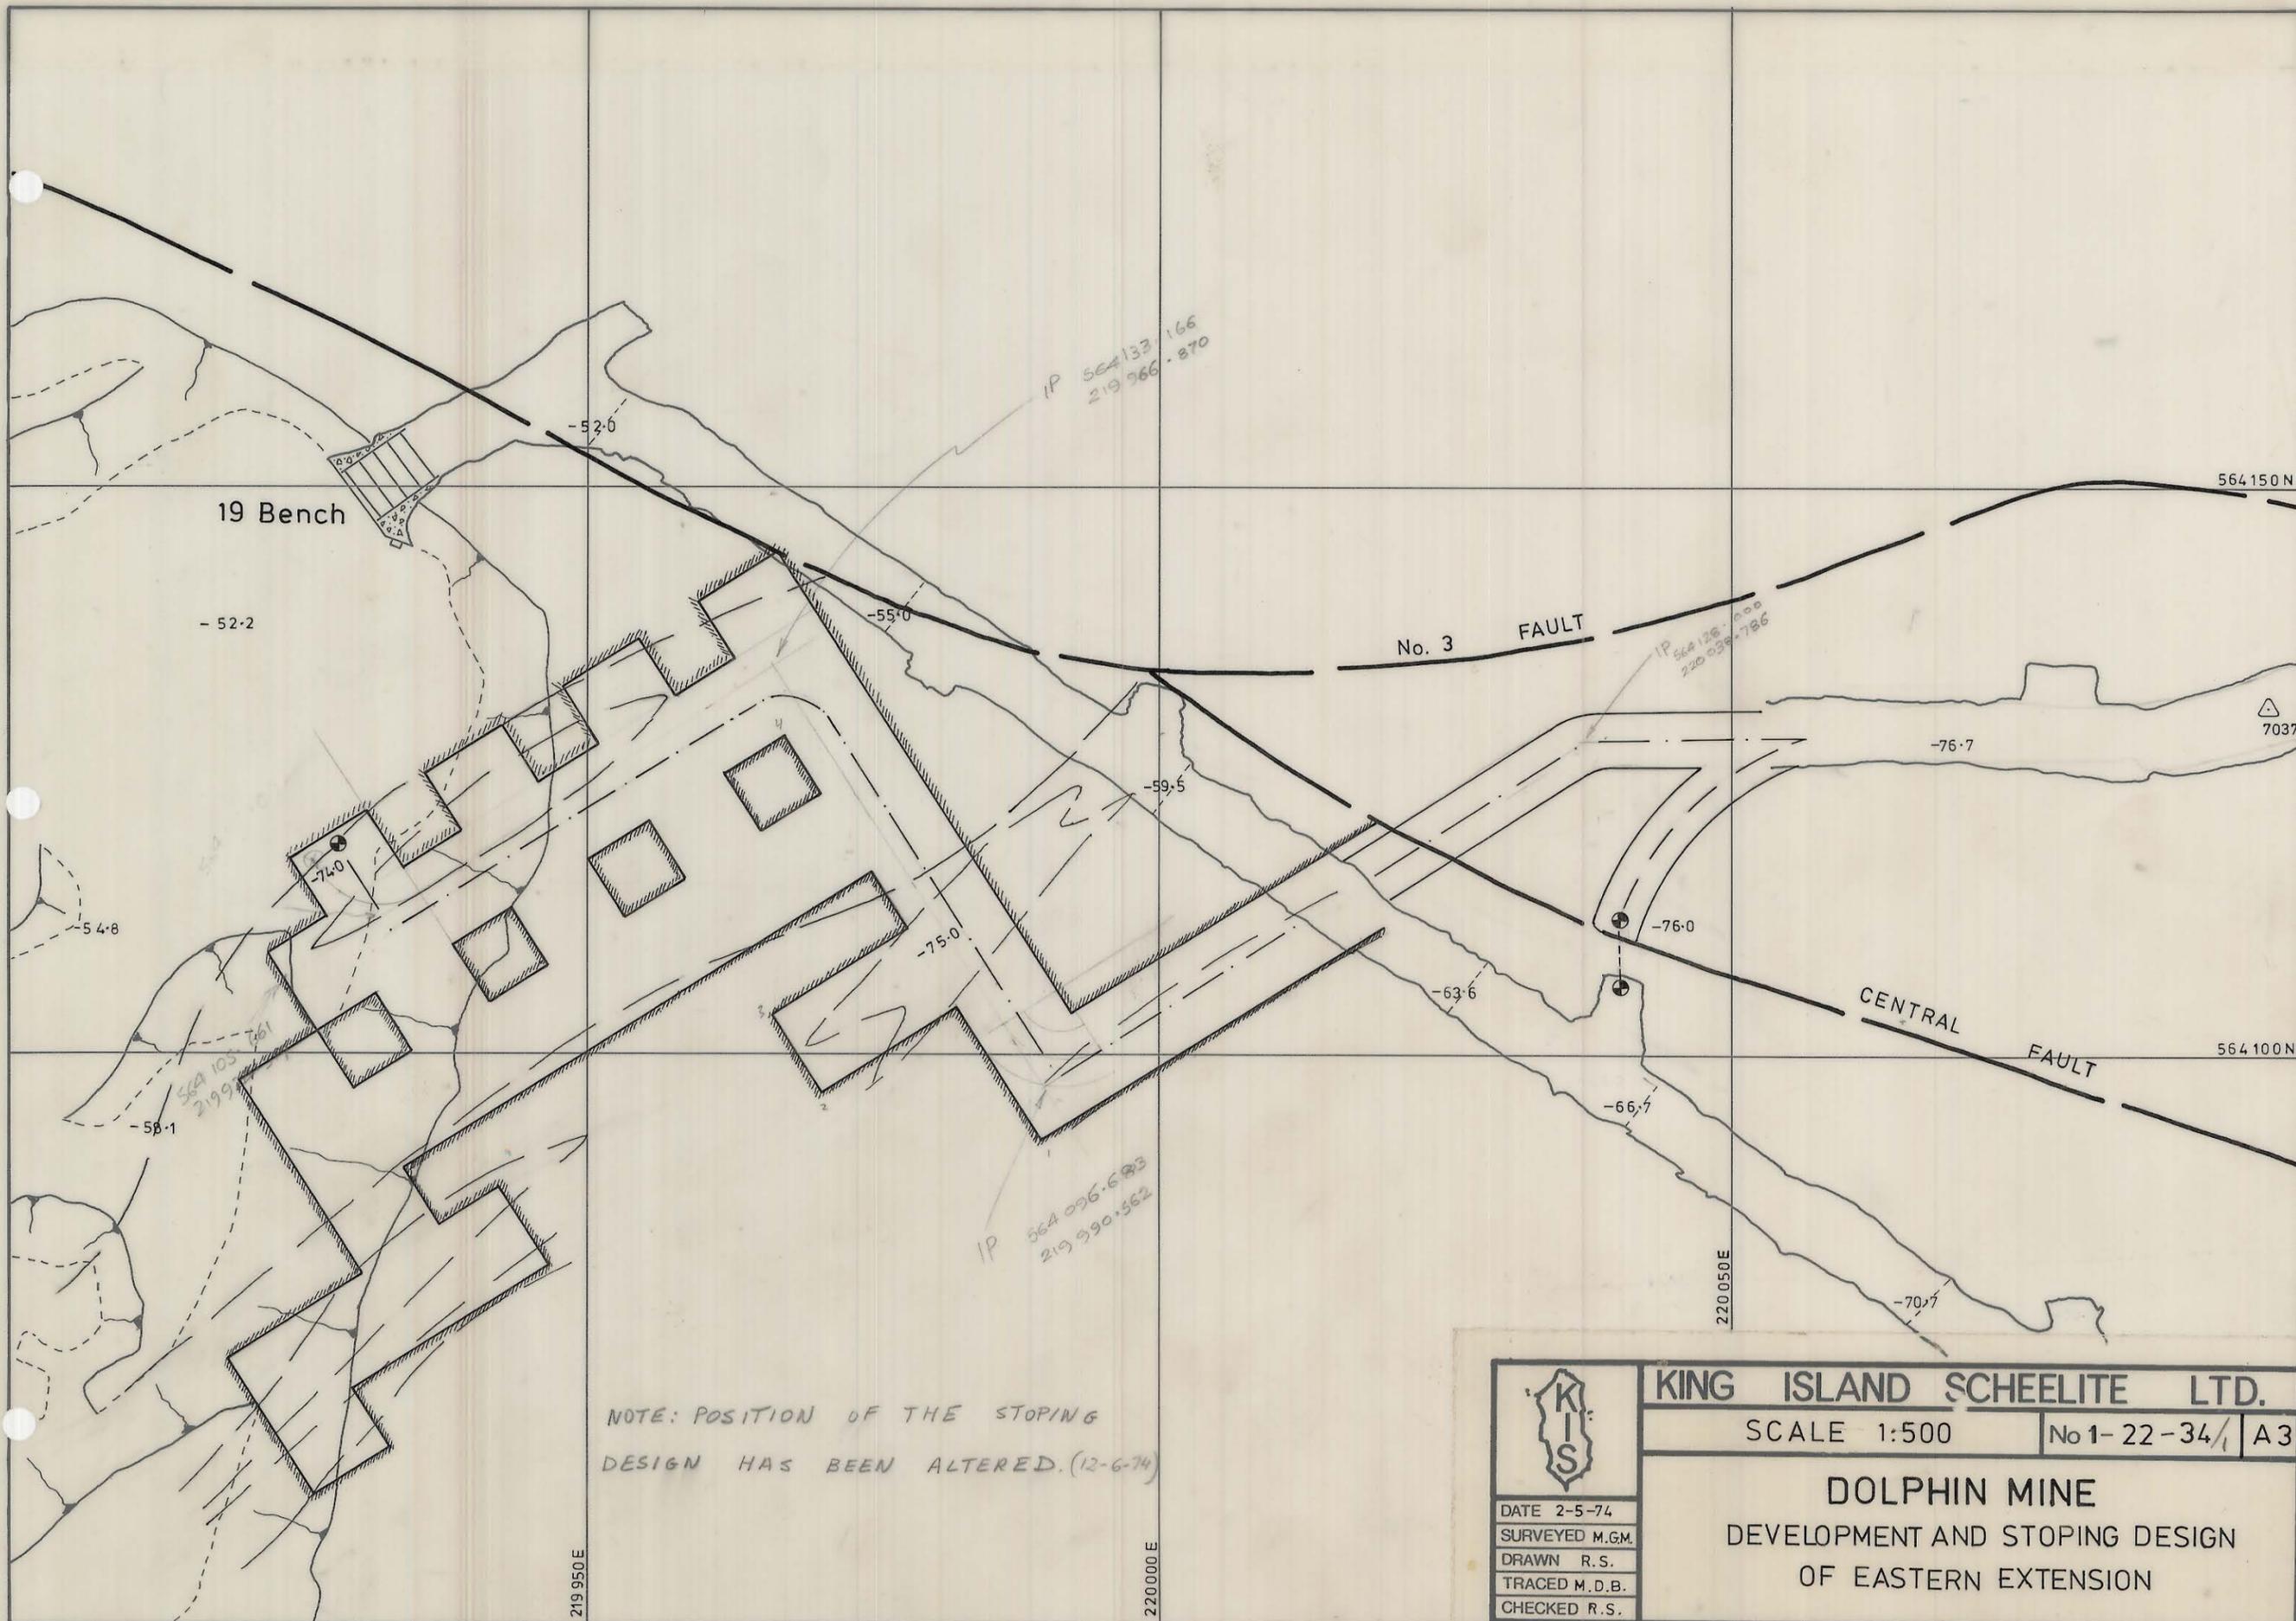

NOTE: POSITION OF THE STOPING DESIGN HAS BEEN ALTERED. (12-6-74)

	<b>KING ISLAND SCHEELITE LTD.</b>	
	SCALE 1:500	No 1-22-34/1 A3
<b>DOLPHIN MINE</b> DEVELOPMENT AND STOPING DESIGN OF EASTERN EXTENSION		
DATE 2-5-74		
SURVEYED M.G.M.		
DRAWN R.S.		
TRACED M.D.B.		
CHECKED R.S.		