



5 cm

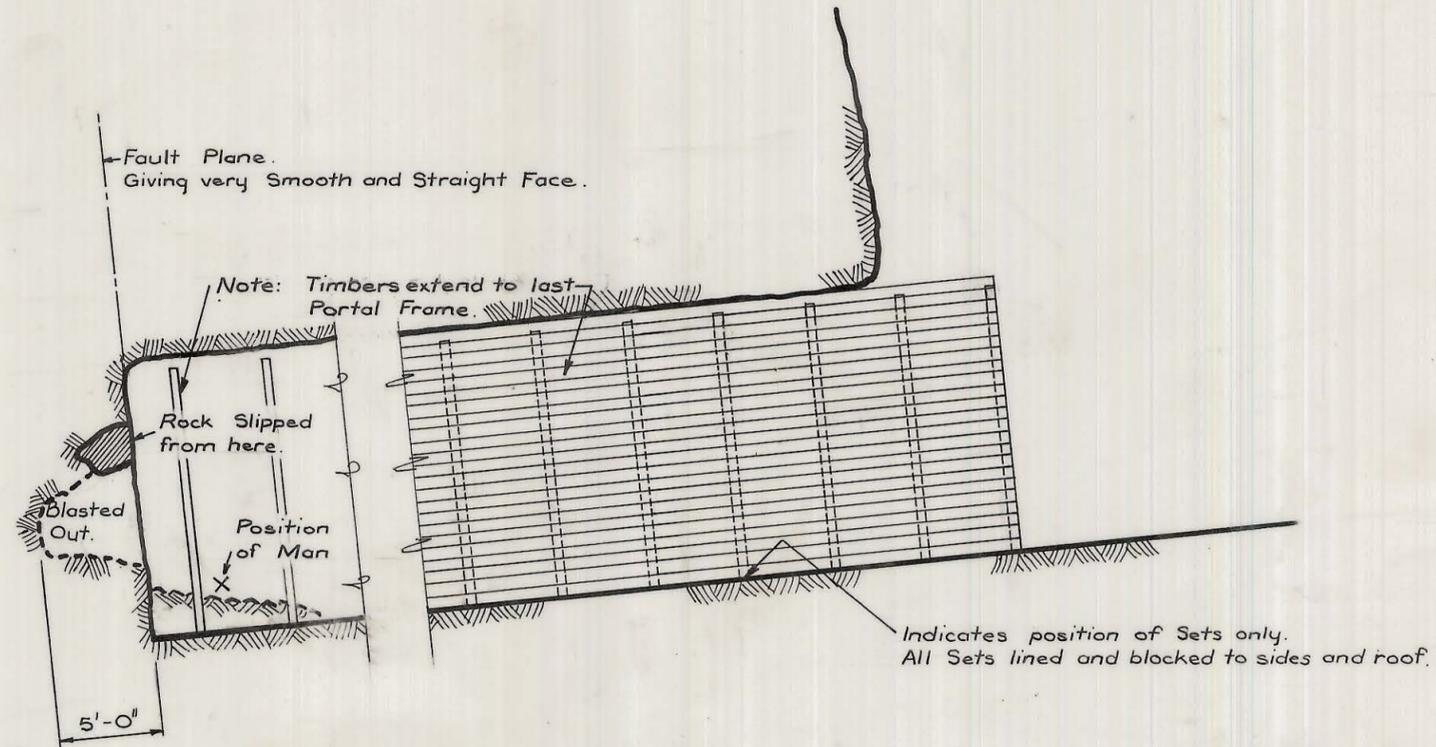

SIDE ELEVATION

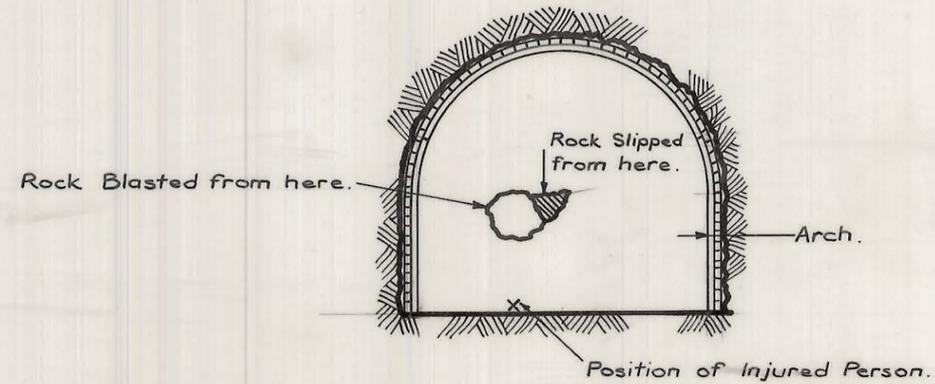

ELEVATION OF FACE

DATE 17-10-72.
SURVEYED
DRAWN S. Saville.
TRACED
CHECKED

KING ISLAND SCHEELITE LTD.

Scale 1"=100. No 1-

PLAN OF ACCIDENT  
BOLD HEAD MINE  
ON 6-10-72