


5 cm

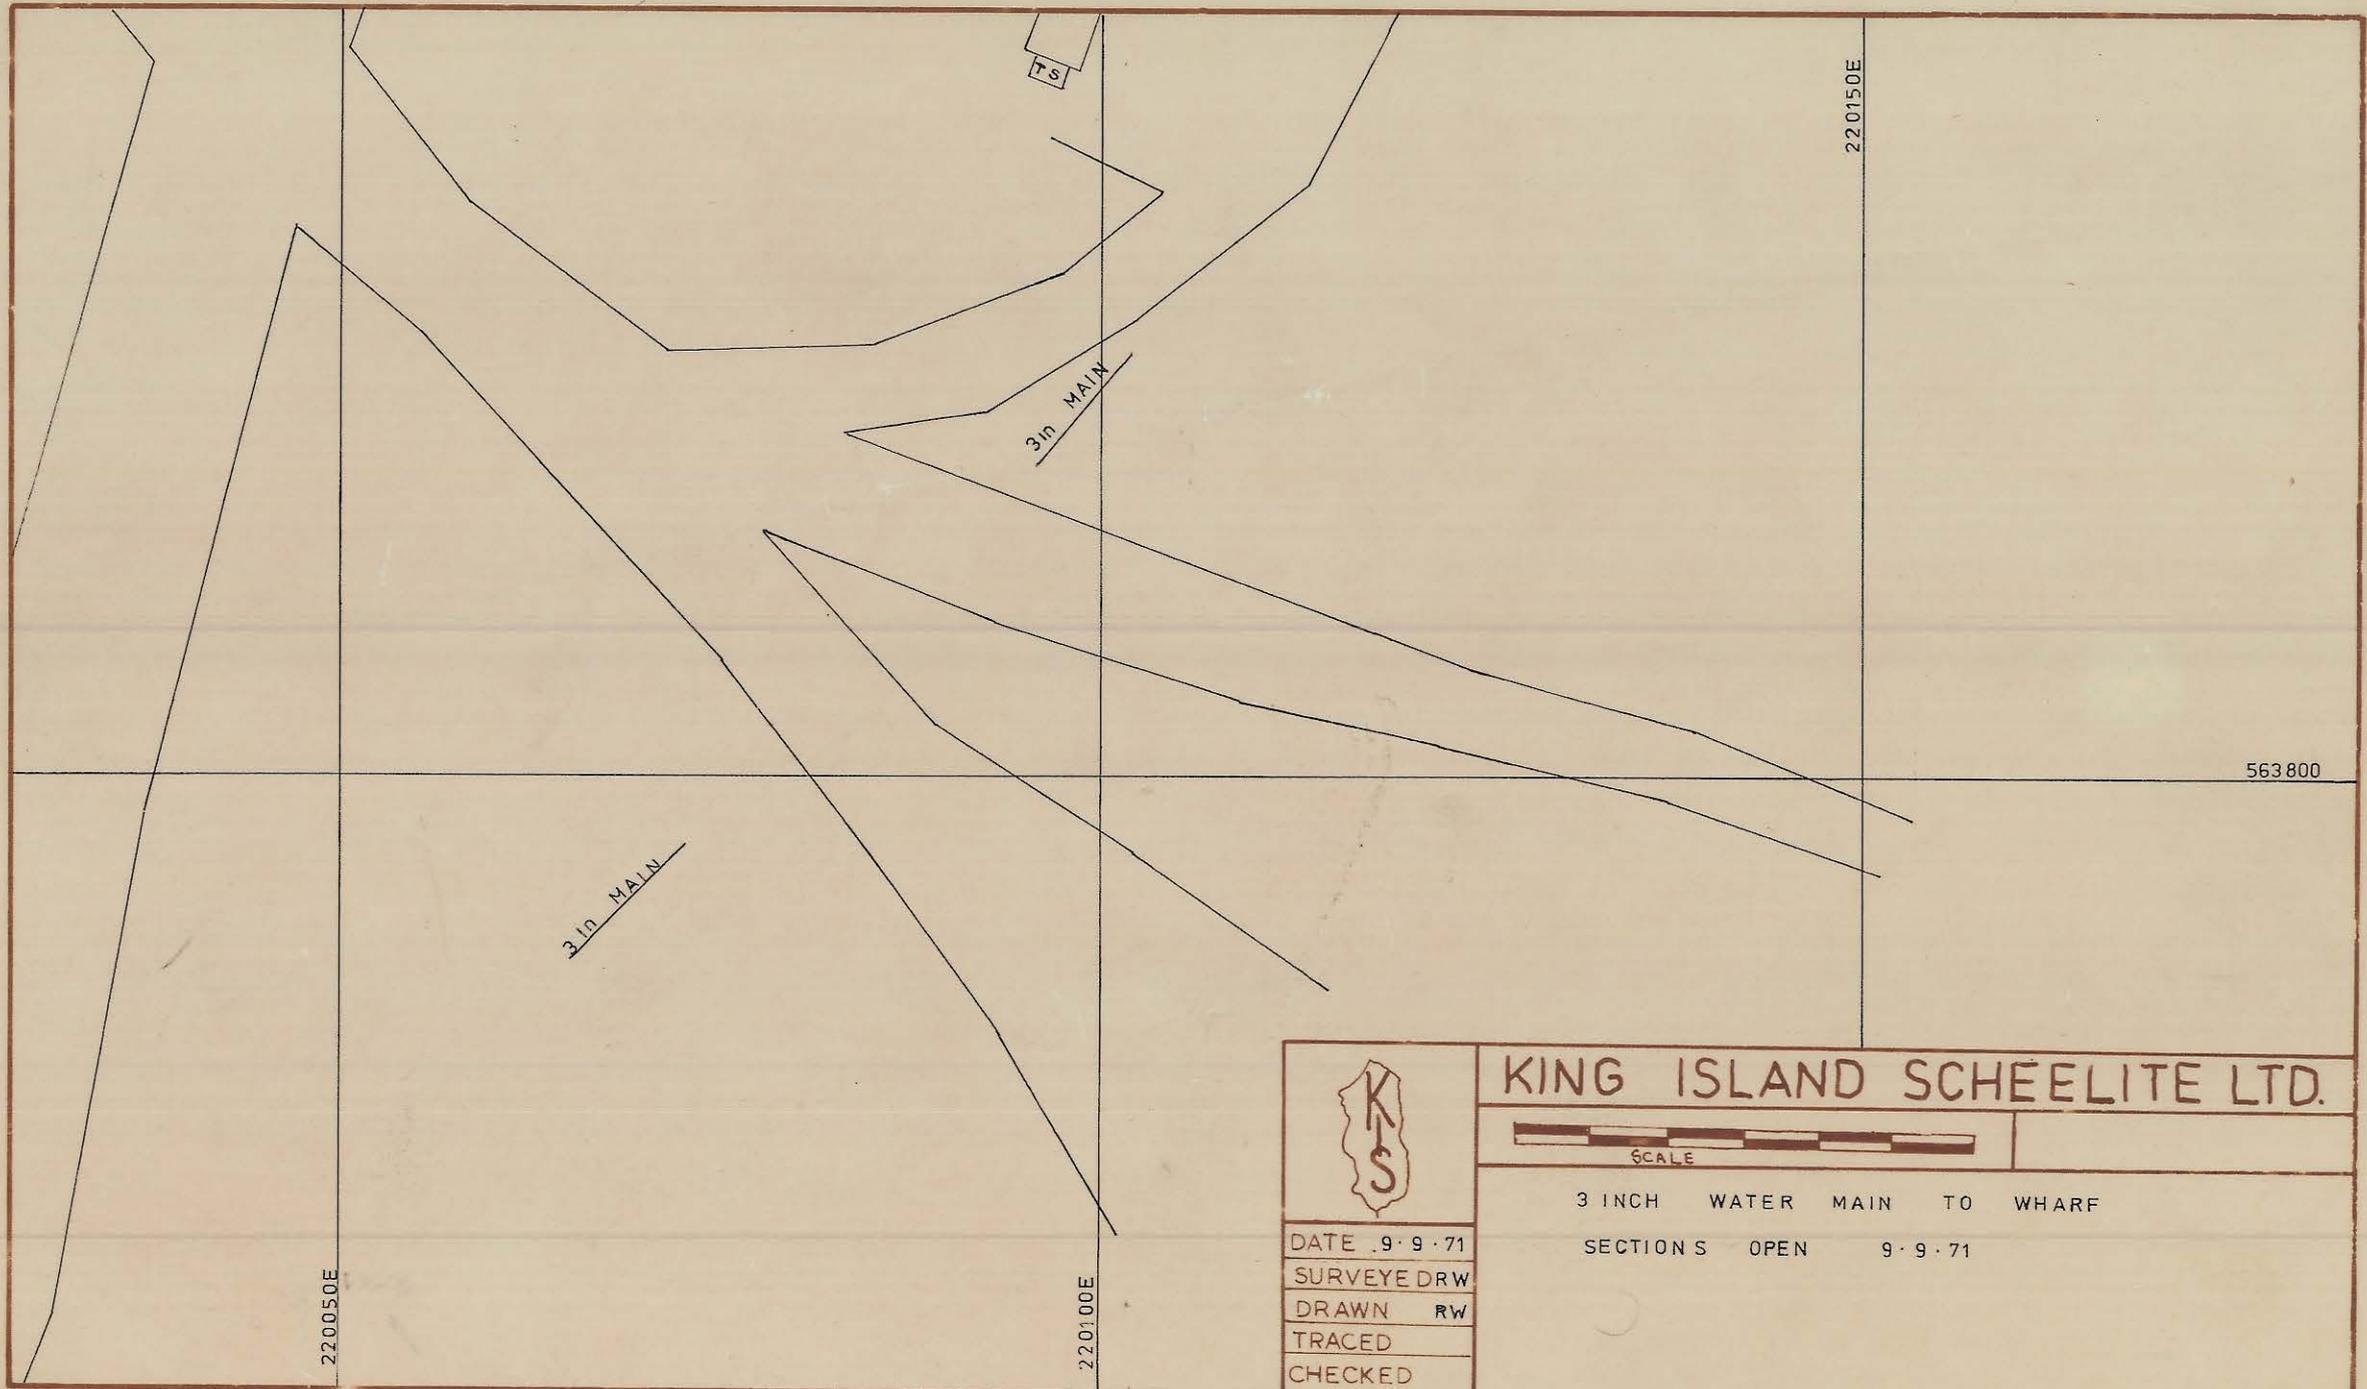

	KING ISLAND SCHEELITE LTD.	
	 SCALE	
	3 INCH WATER MAIN TO WHARF	
	SECTIONS OPEN 9.9.71	
	DATE 9.9.71	
SURVEYED BY		
DRAWN RW		
TRACED		
CHECKED		