



0374_2747

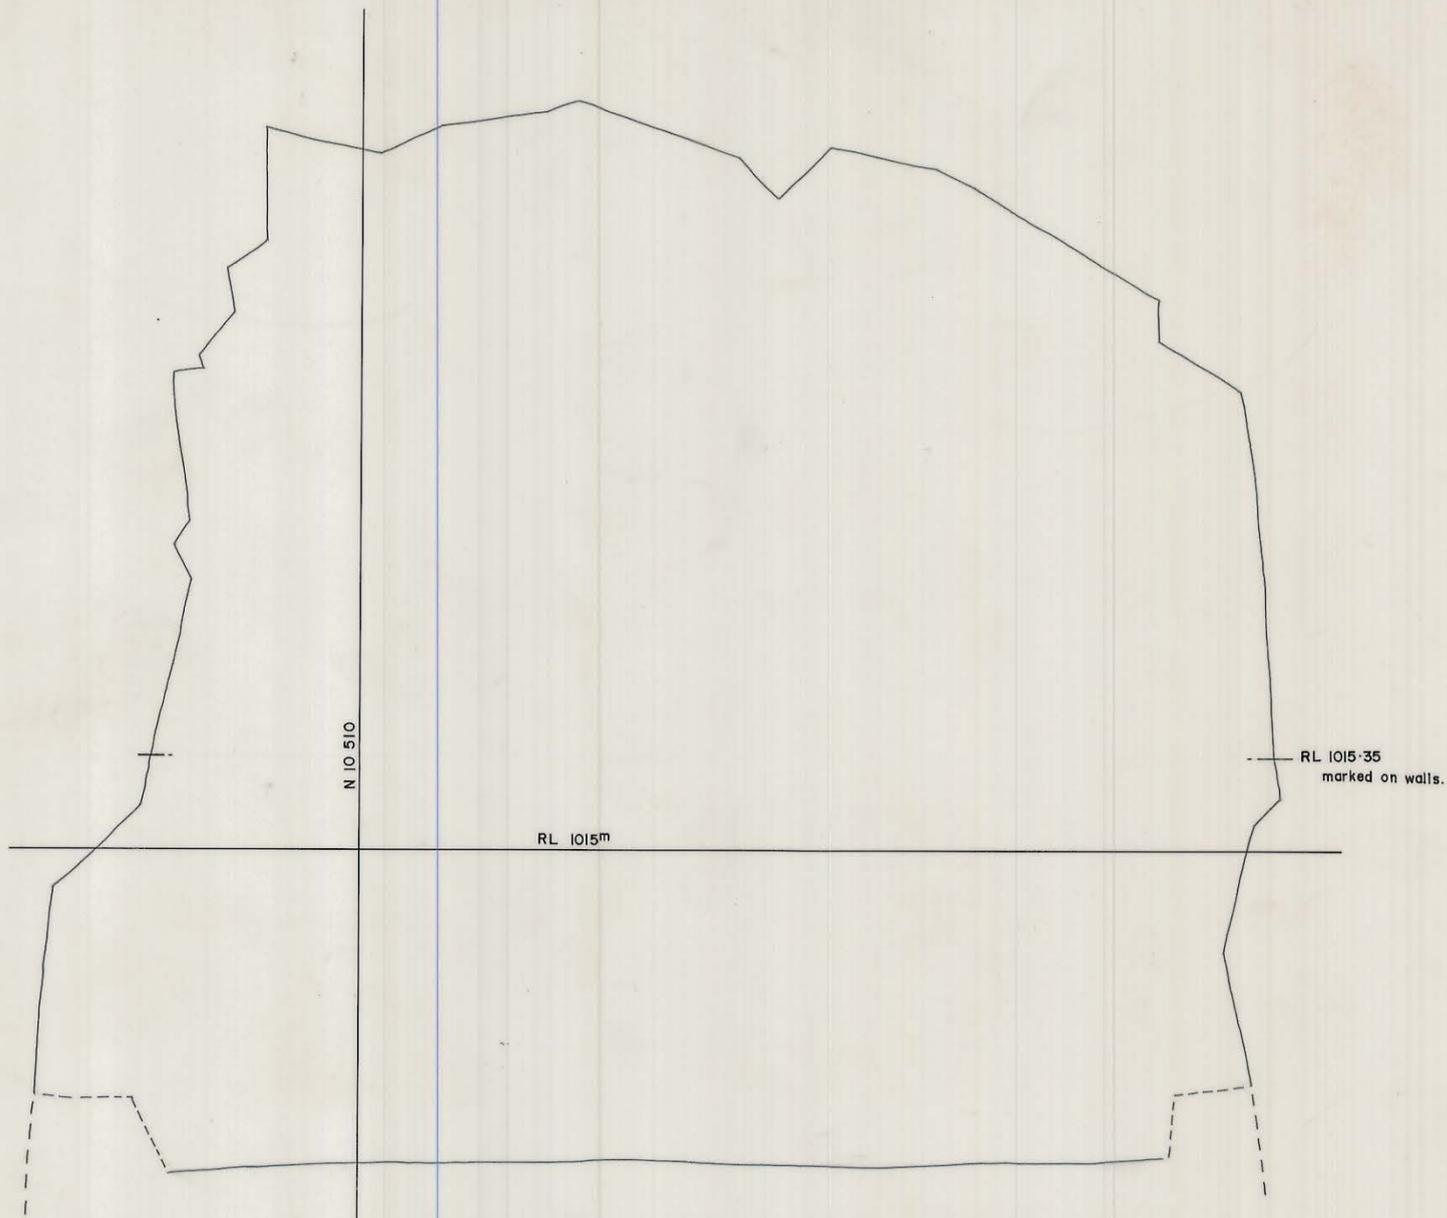

SECTION LOOKING EAST
Scale 1:25

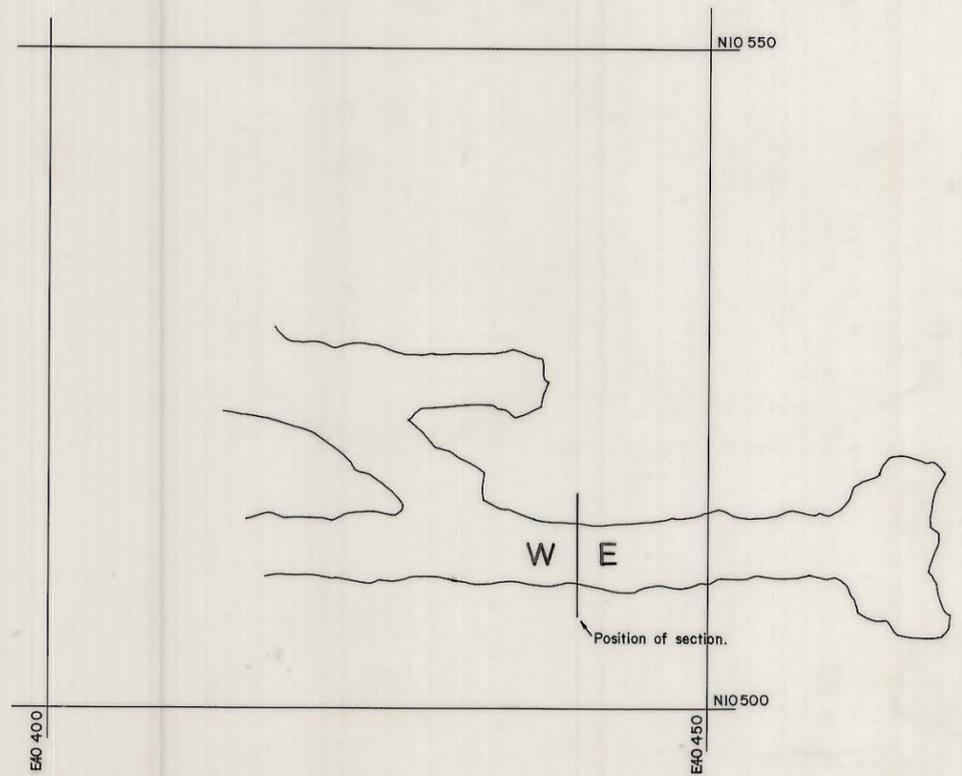

Locality Plan. Scale 1:500

	KING ISLAND SCHEELITE LTD.	
	Scale	No 1-
DATE 20.5.75	BOLD HEAD MINE E10 440 VENT X-SECTION	
SURVEYED J.Cook.		
DRAWN J.Cook.		
TRACED		
CHECKED		