

KING ISLAND SECTION F LOT 7

AREA = 529a. 1r. 22p.

SCALE = 1 inch equals 10 chains.

CHARTED BY J.G. PATESON SEPT. 1955.
dimensions in links

HISTORY

CLEARING 395 acs., 1952, 16 acs., 1953.

PLOUGHED 334 acs. 1952, 72 acs. 1953, 5 acs. not further developed.

SEEDED 1952. 85 acs } with 1½ cwt. Cu. super per ac.
1953. 83 acs }
1954. 238 acs. aut. with 2½ cwt. Cu. super per ac.

TOP DRESSED 1953. 85 acs with 1 bag plain super per ac.
1954. 168 acs with 1 bag plain super per ac. (30 bags plain super & 220 bags Cobalt super supplied)


1955. 69 bags plain & 180 bags Cobalt super supplied.
1956. 306 bags plain super supplied.
1957. 56 bags plain super supplied.

LIME & RE SEED 1955. 120 acs. limed & re-seeded.
1956. 52 acs. limed [part paddocks A & G]

RE DEVELOPED 1964. 56.8 acs. cleared 335.6 acs. ploughed Sept/Dec [A1. 25.9 acs. A2, A3, 28 acs. B1 5.3 acs B2, B4, C, D1, D2, E, G and 3.0 acs. F].
1965. 2.8 acs. B1 ploughed Feb 338.4 acs cultivated & re-cultivated and 218.1 acs. seeded Aut. with lime sand and 3cwt. Cu. Co. super per ac. pdks B1, 18.8 acs. B4, C, D1, D2, E, 3.0 acs. F and G Potash applied to pdks A1, B1, B4, & E. 122.4 acs. 20 acs. Ploughed Oct/Nov [pdk C] 28.6 cultivated and 85.7 acs re-cultivated Oct/Nov [pdks A1 A2 A3 B4 and C] Continued below.

	Scrub & Or Non Arable	Pasture	Total
A1	0.6	26.7	27.3
A2	0.5	26.4	26.9
A3	0.8	23.1	23.9
A4	0.6	29.8	30.4
B1	0.8	30.8	31.6
B2	1.6	28.3	29.9
B3	1.0	26.4	27.4
B4	0.3	27.4	27.7
C	6.9	64.9	71.8
D1	6.5	22.1	28.6
D2	4.8	36.0	40.8
E	3.4	37.5	40.9
F	13.3	16.4	29.7
G	8.3	35.7	44.0
H	10.4	21.4	31.8
J		1.5	1.5
K	0.3	8.9	9.2
L	1.8	4.2	6.0
	61.9	467.5	529.4
Plus	102.5	79.7	182.2
1966.	134.3		
	164.4	547.2	711.6

SECTION F LOT 7
REVISED CHART DRAWN NOV. 1964. CWG.

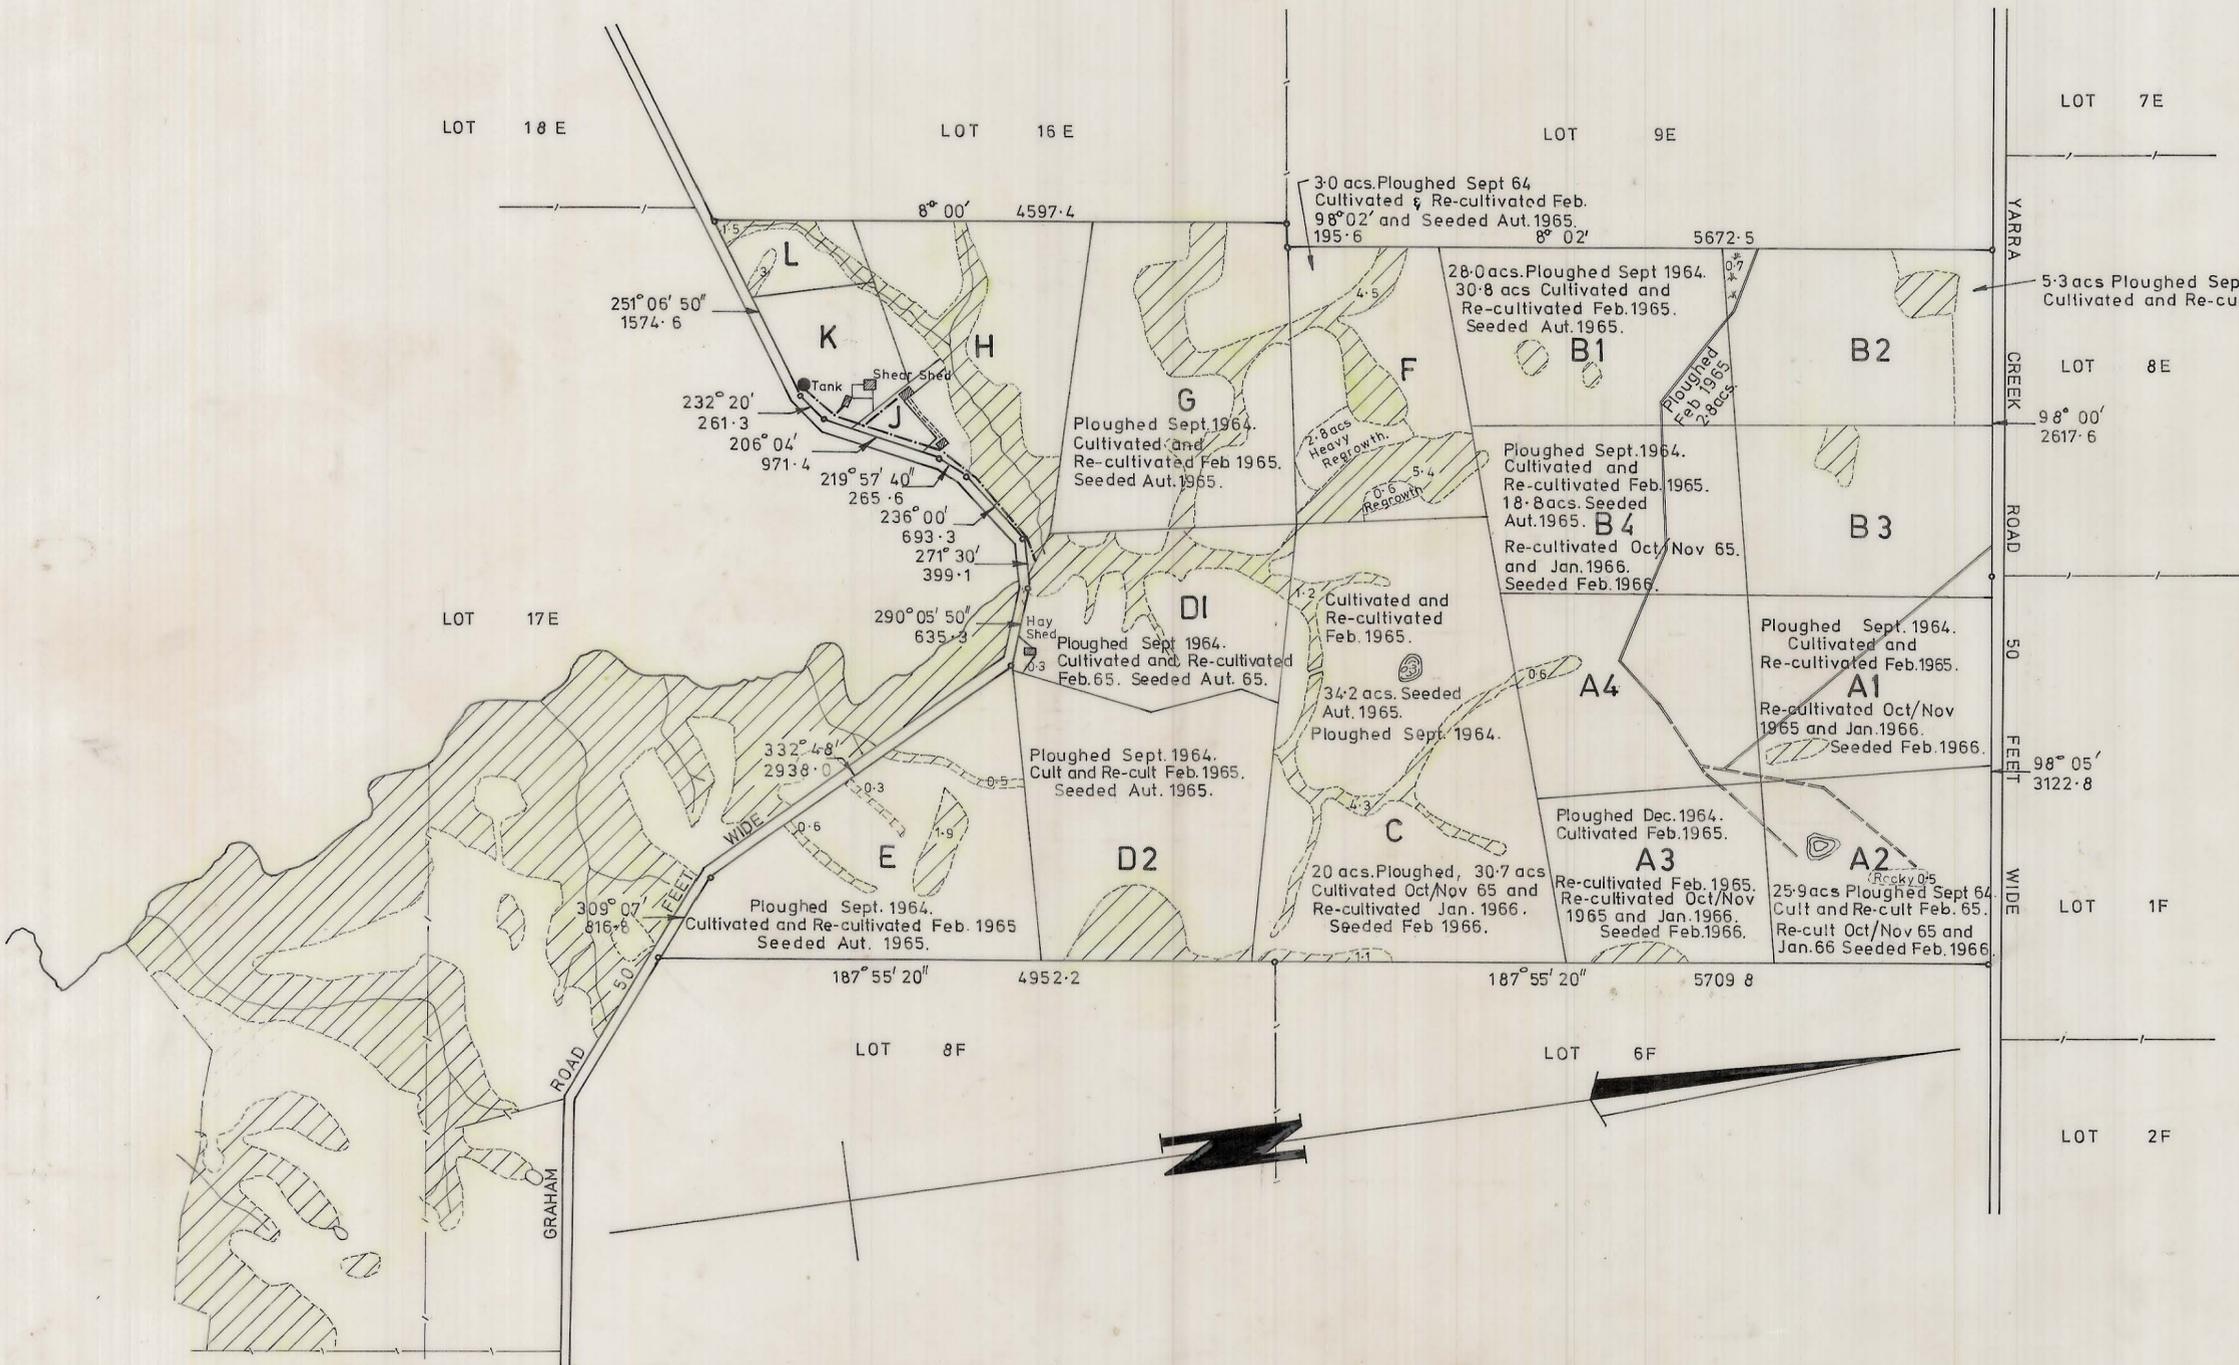

1 inch = 10 chains
SECTION F
LOT 7
1-12-17

11G002 - X010

0374_2751

5 cm

1-12-17