

KING ISLAND SECTION F LOT 7


AREA : 529^a 1r 22p.

SCALE : 1 inch equals 10 chains.

CHARTED BY J.G. PATERSON SEPT. 1955.

HISTORY

CLEARED. 395 acs. 1952, 16 acs. 1953.
PLOUGHED. 334 acs. 1952, 72 acs. 1953, 5 acs. not further developed.
SEEDED. 1952. 85 acs. } with 1½ cwt. Cu. super per ac.
 1953. 83 acs. }
 1954. 238 acs. cut. with 2½ cwt. Cu. super per ac.
TOP DRESSED. 1953. 85 acs. with 1 bag plain super per ac.
 1954. 168 acs. with 1 bag plain super per ac. (30 bags plain super & 220 bags Cobalt super supplied).
 1955. 69 bags plain & 180 bags Cobalt super supplied.
 1956. 306 bags plain super supplied.
 1957. 56 bags plain super supplied.
LIME & RE-SEED. 1955. 120 acs. limed & re-seeded.
 1956. 52 acs. limed (part paddocks A & G).
RE-DEVELOPED. 1964. 56.8 acs. cleared, 335.6 acs. ploughed Sept./Dec. A1, 25.9 acs. A2, A3, 28 acs. B1, 5.3 acs. B2, B4, C, D1, D2, E, G and 3.0 acs. F.
 1965. 2.8 acs. B1 ploughed Feb., 338.4 acs. cultivated & re-cultivated and 219.1 acs. seeded cut. with lime sand and 3 cwt. Cu. Co. super per ac. (pdk. B1, 18.8 acs. B4, C, D1, D2, E, 3.0 acs. F and G). Potash applied to pdks. A1, B1, B4 & E. (122.4 acs.). 20 acs. Ploughed Oct./Nov. (pdk C); 28.6 cultivated and 85.7 acs. re-cultivated Oct./Nov. (pdk. A1, A2, A3, B4 and C).
 Continued below.

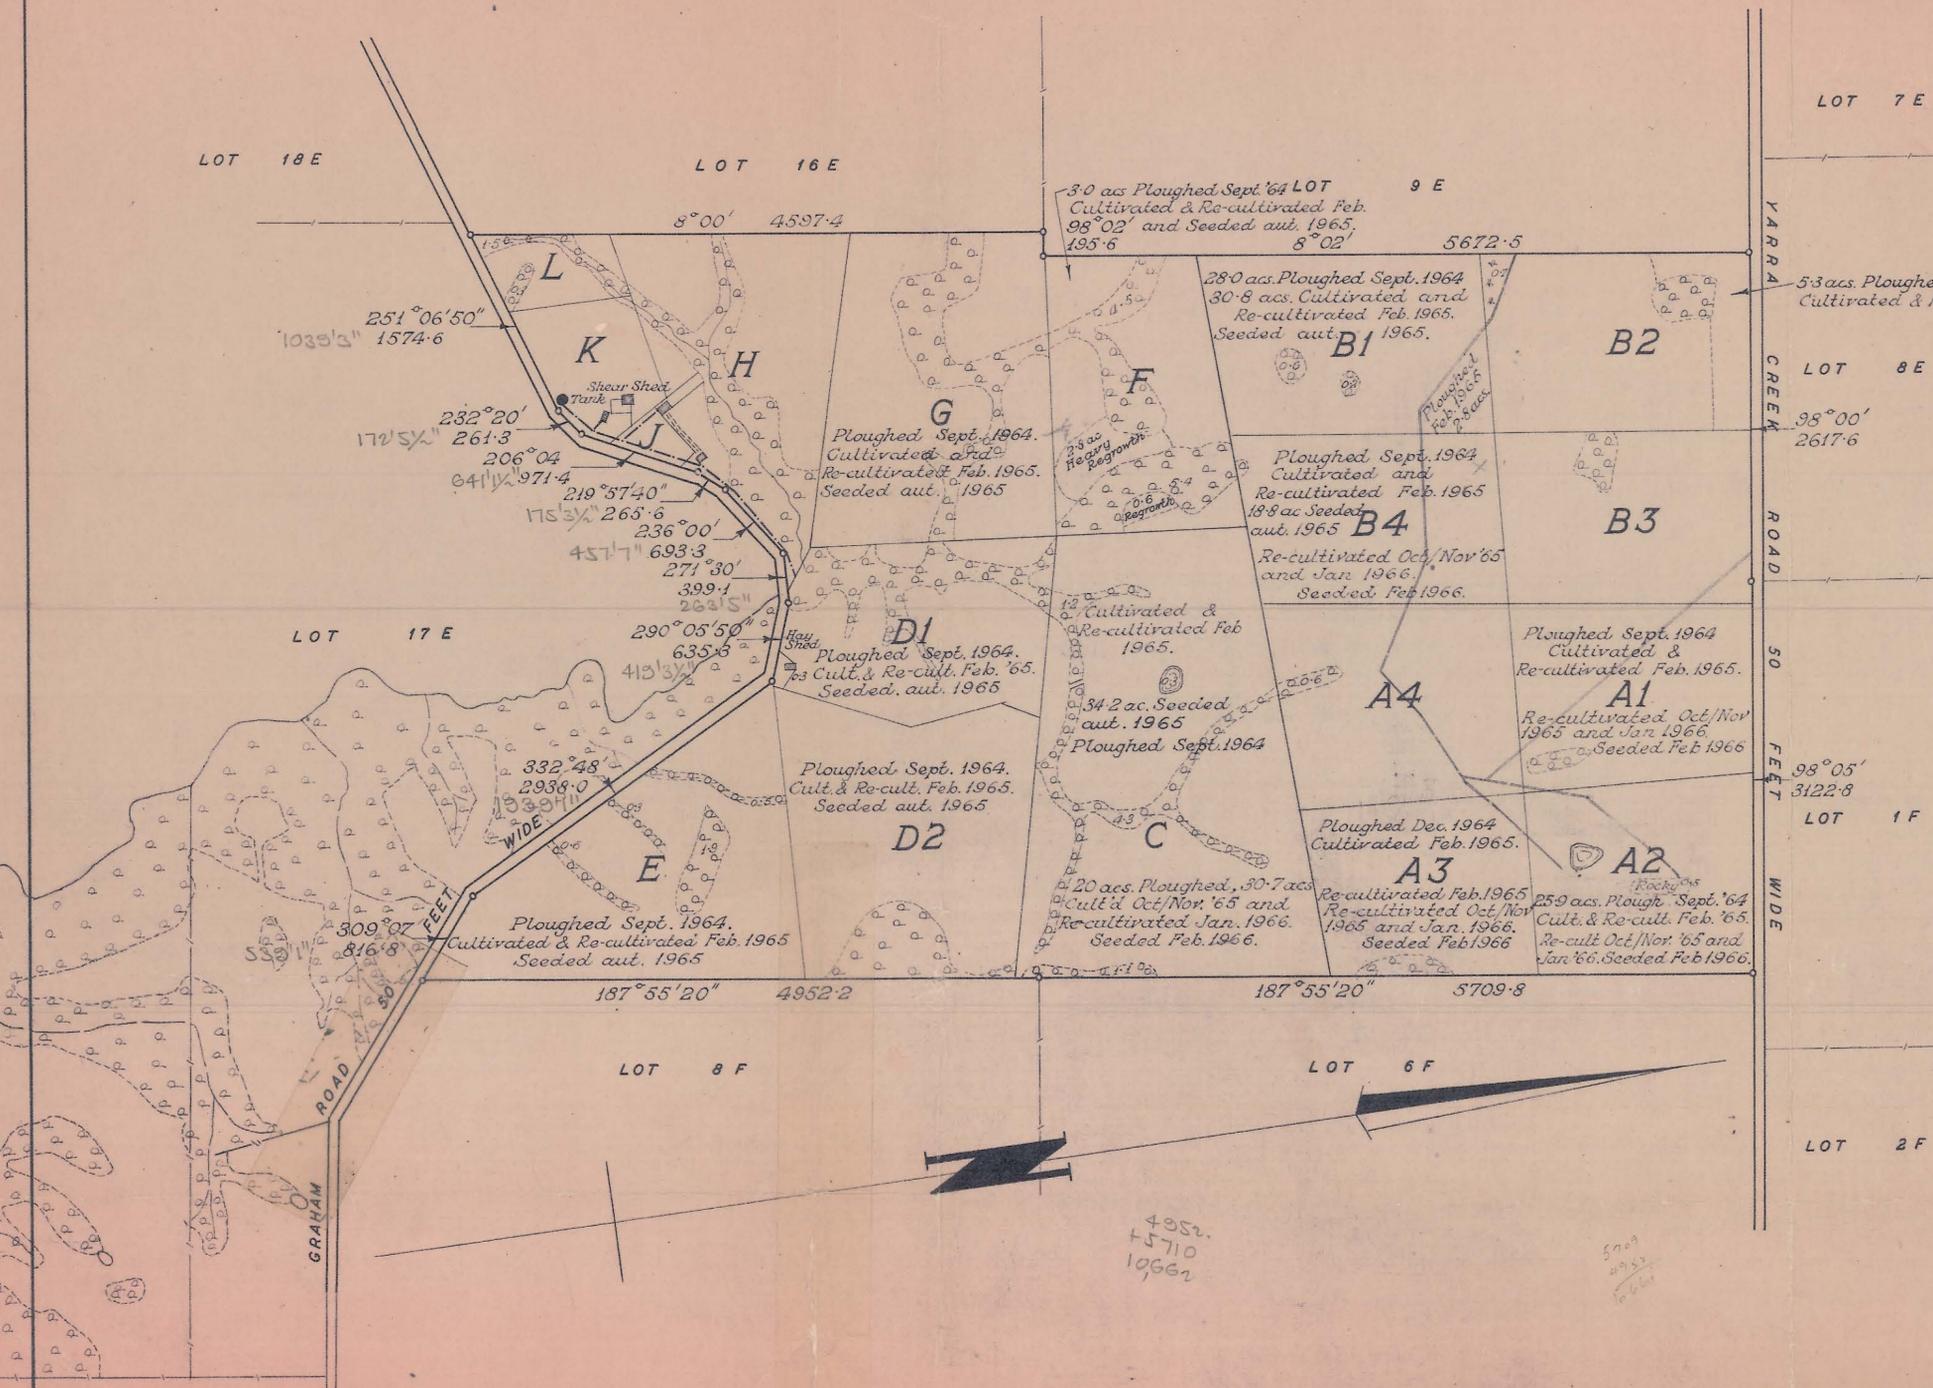

	SCRUB &/OR NON ARABLE	PASTURE	TOTAL
A1	0.6	26.7	27.3
A2	0.5	26.4	26.9
A3	0.8	23.1	23.9
A4	0.6	29.8	30.4
B1	0.8	30.8	31.6
B2	1.6	28.3	29.9
B3	1.0	26.4	27.4
B4	0.3	27.4	27.7
C	6.9	64.9	71.8
D1	6.5	22.1	28.6
D2	4.8	36.0	40.8
E	3.4	37.5	40.9
F	13.3	16.4	29.7
G	8.3	35.7	44.0
H	10.4	21.4	31.8
J		1.5	1.5
K	0.3	8.9	9.2
L	1.8	4.2	6.0
	61.9	467.5	529.4
Plus	102.5	79.7	182.2
1966	134.3		
	164.4	547.2	711.6

(95 acs.)
 Plus 102.5 79.7 182.2 From Lot 17 E
 1966. 134.3 acs. re-cultivated Jan. & Seeded Feb. with lime sand, potash and 3 cwt. Cu. Co. super per ac. (pdk. A1, A2, A3, B4 and 30.7 acs. C).
 77.2 ~~46.6~~ 547.2 (625 acs.)

1" = 10 chains
 SECTION F
 Lot 7
 1-12-18

116D02 - X011
 0374_2757

