

PEGARAH ESTATE SECTION F LOT 8

LAND DISTRICT OF KING ISLAND PARISH OF KITTAWA

AREA 679a. Or. 27p. = 274.850 ha
 SCALE 1 inch equals 10 chains. = 1:7920

CHARTED BY R.E. CROCKETT 1965 PDKS A TO M
 1969 WHOLE AREA


HISTORY Pdk's N1 to S.

CLEARED & PLOUGHED 1952.
 SEEDED. 1953. 57 acs. with 1½ cwt. Cu. super per ac.
 1954. 6 acs. with 2½ cwt. Cu. super per ac.
 TOP DRESSED 1954. 57 acs. with 1 bag plain super per ac.
 1955 & 56. 66 acs. with 1 bag plain super per ac.
 1957. 66 acs. with 2 bags plain super per ac.
 LIME & RE-SEED. 1956. Pdk's Q and R re-seeded with lime and 2½ cwt. Cu.Co. super per ac.

CLEARED. 357 acs. 1952 and 24 acs. 1953.
 PLOUGHED. 79 acs. 1952 and 302 acs. 1953.
 SEEDED. 79 acs. aut. 1953 with 1½ cwt. Cu. super per ac. and 302 acs. aut. 1954 with 2½ cwt. Cu. super per ac.
 TOP DRESSED. 1954. 79 acs. with 1 bag plain super per ac.
 1955. 108 bags cobalt super and 206 bags plain super supplied.
 1956. 5 tons plain super supplied.
 1957. 17½ tons plain super supplied.
 1959. 22 tons 13 cwt. plain super supplied.

LIME & RE-SEED. 1955. 41 acs. limed and 101 acs. re-seeded aut.
 RE-DEVELOPED. 1965. 80 acs. cleared and 258.1 acs. ploughed Nov./Dec. (pdk's G2, H1, 2, 4, 5, 6, 8, J1, 2, K5, 8, 9, 10, L3 and M).
 1966. 50 acs. re-ploughed. 258.1 acs. cultivated & re-cultivated. 248.5 acs. seeded aut. with lime sand and 3 cwt. Cu.Co. super per ac. (pdk's G2, H1, 2, 4, 6, 8, J1, 2, K8, 9, 10, L3 and M).

118D02-X01Z
 0374_2758

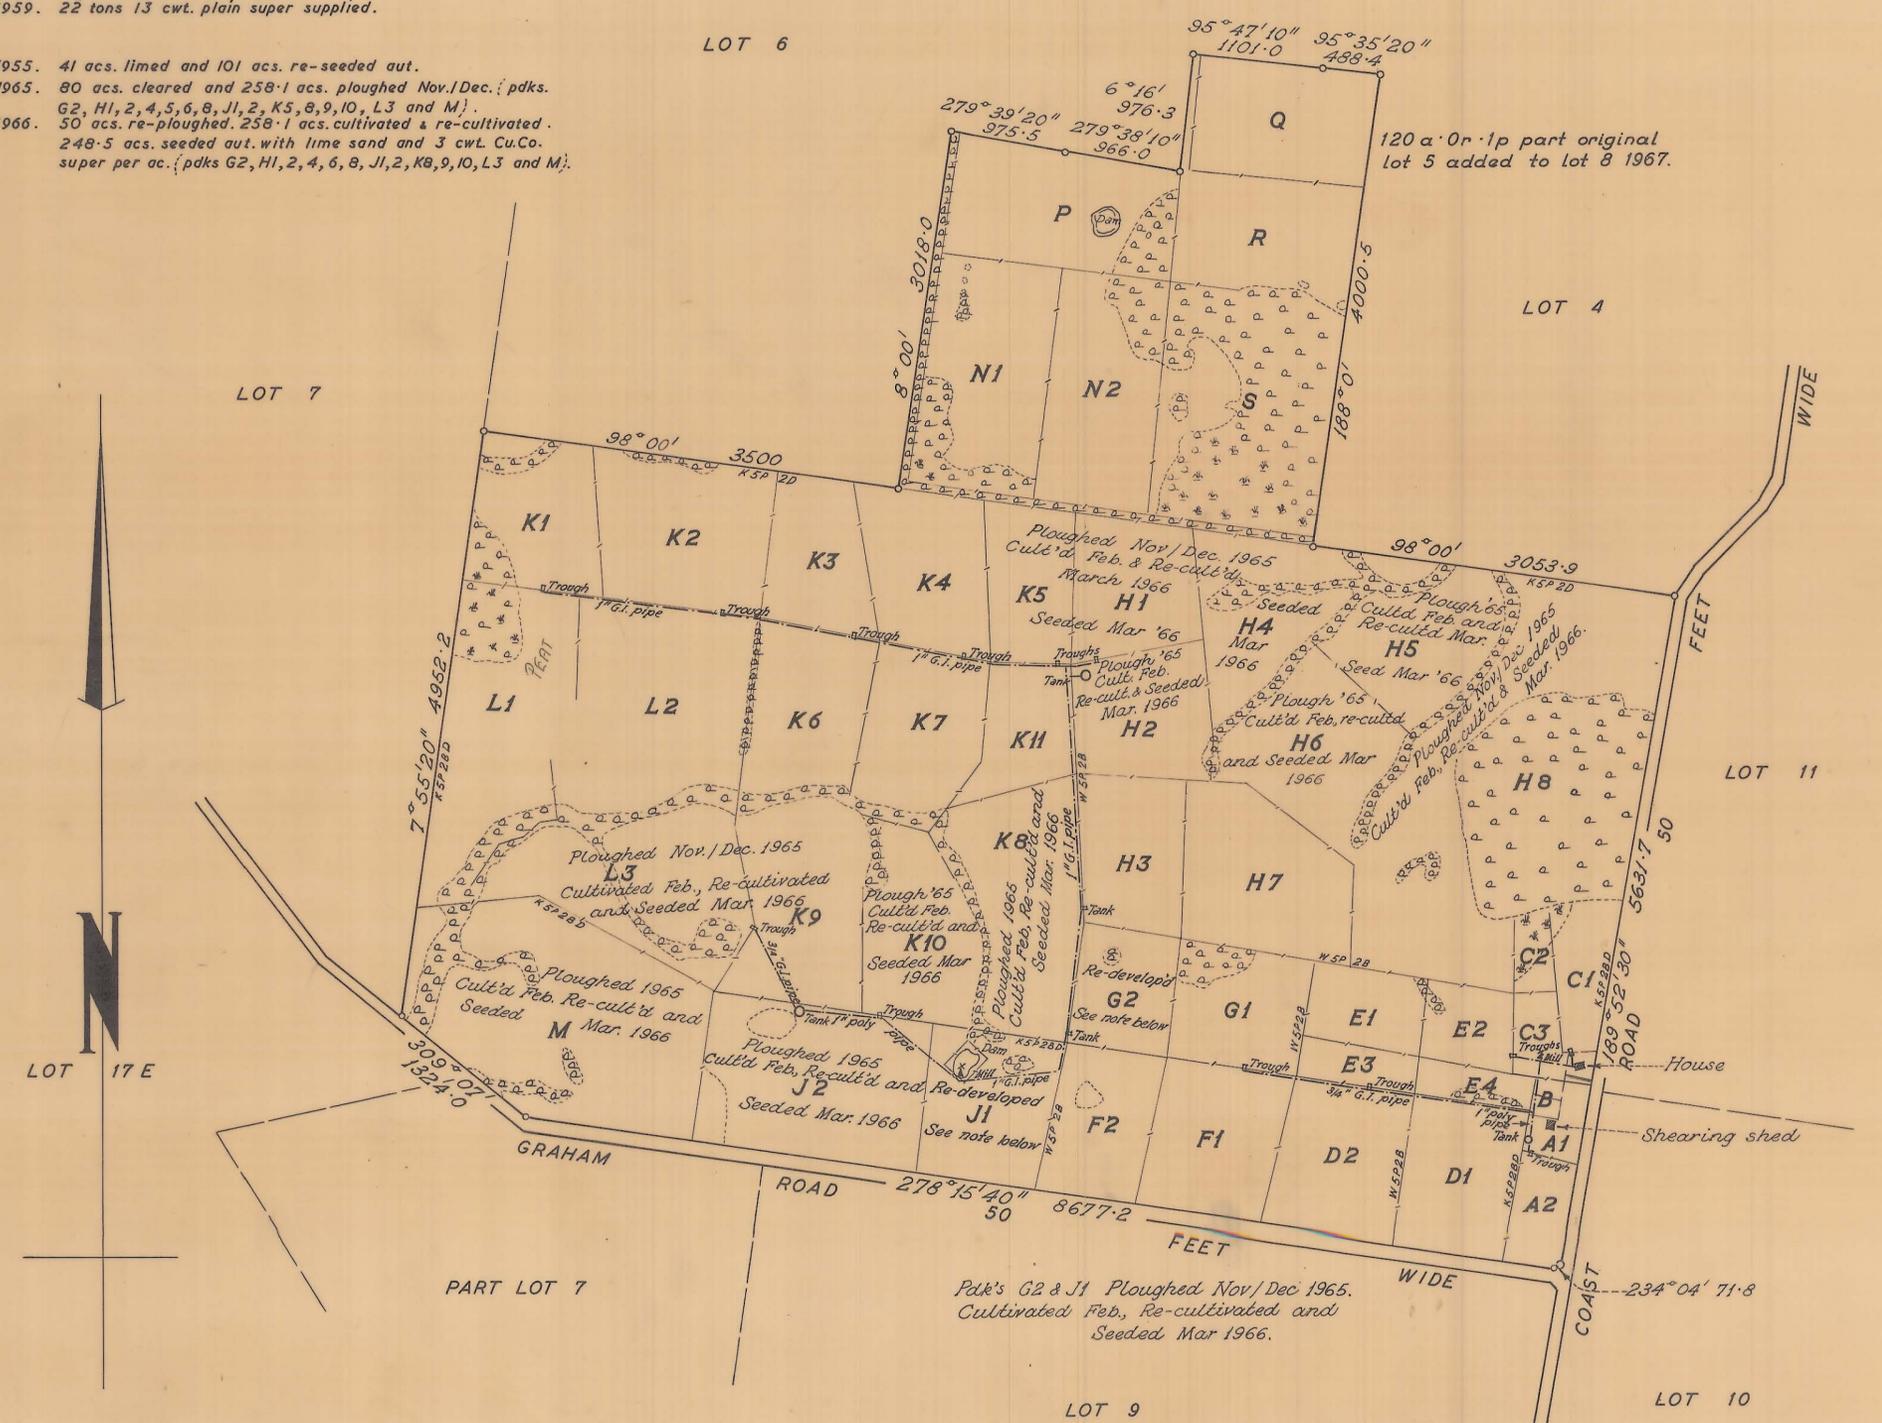

| | SCRUB &/OR NON ARABLE | PASTURE | TOTAL |
|--------------|--------------------------|--------------|--------------|
| A1 | | 2.3 | 2.3 |
| A2 | | 4.4 | 4.4 |
| House | 0.6 | | 0.6 |
| B | | 0.8 | 0.8 |
| C1 | 0.3 | 5.6 | 5.9 |
| C2 | 1.3 | 0.8 | 2.1 |
| C3 | | 2.9 | 2.9 |
| D1 | | 11.6 | 11.6 |
| D2 | | 12.7 | 12.7 |
| E1 | 0.1 | 5.7 | 5.8 |
| E2 | 0.2 | 4.8 | 5.0 |
| E3 | | 2.9 | 2.9 |
| E4 | 0.6 | 2.5 | 3.1 |
| F1 | 0.4 | 9.9 | 10.3 |
| F2 | | 13.3 | 13.3 |
| G1 | 1.8 | 9.0 | 10.8 |
| G2 | | 8.2 | 8.2 |
| H1 | | 11.5 | 11.5 |
| H2 | 0.2 | 11.4 | 11.6 |
| H3 | 10.8 | | 10.8 |
| H4 | 2.0 | 12.6 | 14.6 |
| H5 | 1.3 | 14.2 | 15.5 |
| H6 | 0.5 | 15.6 | 16.1 |
| H7 | 17.2 | | 17.2 |
| H8 | 26.6 | 34.4 | 61.0 |
| J1 | 1.0 | 12.3 | 13.3 |
| J2 | 2.1 | 21.3 | 23.4 |
| K1 | 2.9 | 10.5 | 13.4 |
| K2 | 0.6 | 17.4 | 18.0 |
| K3 | | 10.4 | 10.4 |
| K4 | | 13.3 | 13.3 |
| K5 | | 9.6 | 9.6 |
| K6 | 0.4 | 13.5 | 13.9 |
| K7 | 0.5 | 12.6 | 13.1 |
| K8 | 1.0 | 18.8 | 19.8 |
| K9 | 0.7 | 17.5 | 18.2 |
| K10 | 2.0 | 12.3 | 14.3 |
| K11 | | 7.9 | 7.9 |
| L1 | 5.8 | 17.2 | 23.0 |
| L2 | 1.3 | 25.5 | 26.8 |
| L3 | 2.9 | 18.9 | 21.8 |
| M | 4.0 | 33.5 | 37.5 |
| N1 | 4.1 | 15.9 | 20.0 |
| N2 | 2.8 | 15.9 | 18.7 |
| Q | | 15.2 | 15.2 |
| R | 0.1 | 14.9 | 15.0 |
| S | 24.4 | 4.5 | 28.9 |
| Shelters | 3.2 | | 3.2 |
| TOTAL | 126.5 | 552.6 | 679.1 |

ORIGINAL LOT 8 F
 559a. Or. 26p

P-190a.
 ADDITION, FORMERLY
 PART OF LOT 5 F.
 120a. Or. 1p

NEW SUBDIVISION SECTION F LOT 8

CHART REVISED MAY 1960. FEB. 1966 & DEC. 1970. C.W.G.