


NOTE: PART PLAN COPIED FROM CHECK SURVEY BY R THORNE 5-2-1971
LEVELS ARE RELATIVE TO MINE DATUM (ALSO DANE CHAN AT OLD STONE JETTY R.L. 13.83)

SITE PLAN.
SCALE: 100'-0" TO 1"


NOTE:
WHITE MARKER STAKES WITH LETTER PRINTED BROWN ARE AT REAR OF DATUM PEG.

DISTANCE OF MARKER STAKE REAR OF DATUM PEG.	COMPASS BEARING OF SECTION FROM MARKER STAKE.
SECTION A 40 FT.	170 DEGREES
SECTION B 100 FT.	180 "
SECTION C 55 FT.	170 "
SECTION D 40 FT.	170 "


AS CONSTRUCTED
RESIDENT UNKNOWN

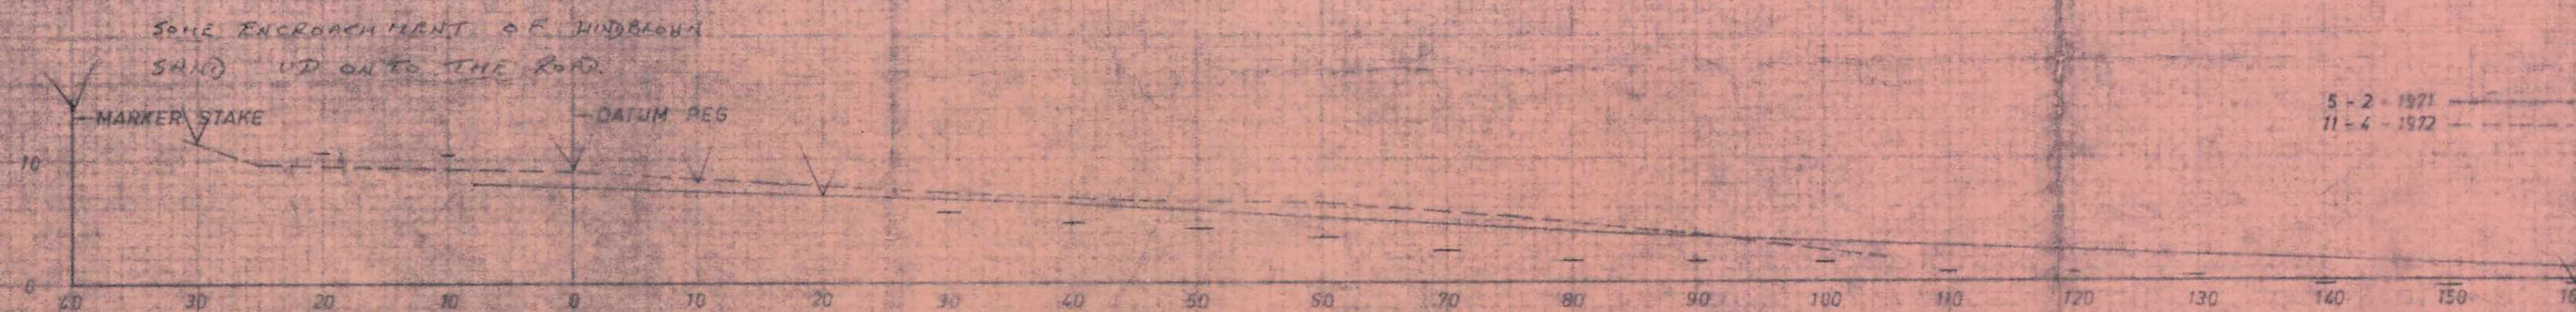


SECTION A

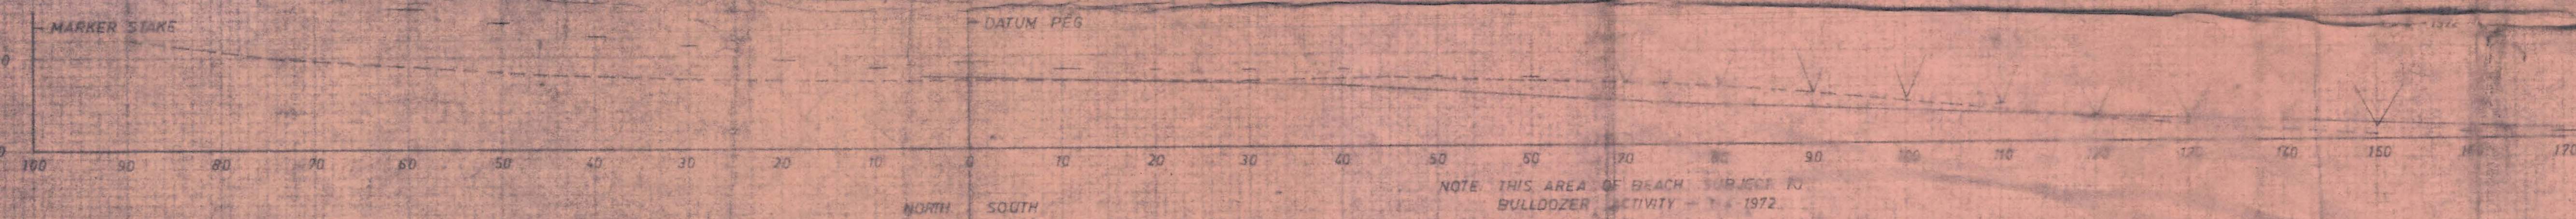

SECTION B

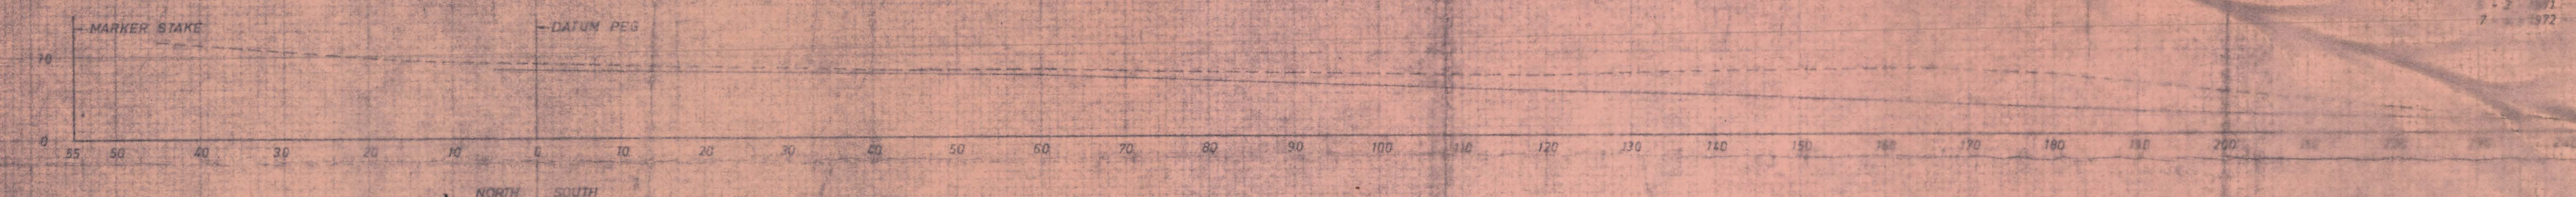

SECTION C

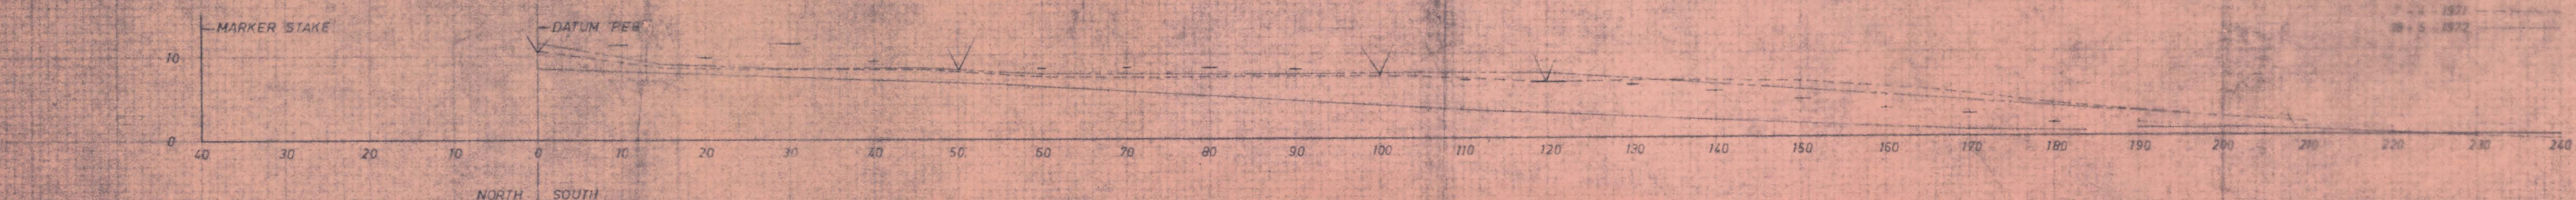

SECTION D

SCALE: 10'-0" TO 1"

K.I.S. - GRASSY PORT.
LOCATION OF CHECK SECTIONS.
SK 2070/RE/42

54

139/0508