


7 12 10
KING ISLAND SCHEELITE LTD.
1-5-21

0374_2769

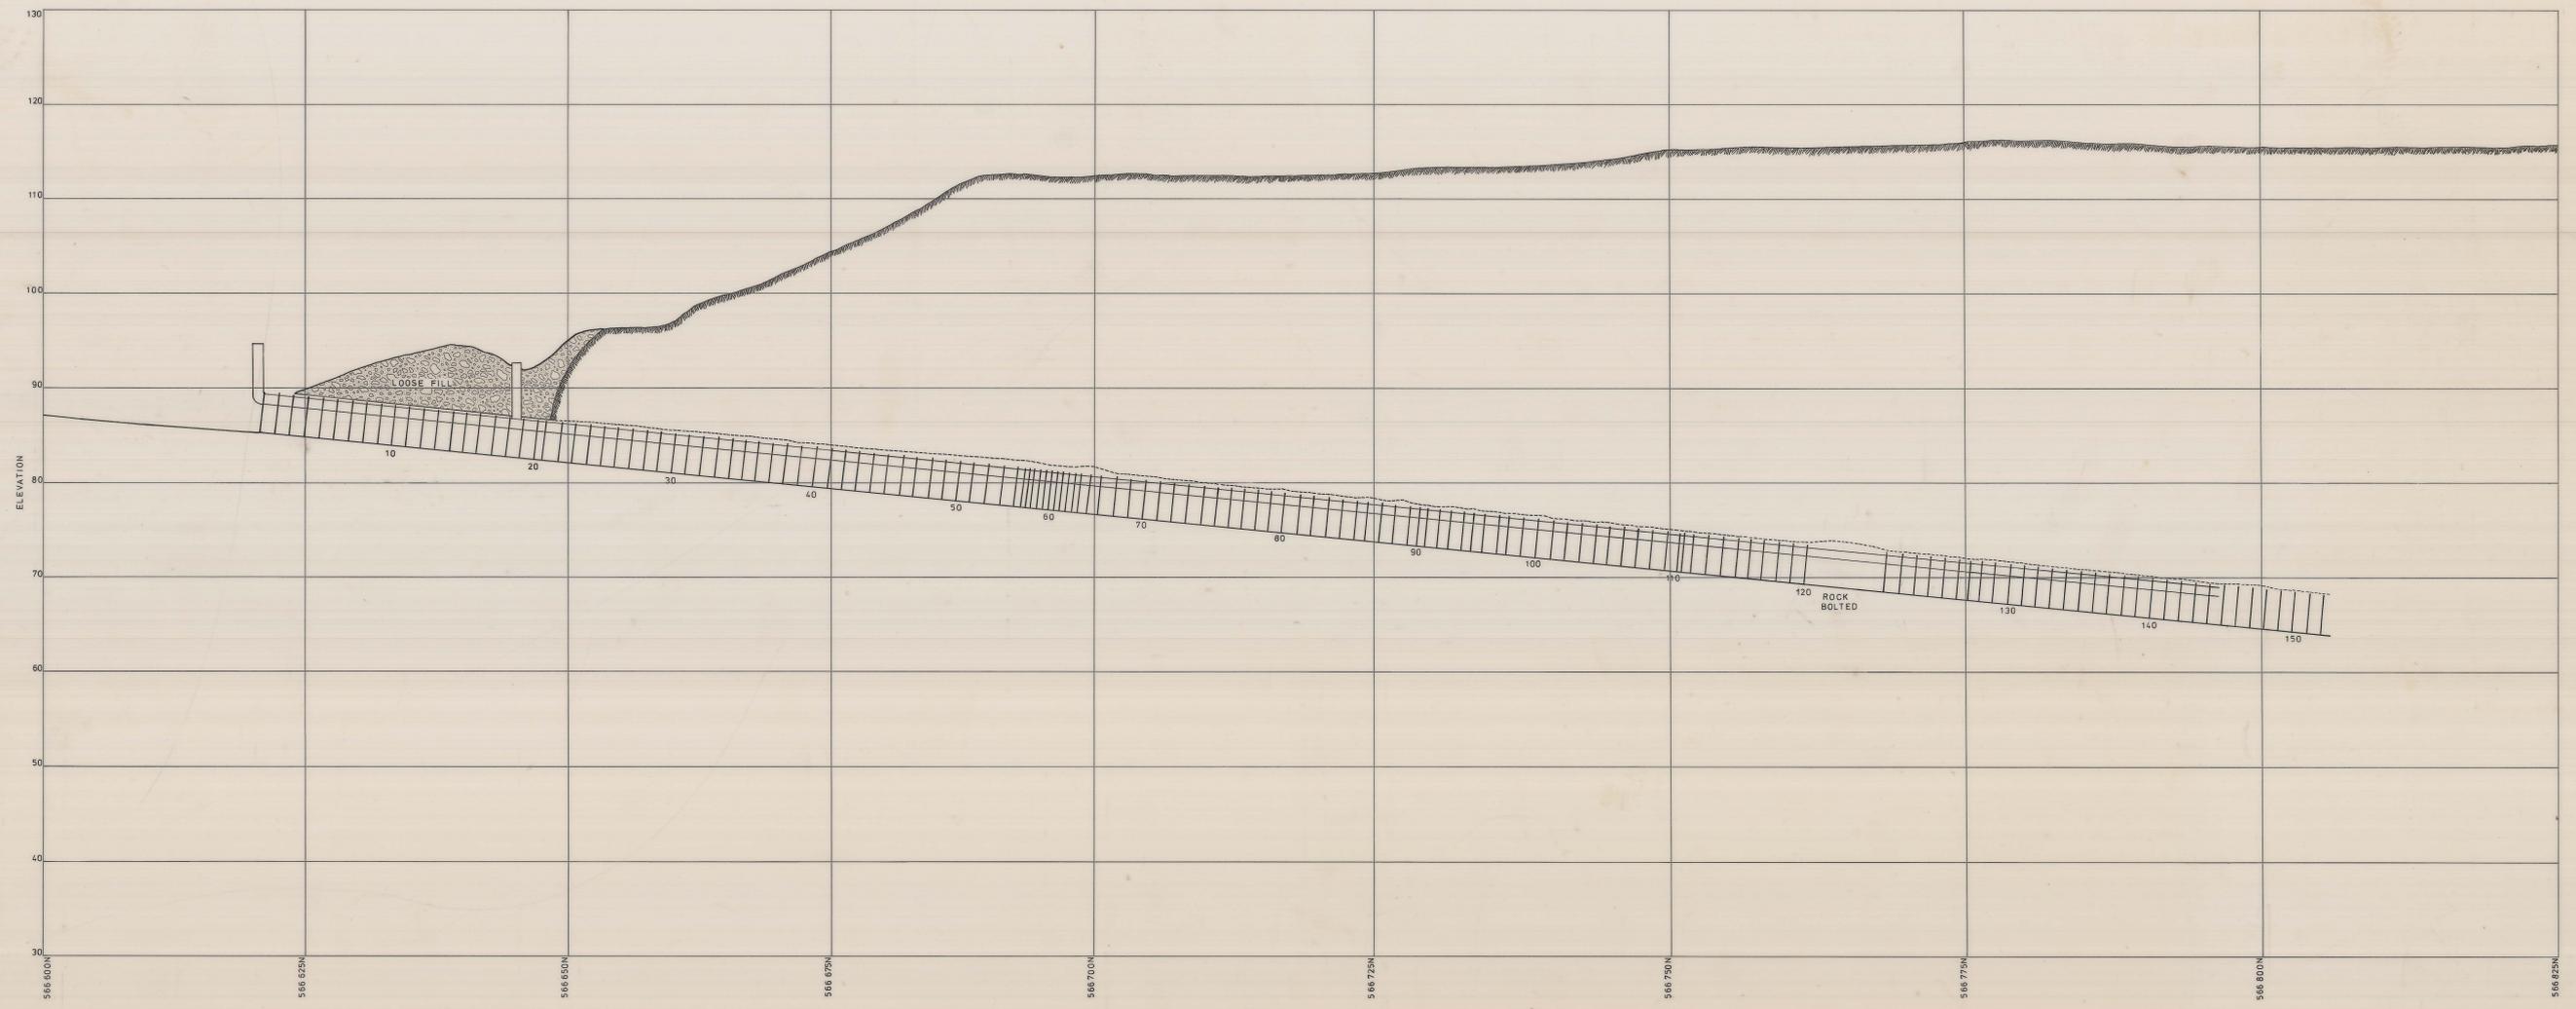

	KING ISLAND SCHEELITE LTD.	
	80020	No 1-15:21
DATE 3-6-23	SECTION ALONG Q OF DECLINE	
SURVEYED J.C.		
DRAWN J.S.		
TRACED J.S.W.		
CHECKED R.M.H.		