





- 75m ZONE PRECISE LEVELLING
6-3-77 [datum]

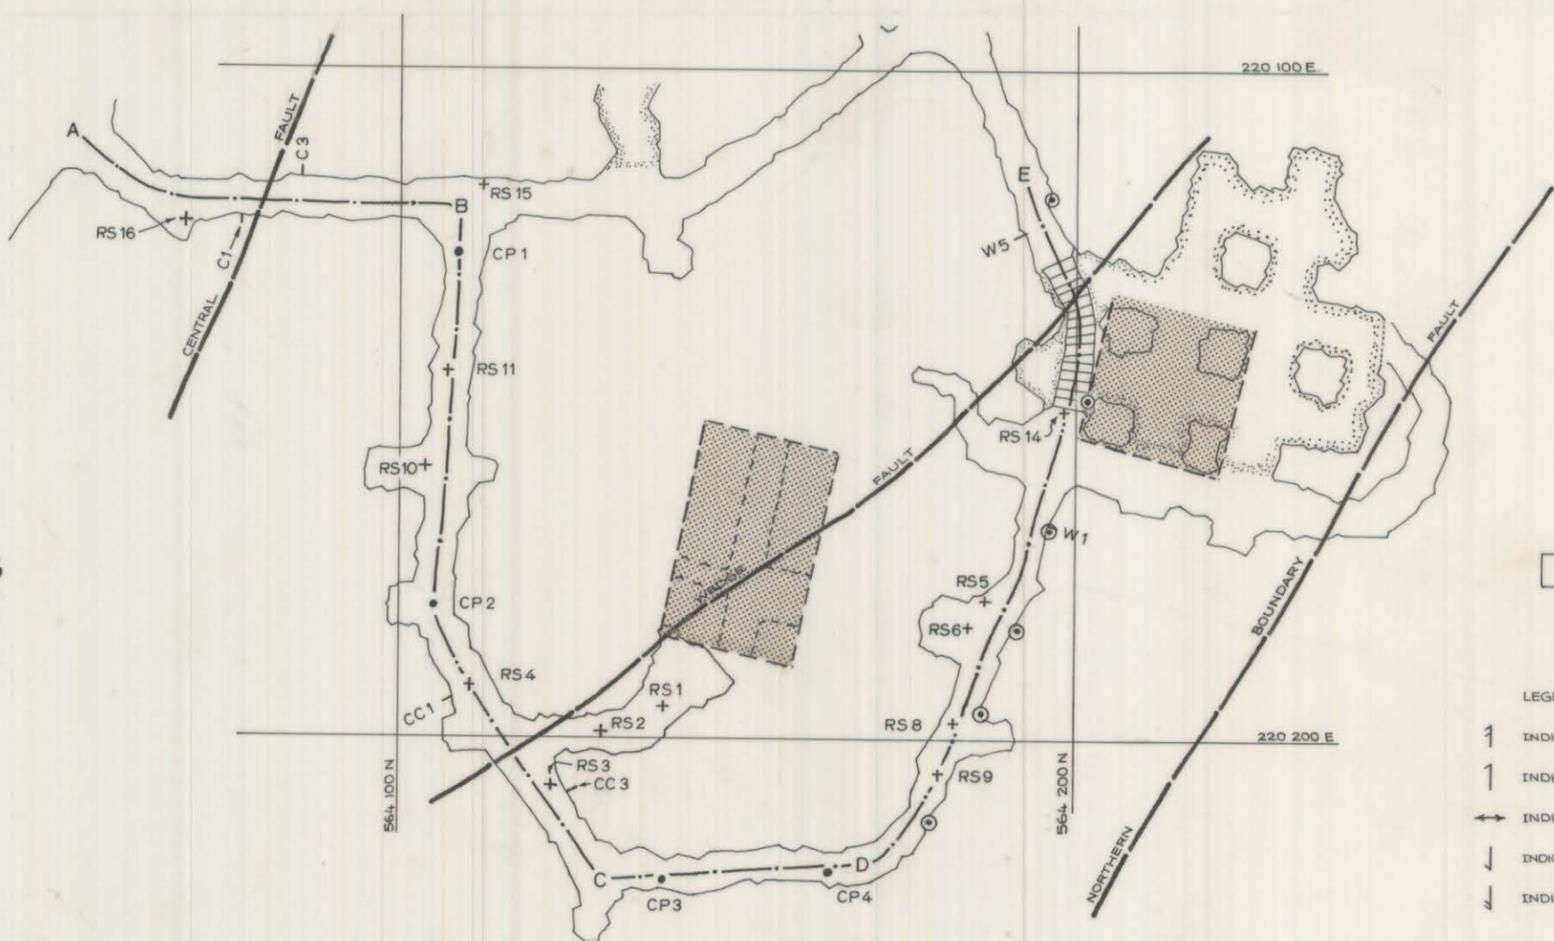

Scale 1:1000

- LEGEND
- ↑ INDICATES RISE OF 2 (OR MORE) mm.
 - ↑ INDICATES RISE OF LESS THAN 2 mm
 - ↔ INDICATES STEADY
 - ↓ INDICATES FALL OF LESS THAN 2 mm
 - ↓ INDICATES FALL OF 2 (OR MORE) mm. OVER PLOTTING PERIOD.
- N.B. RS 5 UNOBSERVABLE DUE TO DAMAGE TO ONE STATION AND A GREAT DEAL OF WATER AND SANDFILL
- ⊙ SUBSIDENCE STATION LOCATION

PROFILE OF -75m LEVEL AT
[PREVIOUS PROFILE SHOWN -----]

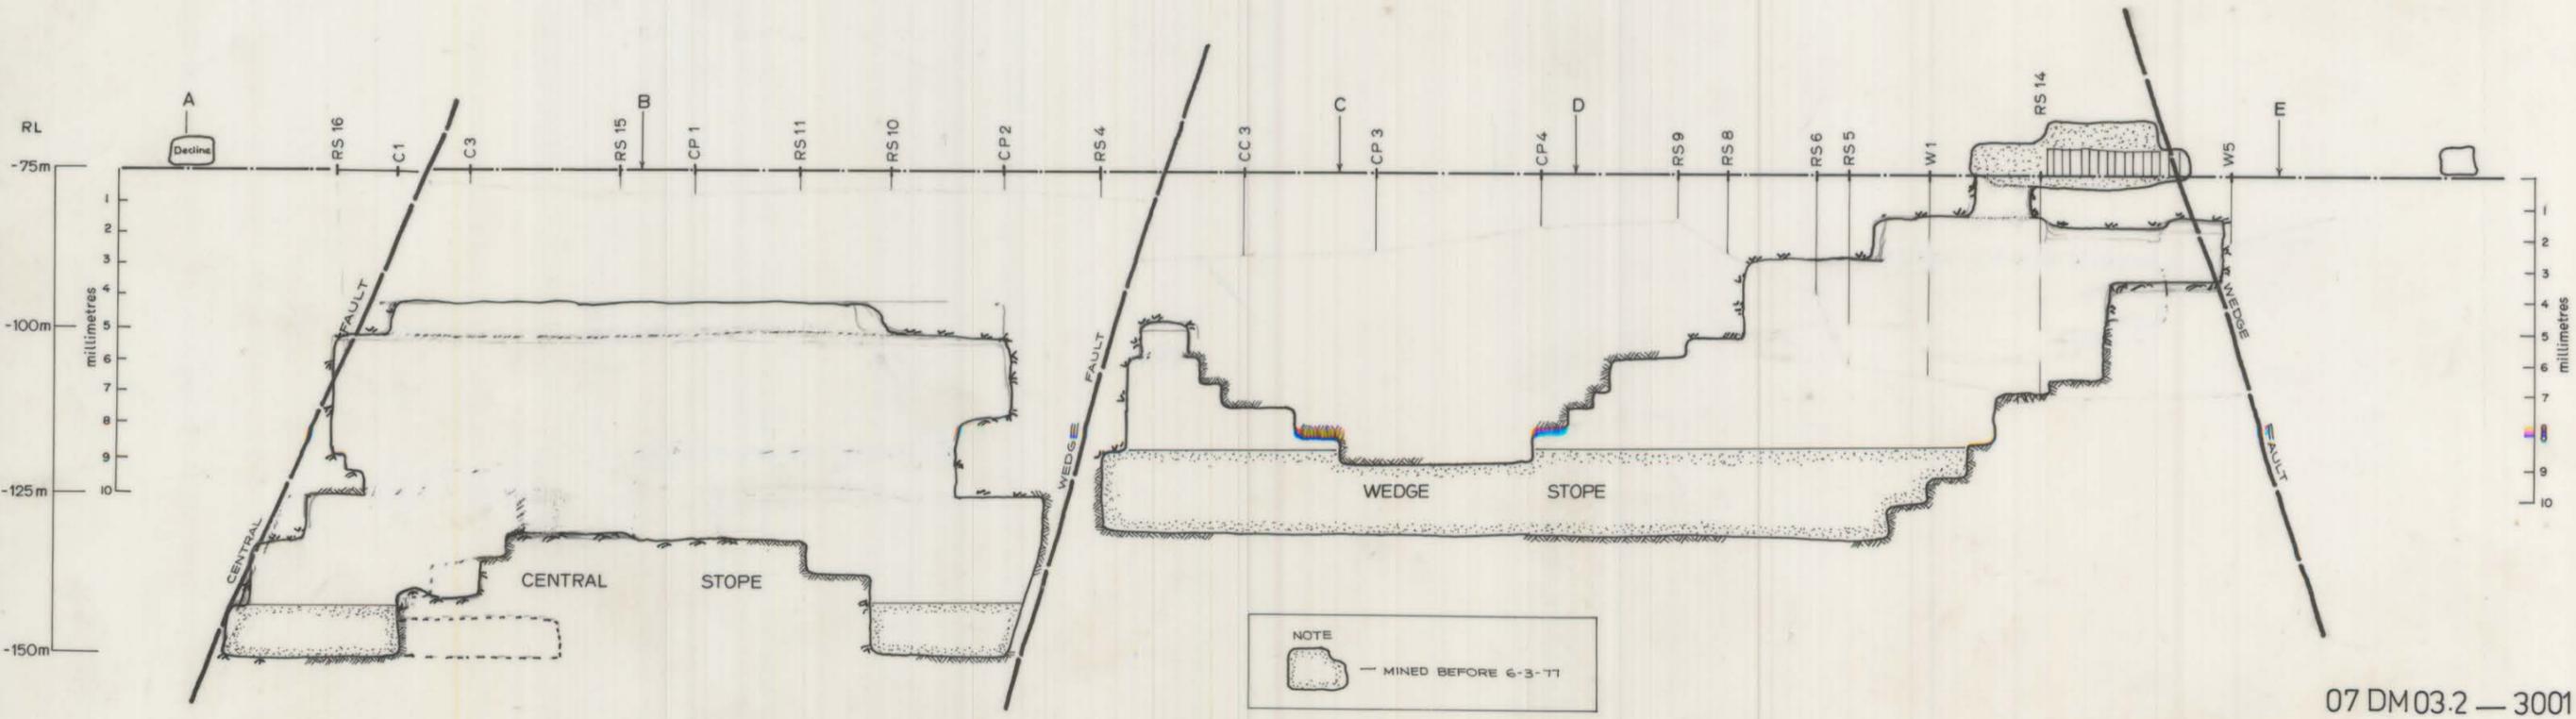

NOTE
⊙ — MINED BEFORE 6-3-77