
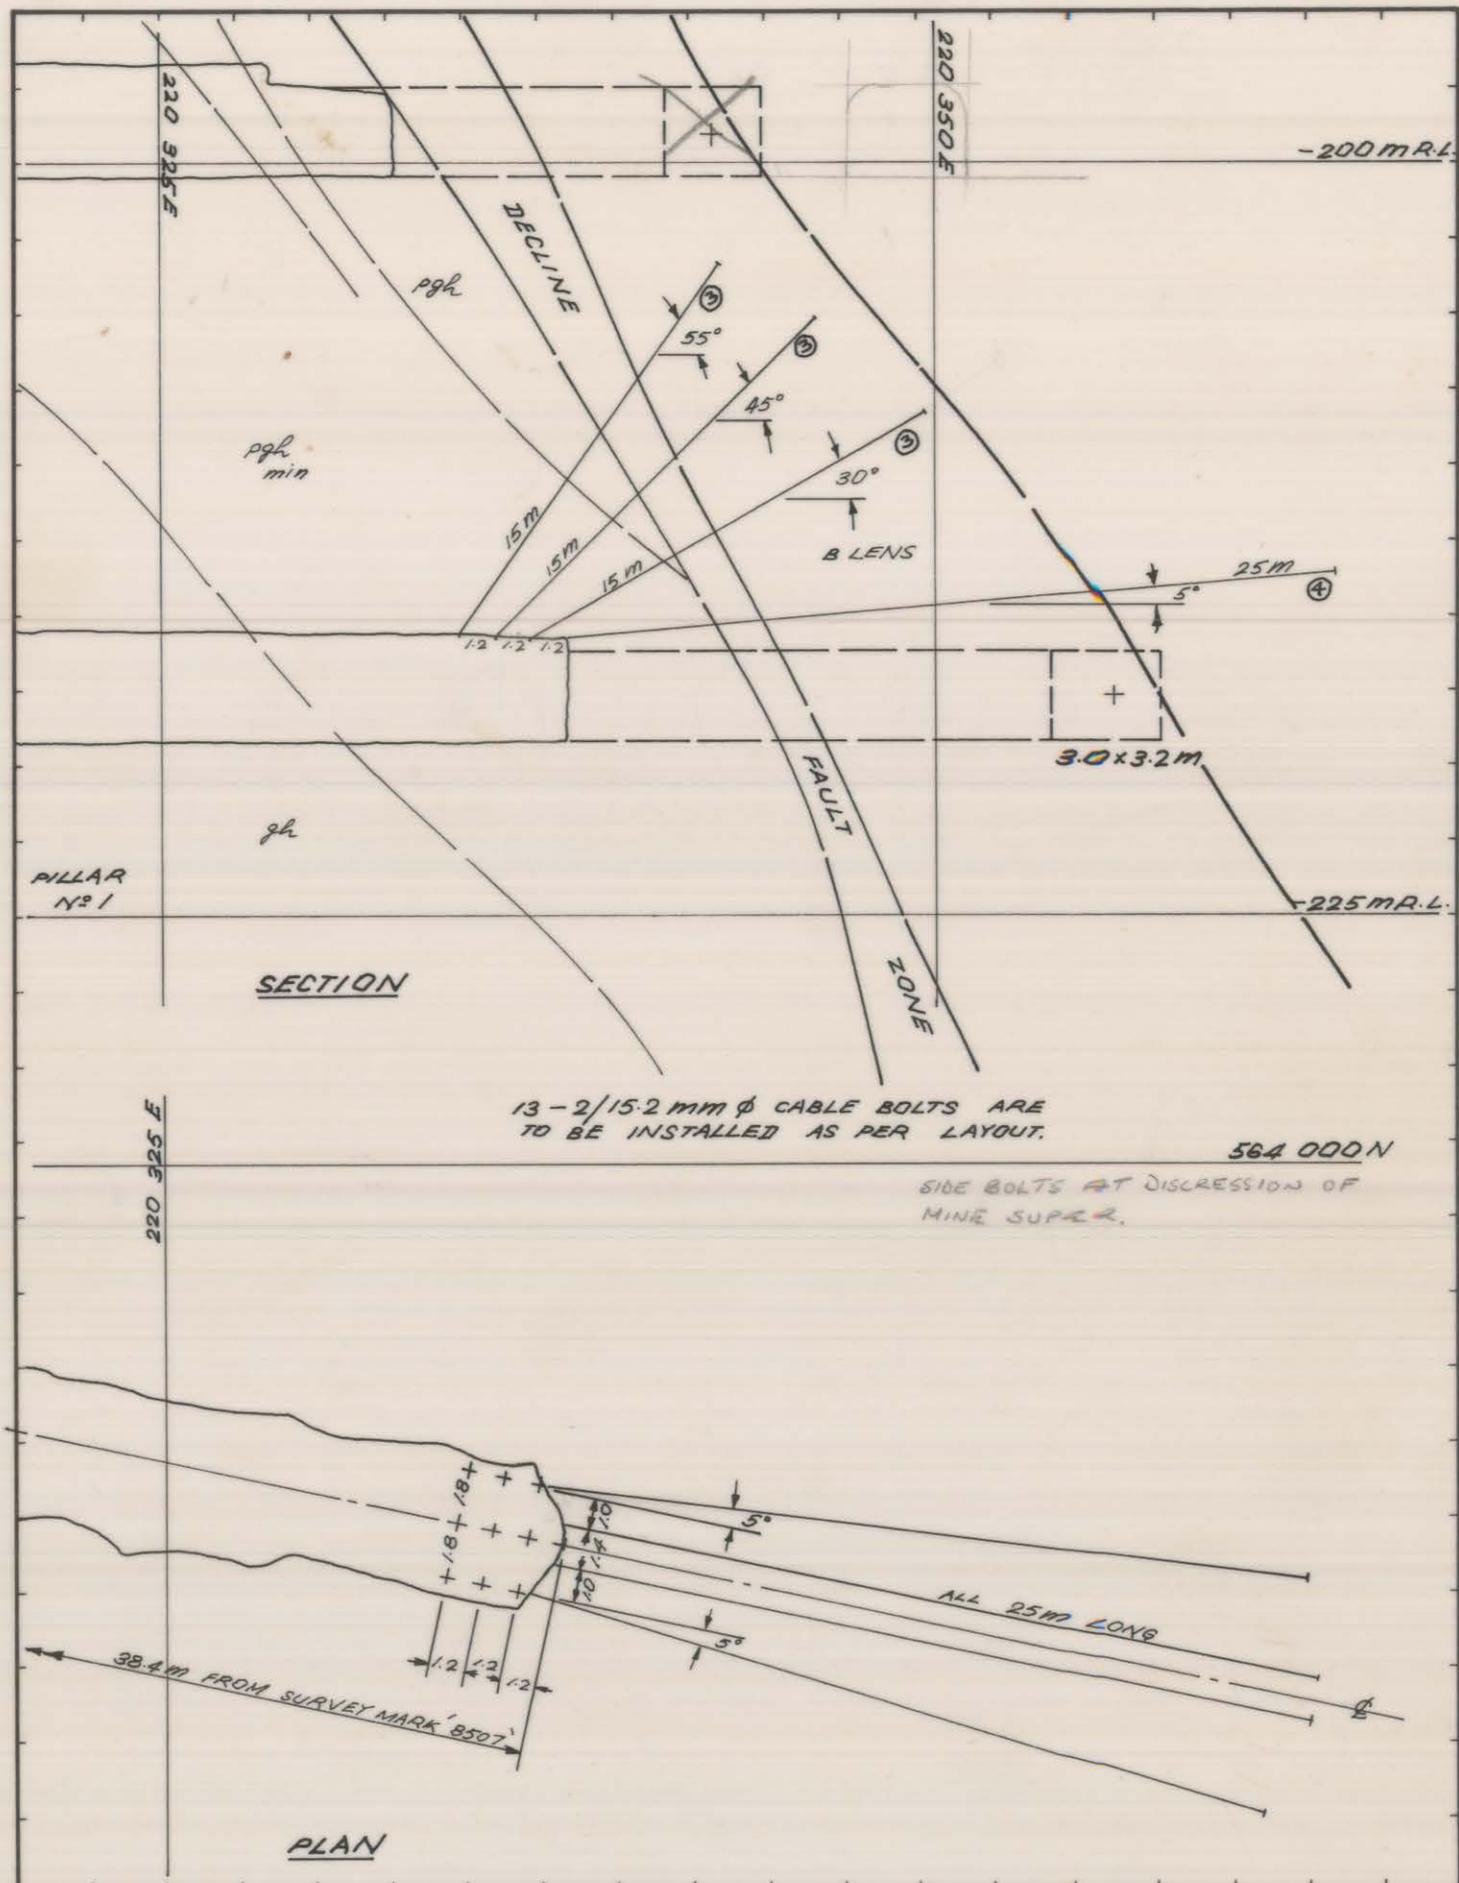


03DM19-4005

0374_2786

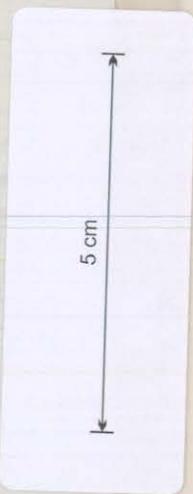

REF PLAN 	GEOLOGY	RESO	11-2-81	1: 250 SCALE	
	SURVEY	RESO	16/2/81		
	PLANNING	P.B.	10-2-81	SUPPORT SYSTEM FOR W60 STOPE AT -220 m R.L.	
	ROCK.MEC.				
	MINE SUPR.		16-2-81		
G.M.S.			DRAWING NUMBER	03DM19-4005	
T.S.S.		16/2/81			