
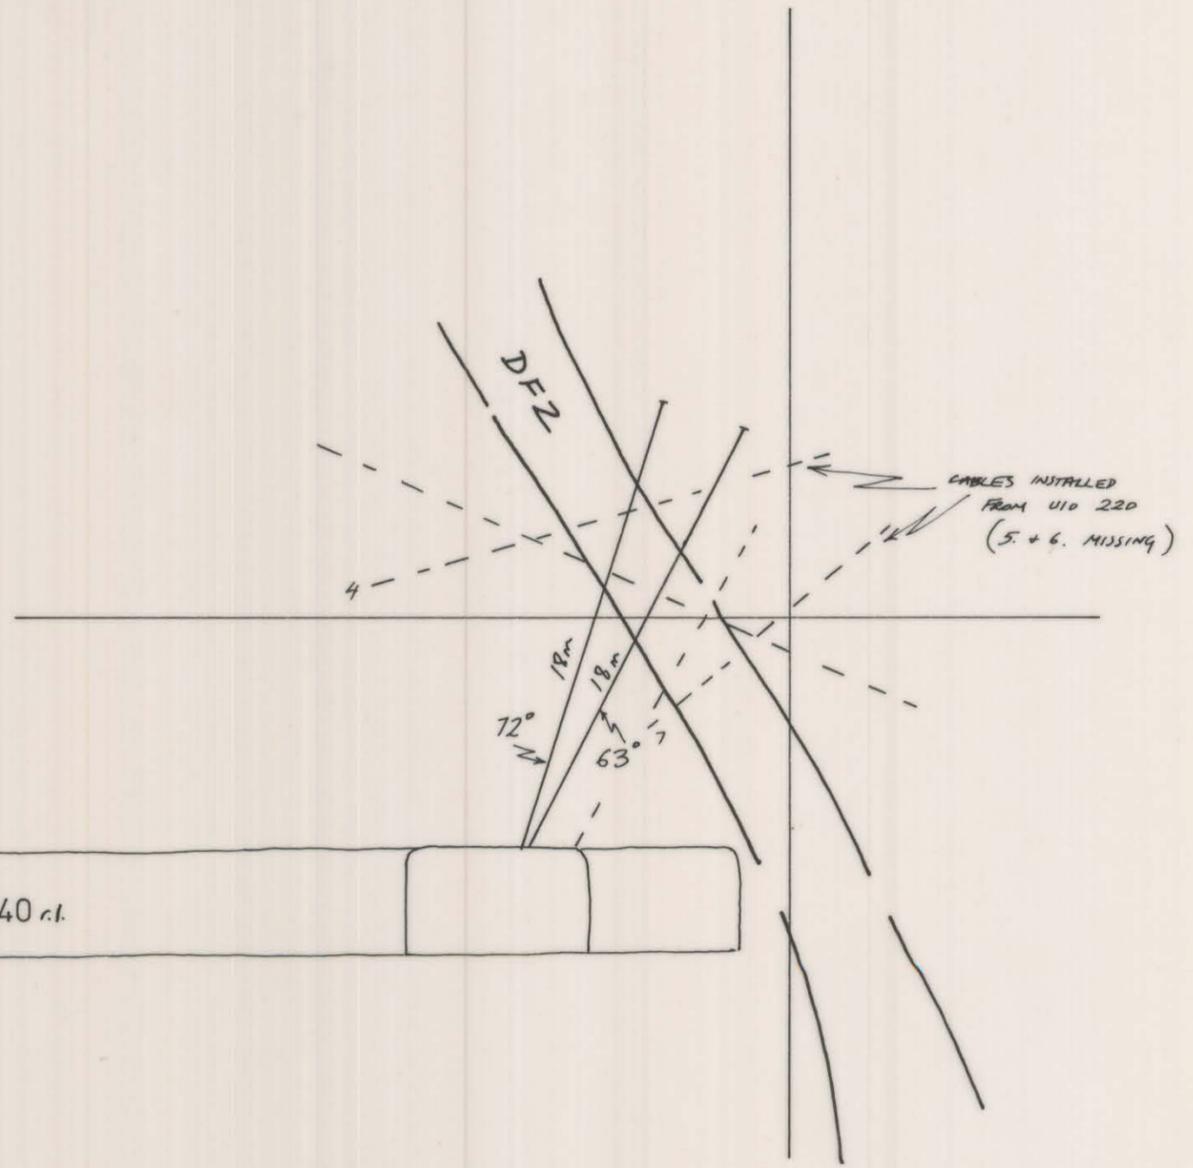
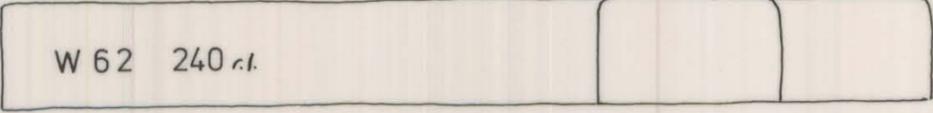


0374\_2796

07DM 09.5-3002/2

5 cm

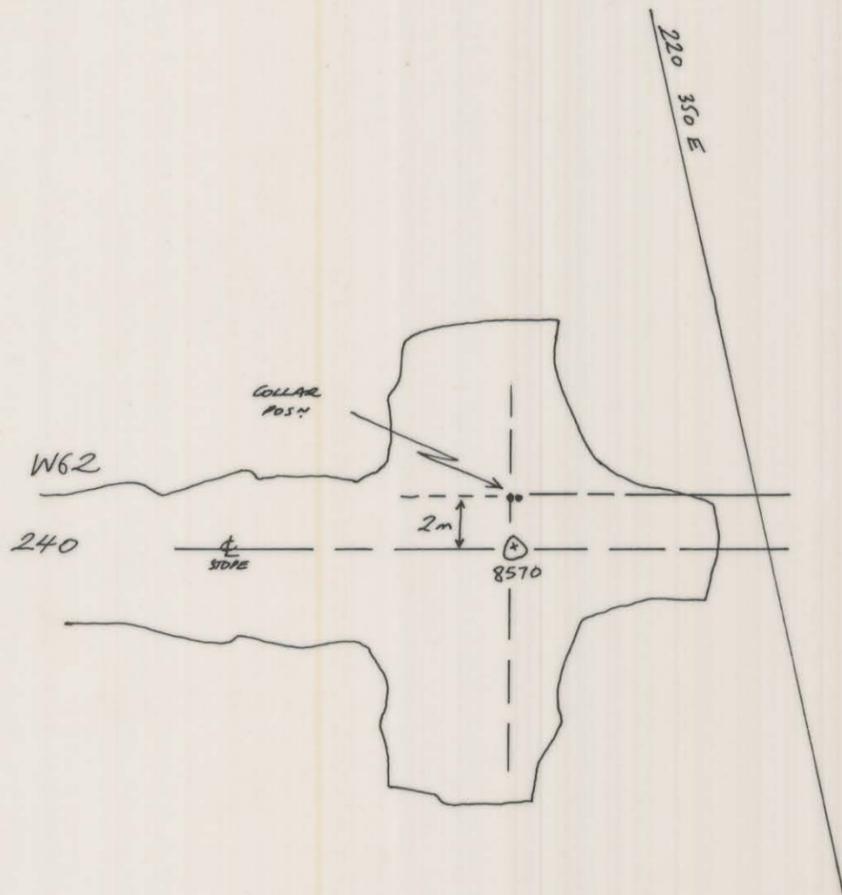

REF PLAN 04 DM 12 146 - 148

GEOLOGY

SURVEY

PLANNING

ROCK MEC.

GRADE CON.

DRAFTING

T.S.S.

SCALE 1: 250

KIS KING ISLAND SCHEELITE GRASSY KING ISLAND

AR 4<sup>th</sup> MAR 82

2/12 23.3.82

TWO EXTRA CABLES FROM 240 TO COMPENSATE FOR CABLES C5 + C6 MISSING ON 220 H/W

DRAWING NUMBER

07DM 09.5-3002/2