


5 cm

0374_2803

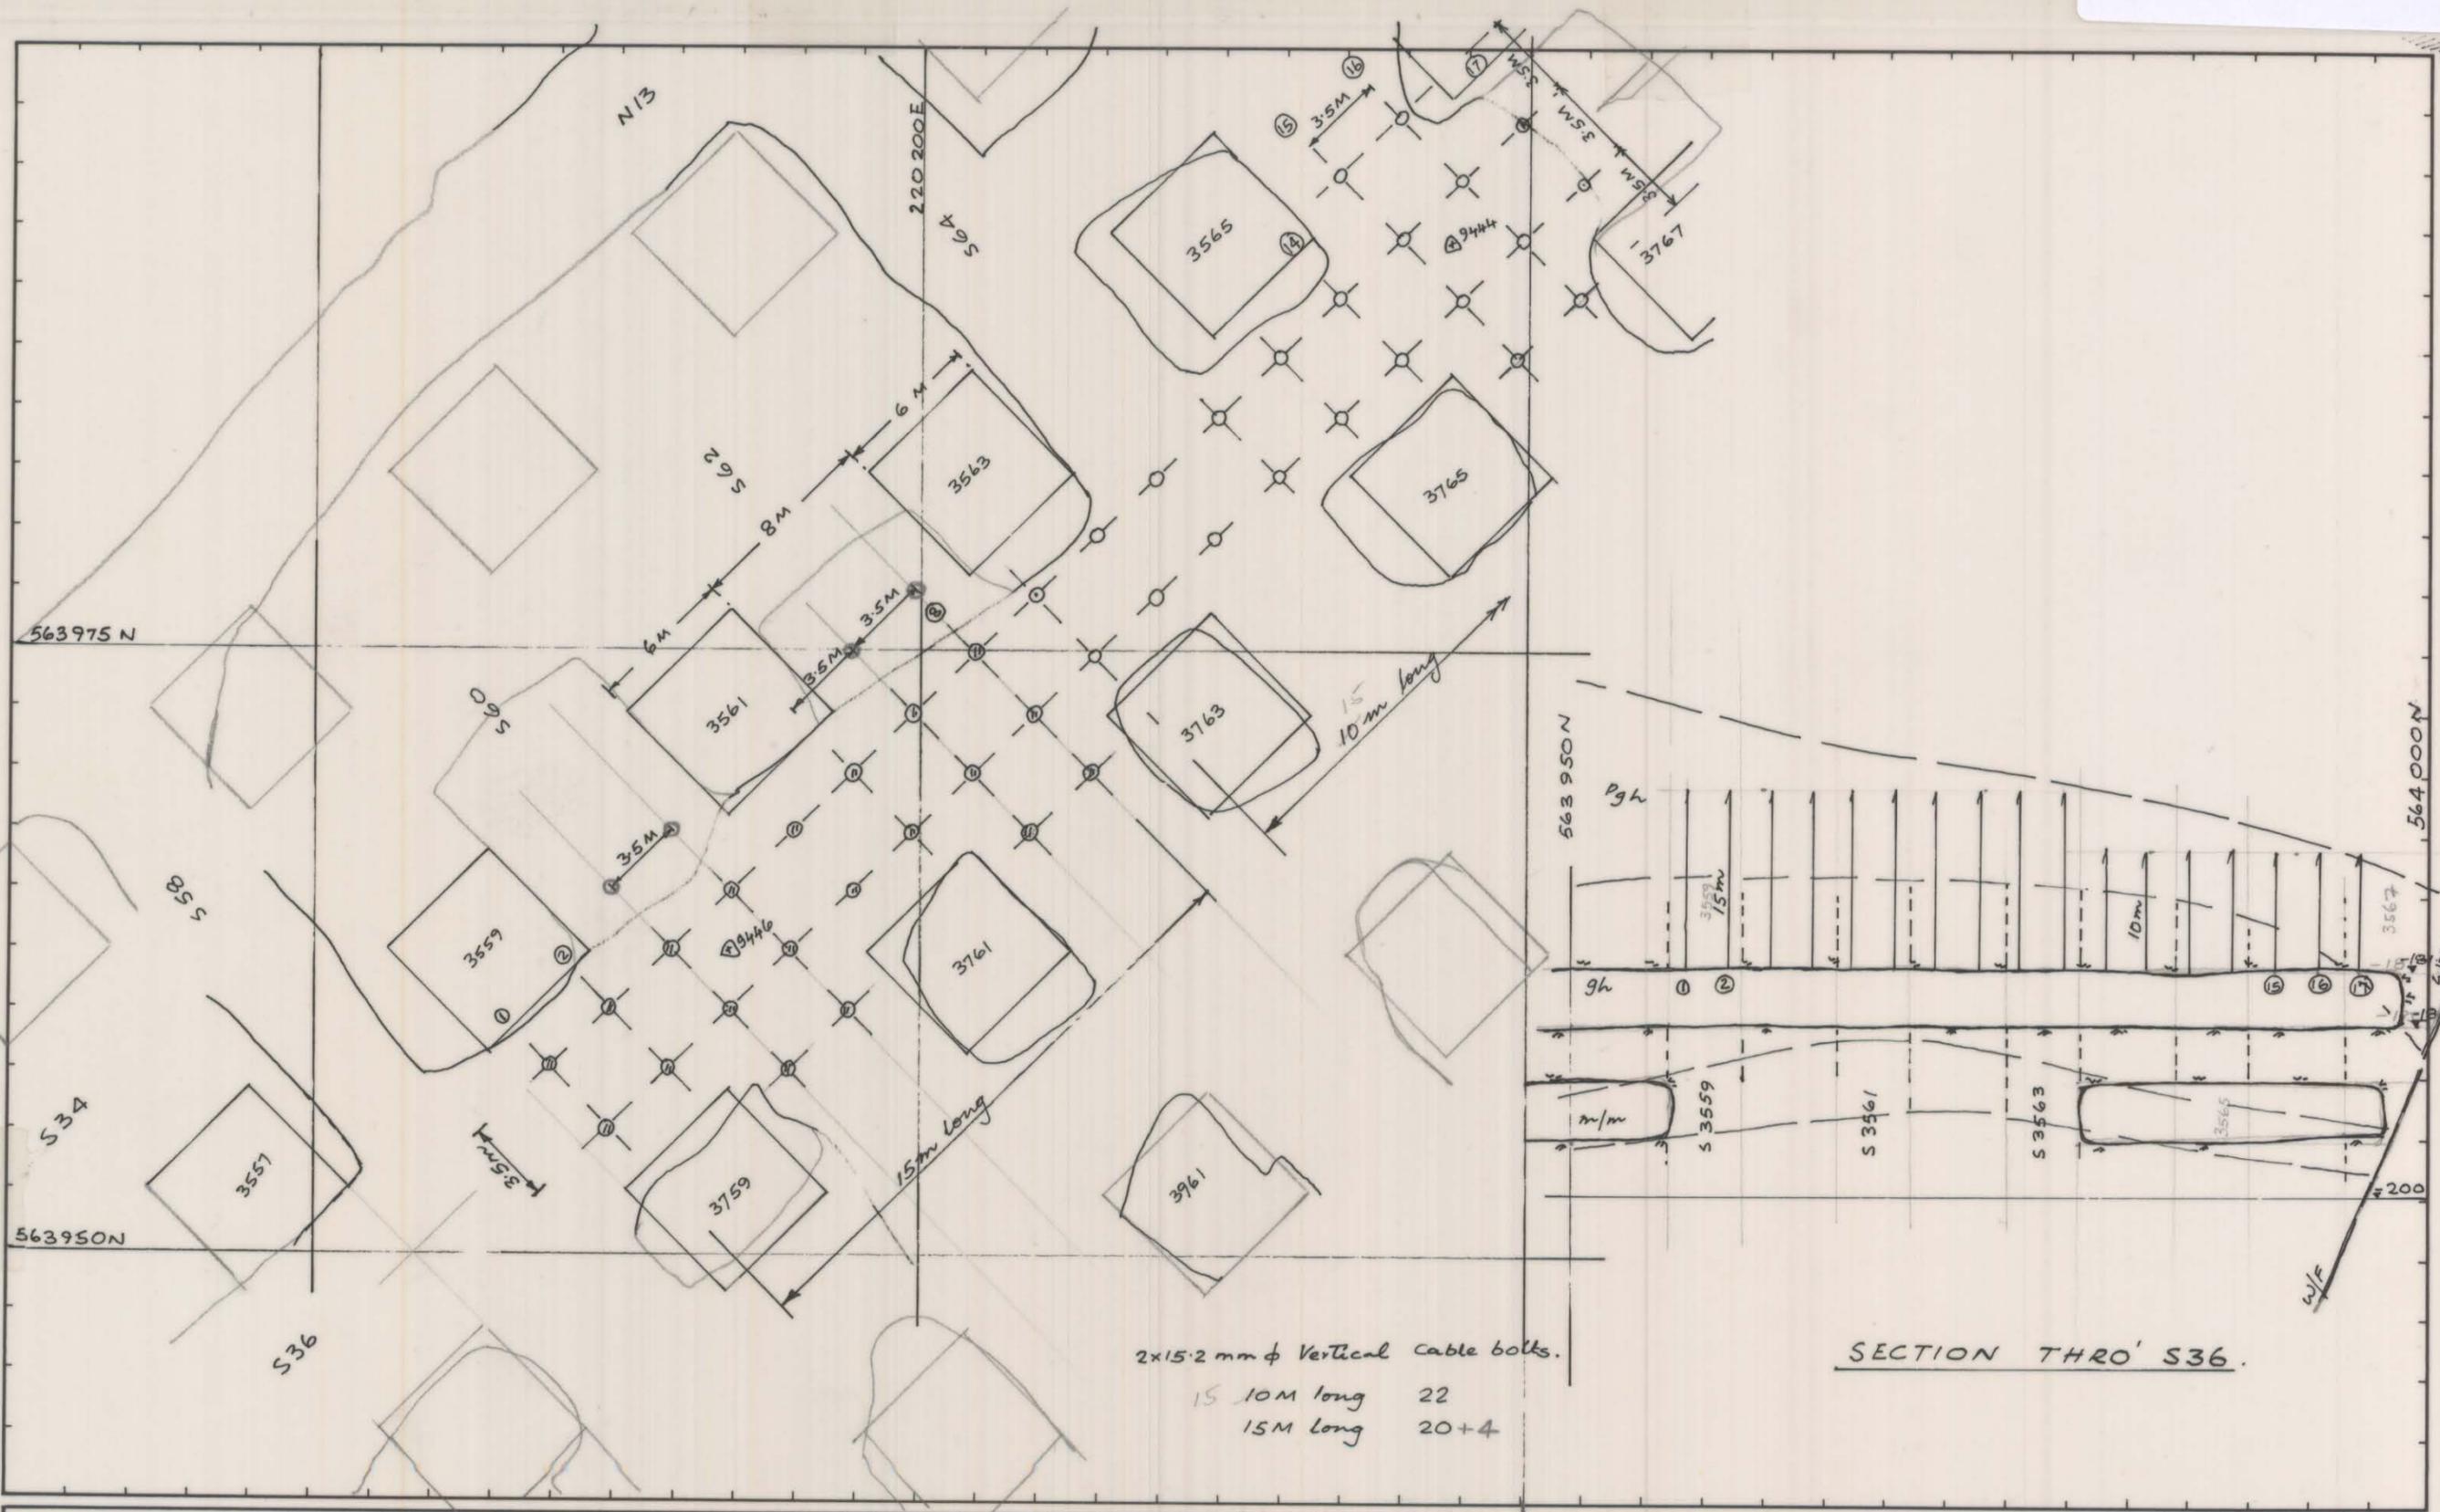

2x15.2 mm ϕ Vertical Cable bolts.
 15 10M long 22
 15M long 20+4

SECTION THRO' S36.

REF PLAN	GEOLOGY		SCALE 1: 250/500	
	SURVEY			
	PLANNING		SUPPORT SYSTEM // LIFT LOWER PIT SLOPE DOLPHIN MINE	
	ROCK MEC.	<i>dlc</i> Dec 1984		
	GRADE CON.		DRAWING NUMBER	
	DRAFTING			
	T.S.S.		07 DM09.5 - 3012	