


27 JUN 1981

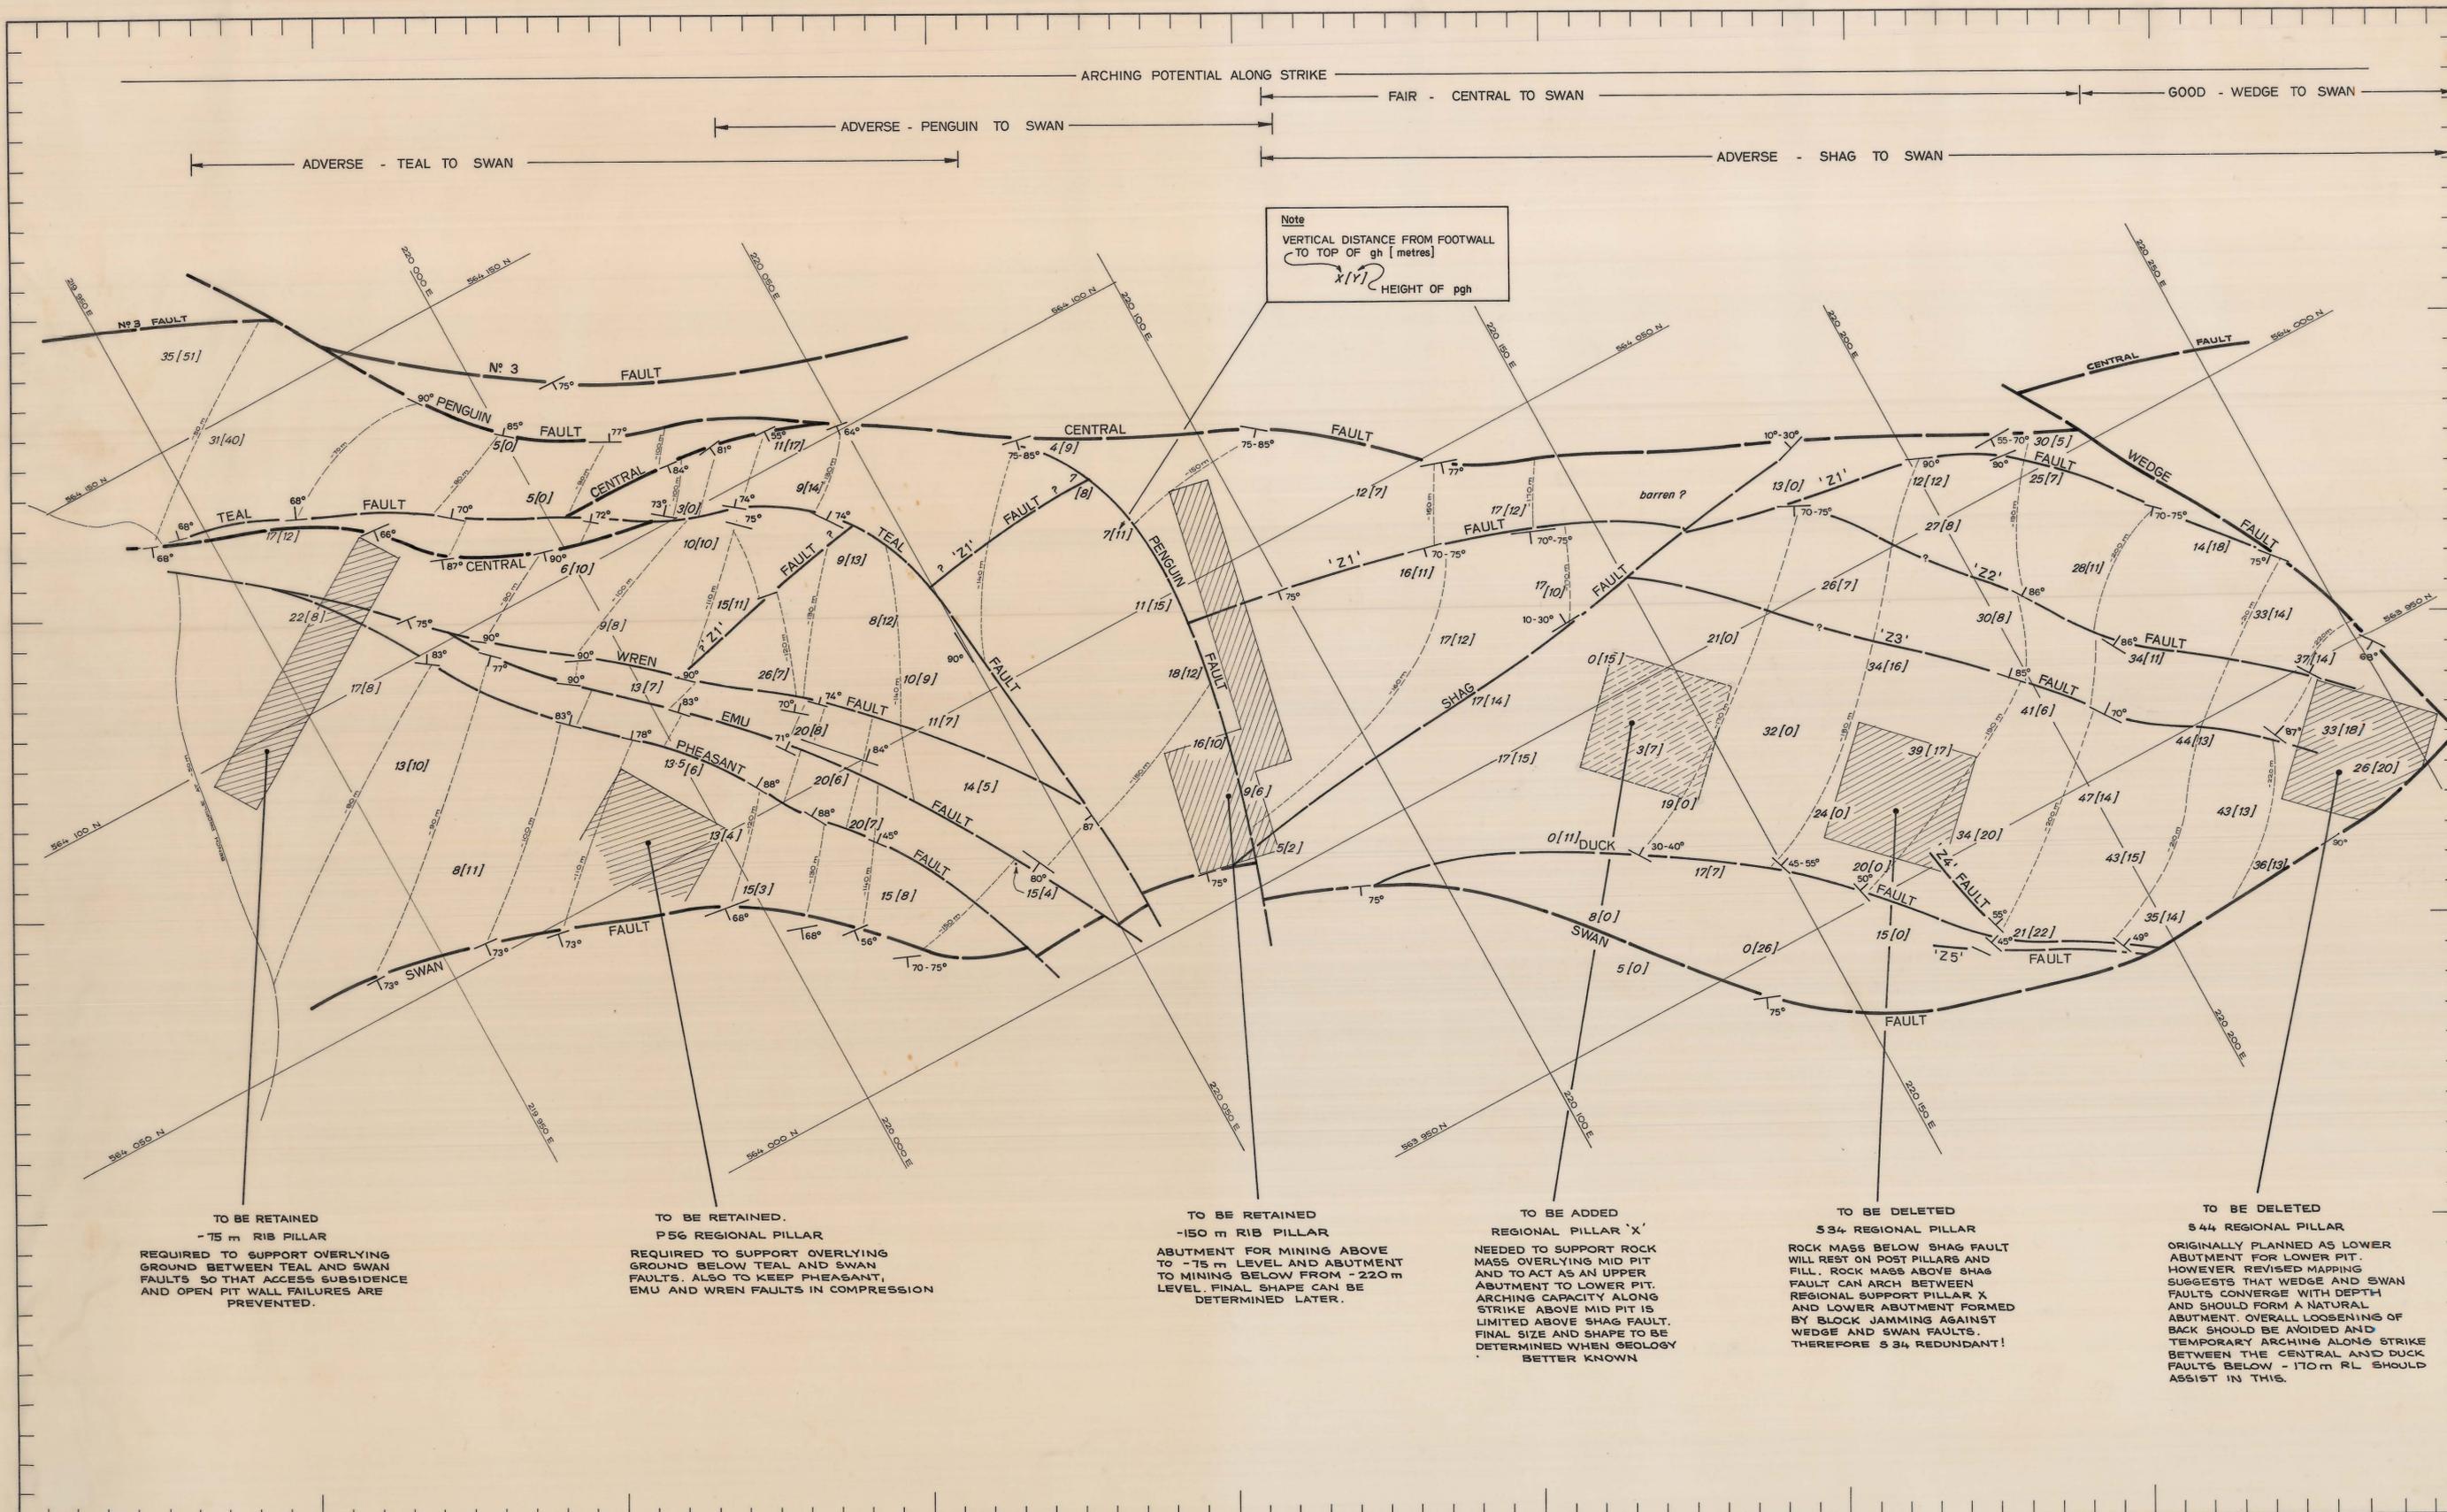

REVISIONS		APPROVAL		INITIALS	DATE
NO	DATE	PLANNING ENGINEER	INITIALS	DATE	
		SNR. PLANNING ENGINEER			
		TECHNICAL SERVICES SUPT.			
		GENERAL MINING SUPT.			
		MINE SUPT.			
		SNR. SURVEYOR			
		SNR. GEOLOGIST			
		SNR. ROCK MECHANICS ENGINEER			

SCALE 1:500

LOCATION DOLPHIN MINE

SUBJECT  
PIT STOPE  
Horizontal projection of intersection of major structural features with Marble Marker

**KIS** KING ISLAND SCHEELITE  
A Member of the Paleo Metallurgical Group

GRASSY KING ISLAND

PRELIMINARY  FINAL

PLAN NUMBER

07 DM 09.2 - 1001